
#4808 PLAT OF SURVEY

OF

TELEPHONE LINE LOCATION FOR "THE ABBEY", FONTANA-ON-GENEVA LAKE, WISCONSIN.

Lloyd L Jensen
CO. SURVEYOR

OCT. 1962

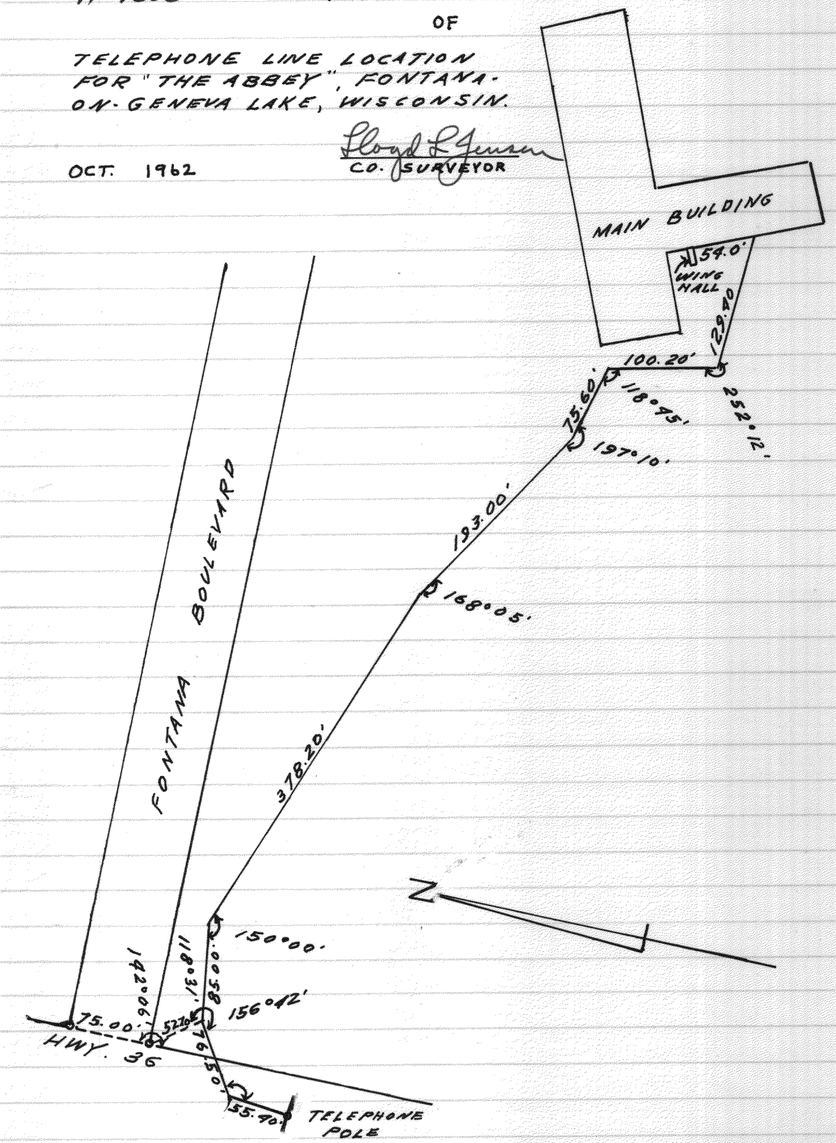

#4809 PLAT OF SURVEY

LOT 13 - LYNNDALE SUBDIVISION, LOCATED IN THE NW 1/4 OF SECTION 20, T4N. R18E, VILLAGE OF EAST TROY, WALWORTH COUNTY, WISCONSIN.

Lloyd L Jensen
CO. SURVEYOR

MAY 1965

