
#2966

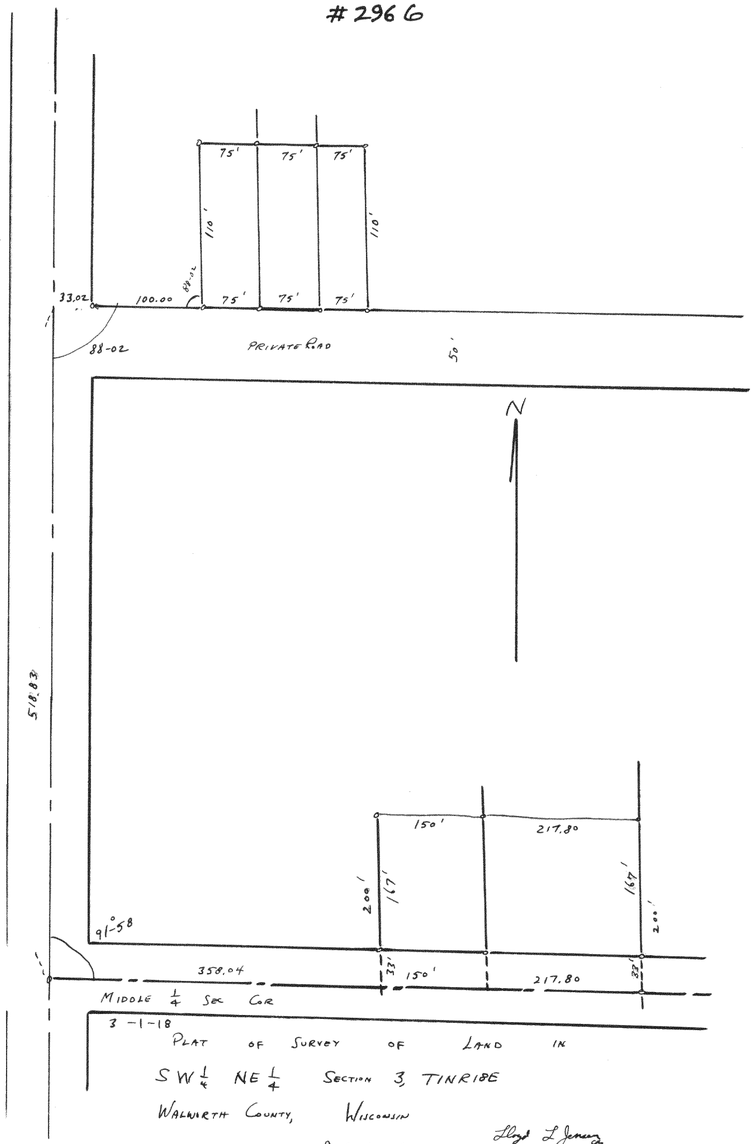

PLAT OF SURVEY OF LAND IN


SW 1/4 NE 1/4 SECTION 3 T1NR18E

WALWORTH COUNTY, WISCONSIN

July 1954

Lloyd L Jones
County Surveyor

#2967

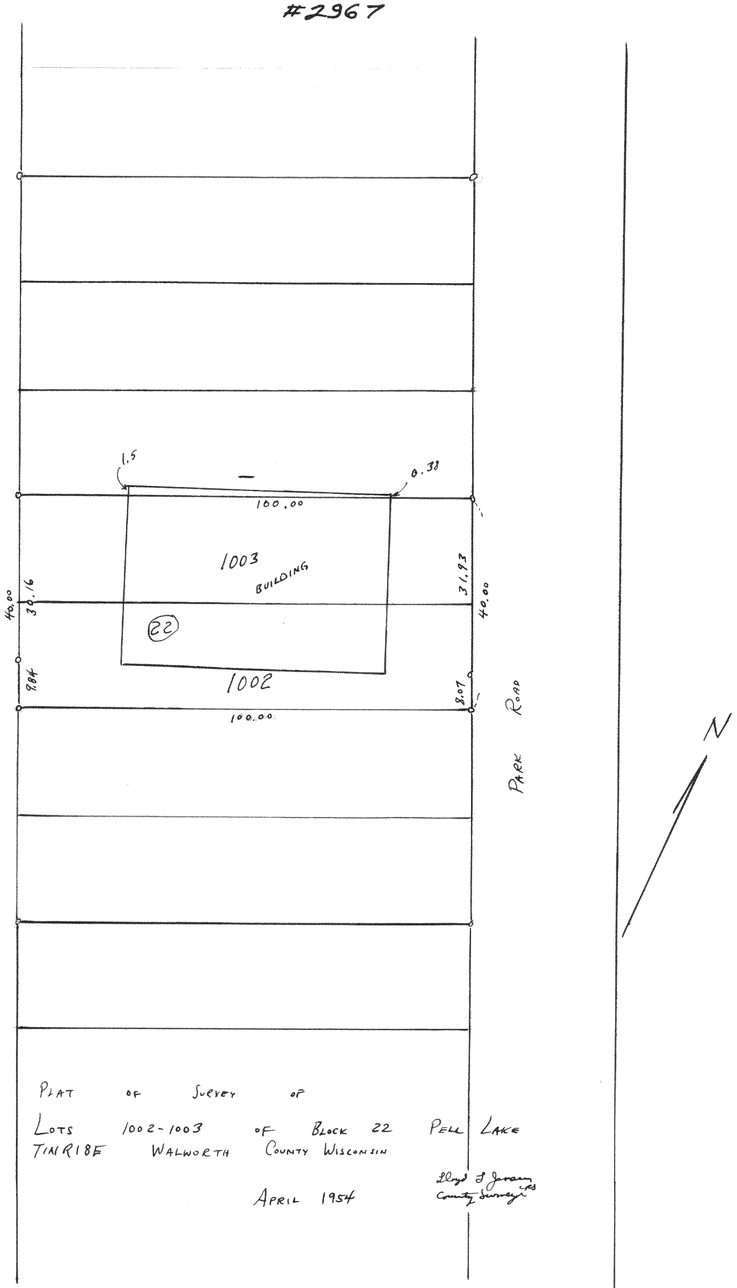

PLAT OF SURVEY OF

LOTS 1002-1003 OF BLOCK 22 PELL LAKE
T1NR18E WALWORTH COUNTY WISCONSIN

APRIL 1954

Lloyd L Jones PLS
County Surveyor