

#2968

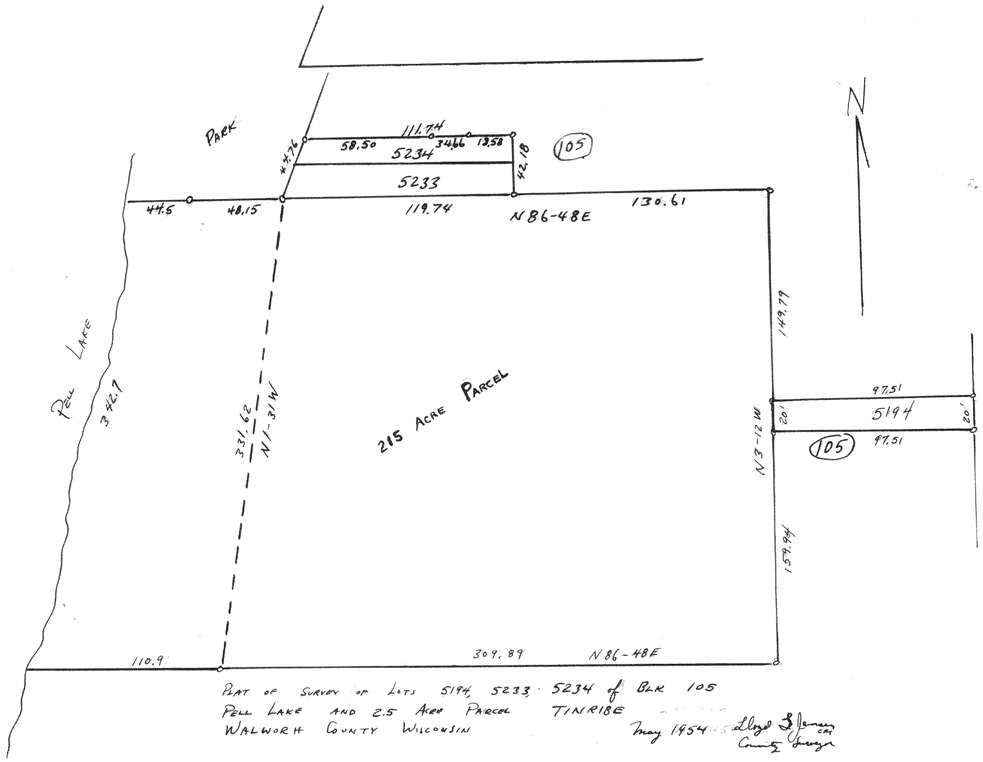


Plat of Survey of Lots 5194, 5233, 5234 of Blk 105
Pell Lake and 2.5 Acre Parcel Tinribe
Walworth County Wisconsin
May 1954 Lloyd L Jensen CSS County Surveyor

#2969

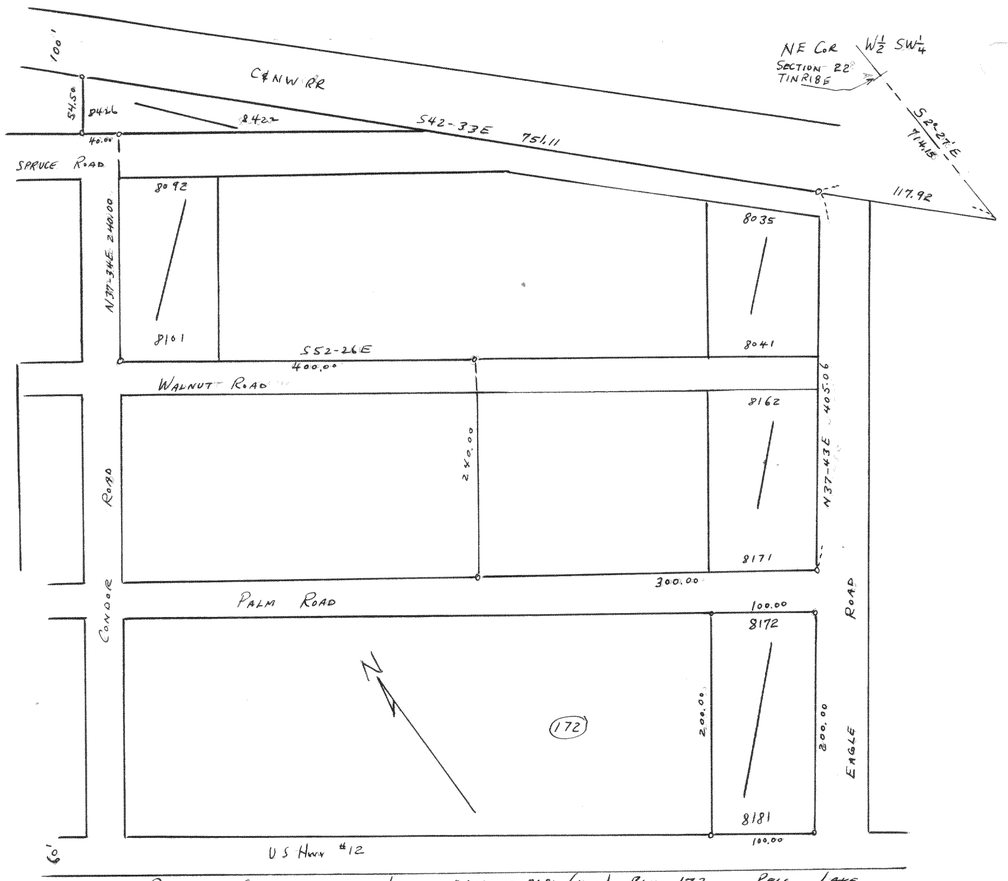


Plat of Survey of Lots 8172 - 8181 (incl) Blk 172 Pell Lake
and Parcel in W½ SW¼ Sec 22 Tinribe Walworth County Wisconsin
November 1954 Lloyd L Jensen CSS County Surveyor

#2970

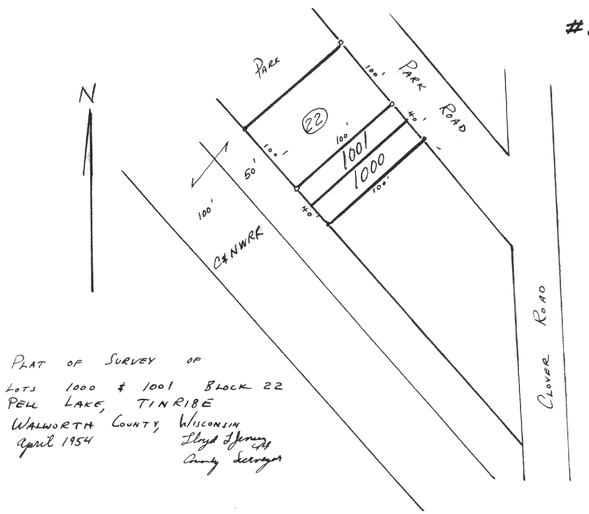

Plat of Survey of
Lots 1000 & 1001 Block 22
Pell Lake, Tinribe
Walworth County, Wisconsin
April 1954 Lloyd L Jensen CSS County Surveyor

#2971

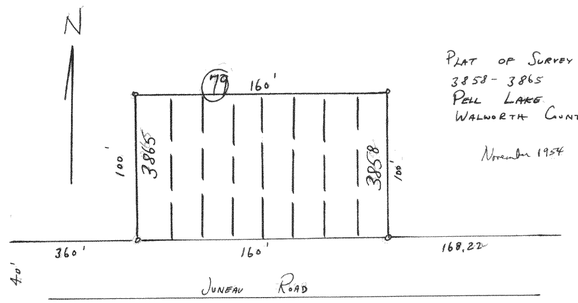

Plat of Survey of Lots
3858 - 3865 Block 79
Pell Lake Tinribe
Walworth County, Wisconsin
November 1954 Lloyd L Jensen
County Surveyor