
PLAT OF SURVEY OF
THE REEK SCHOOL IN THE
NW¼ SECTION 16, T1N R17E
WALWORTH COUNTY, WIS.

#4828 MAY 1966

Lloyd L. Jensen
LLOYD L. JENSEN
CO. SURVEYOR

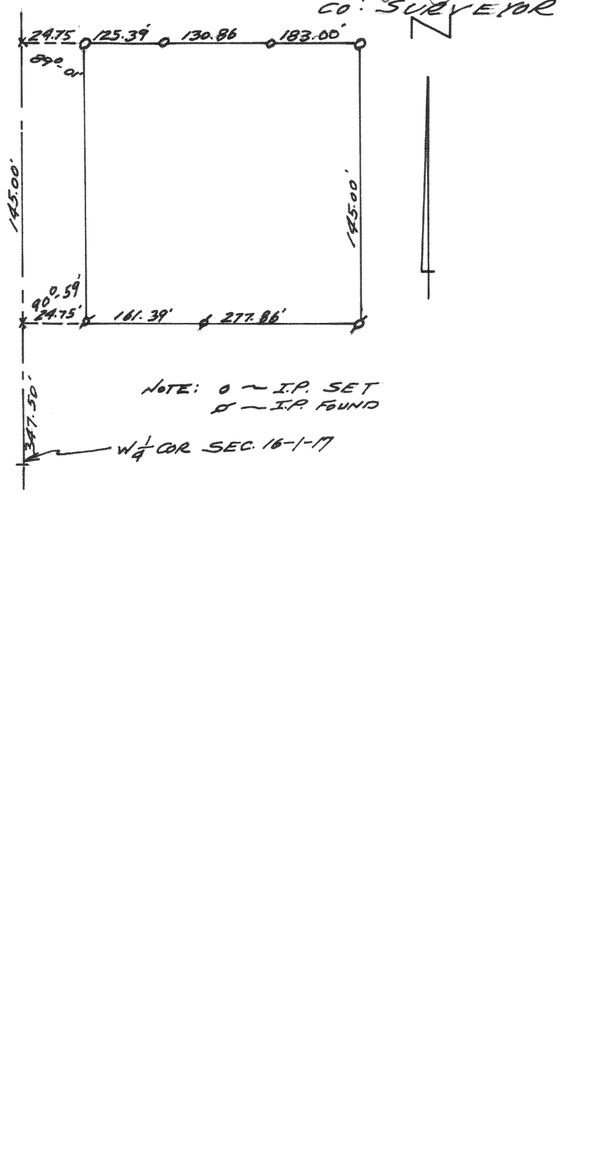

PLAT OF SURVEY
OF
LOTS 3 & 4 BLOCK 18, ORIGINAL PLAT, CITY OF ELKHORN, WALWORTH COUNTY, WISCONSIN.

#4829 FEB. 1968

Floyd S. Jensen
COUNTY SURVEYOR

