
#4843

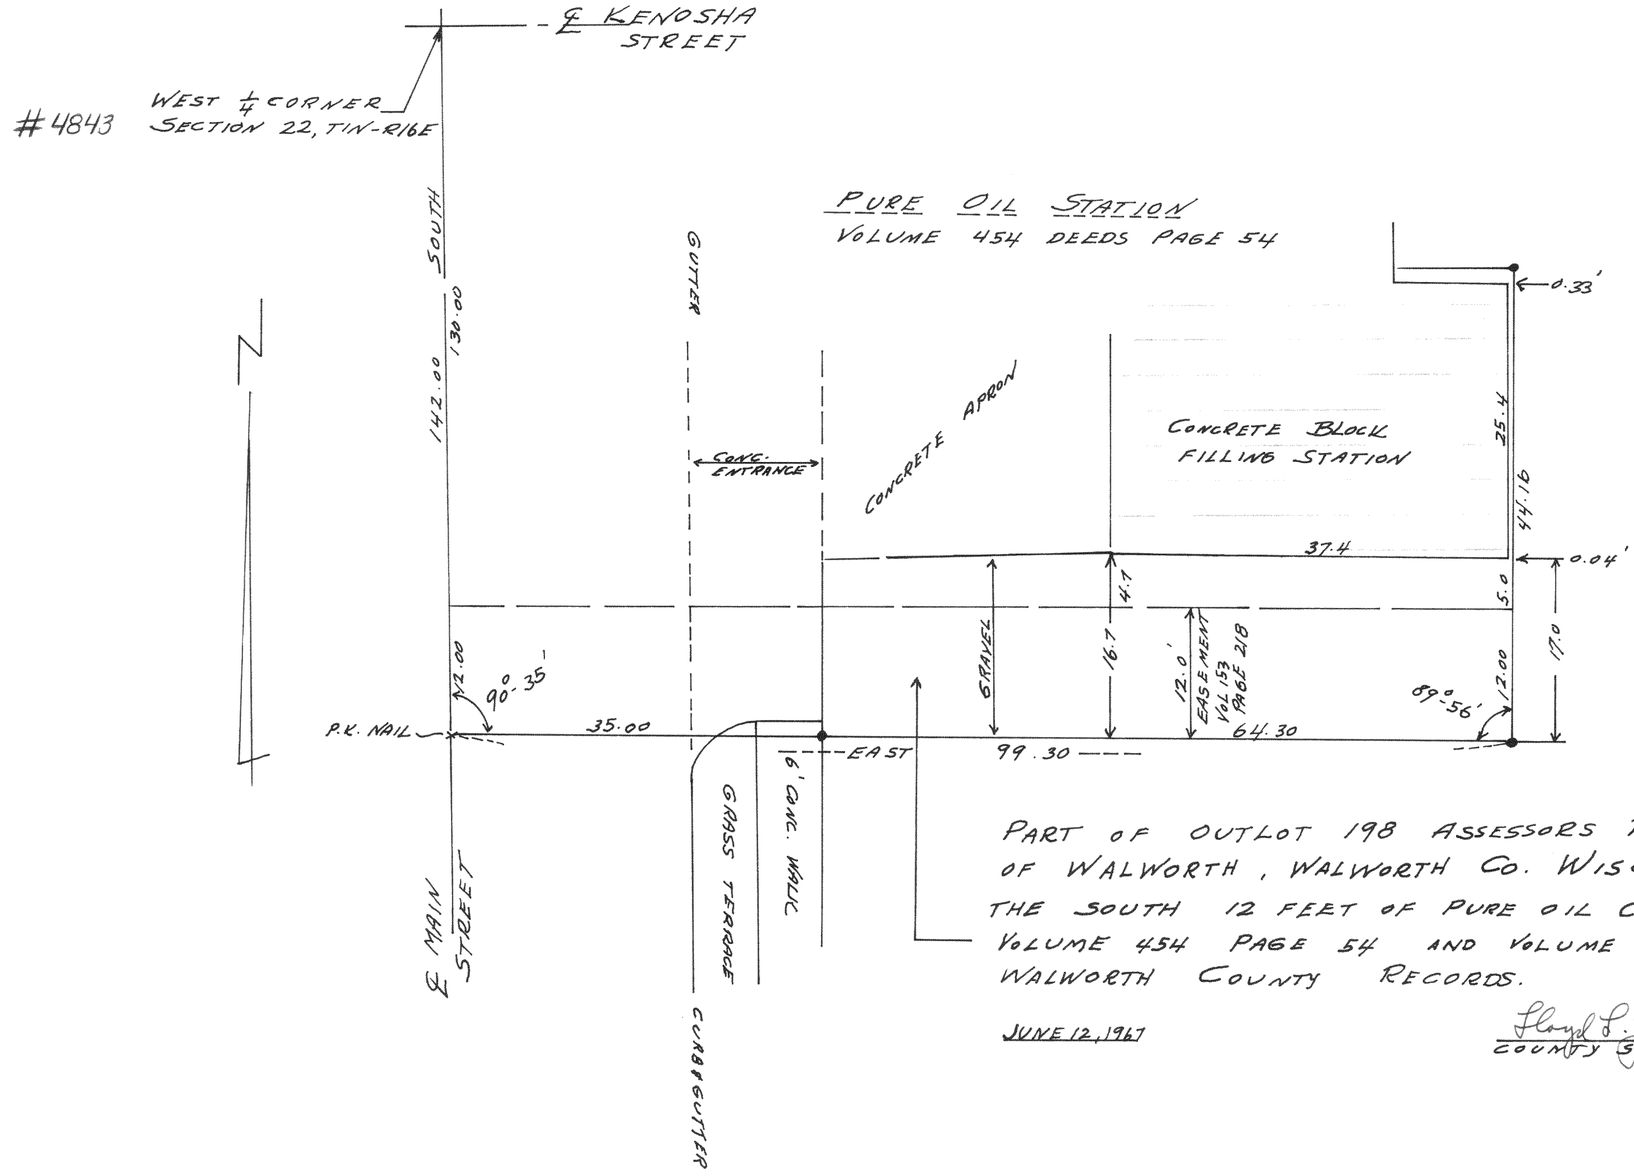

PART OF OUTLOT 198 ASSESSORS PLAT, VILLAGE OF WALWORTH, WALWORTH CO. WISCONSIN.
THE SOUTH 12 FEET OF PURE OIL COMPANY - VOLUME 454 PAGE 54 AND VOLUME 153 PAGE 218 WALWORTH COUNTY RECORDS.

JUNE 12, 1967

Floyd L. Jensen
COUNTY SURVEYOR