
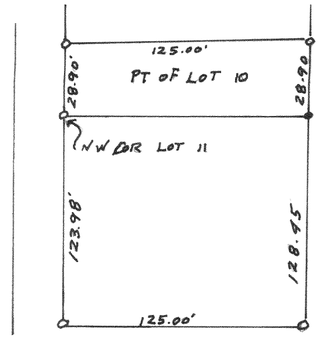


#4850

PLAT OF SURVEY
OF
Part of LOT 10 & LOT 11 OF
Sylvan TIZAIC Subd. TIN R17E
Wal. Co. Wis.
1967


Lloyd L. Jensen
COUNTY SURVEYOR

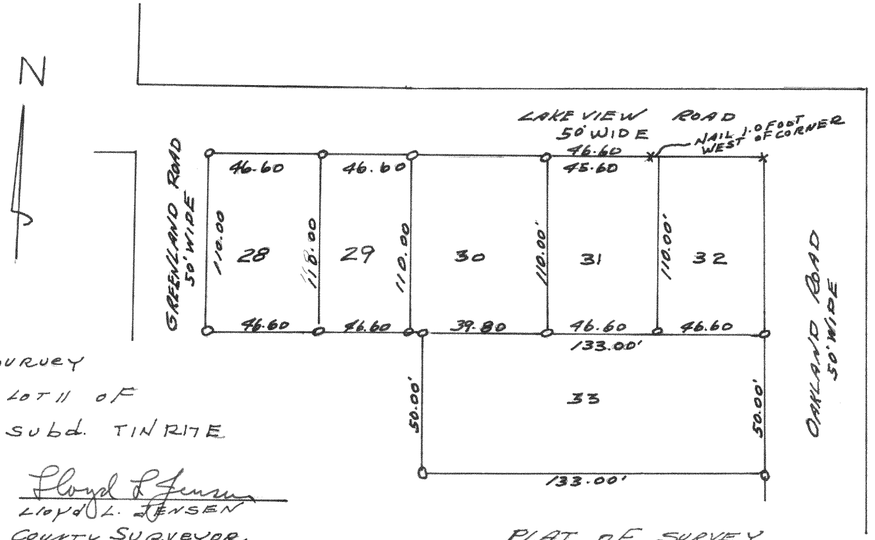

#4851

PLAT OF SURVEY
OF
LOTS 28, 29, 31 and 33, LAKE GENEVA
HIGHLANDS LOCATED IN THE
SE¼ SECTION 8, TIN RITE WAL. CO. WIS.
SEPT. 9, 1967


Lloyd L. Jensen
Lloyd L. JENSEN
COUNTY SURVEYOR

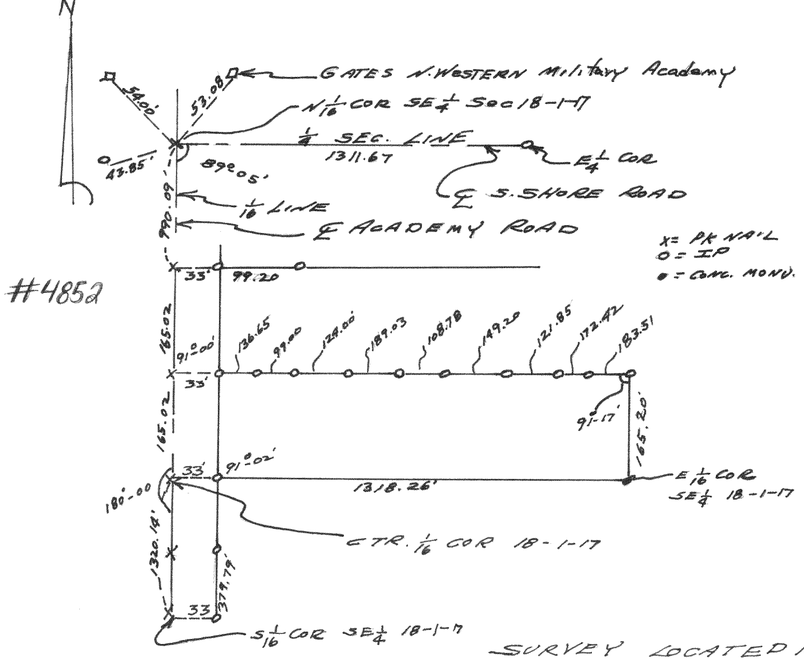

SURVEY LOCATED IN THE
SE¼ SECTION 18, TIN R17E WAL. CO. WIS.
1967

Lloyd L. Jensen
COUNTY SURVEYOR

#4853

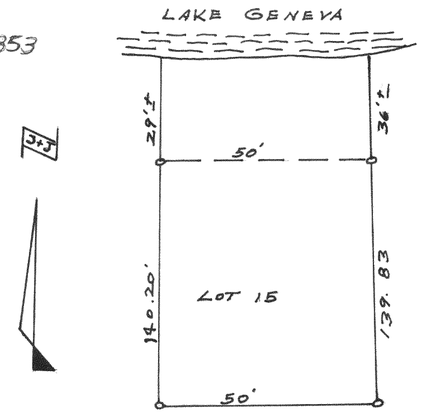

PLAT OF SURVEY
OF
LOT 15 LAKE GENEVA
HIGHLANDS SEC. 18
T1N R17E, WAL. CO. WIS.
OCT 6, 1966

Lloyd L. Jensen
Co. Surveyor