
P52

#4854

PLAT OF SURVEY
OF
LOT 8 SUNSET HILLS SHORES
LOCATED IN GOV. LOT 3, W½ SEC 4
T1N R17E WAL. CO. WIS.
July 20, 1966


Floyd L. Jensen
LLOYD L. JENSEN
CO. SURVEYOR

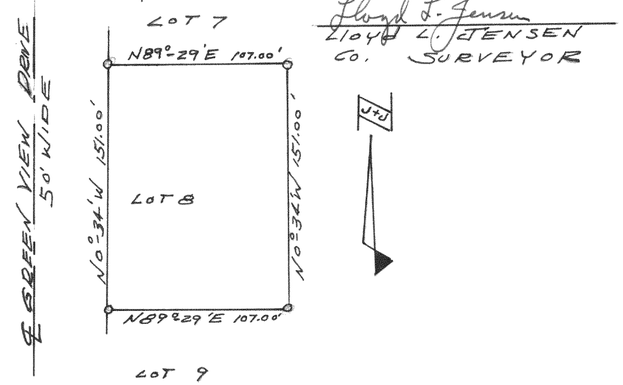


#4855

PLAT OF SURVEY
OF
LOTS 3562 & 3563 BLK 62
LAKE COMO BEACH SUBD.
T2N R17E WAL. CO. WIS
MAY 1967

Floyd L. Jensen
Lloyd L. JENSEN
Co SURVEYOR

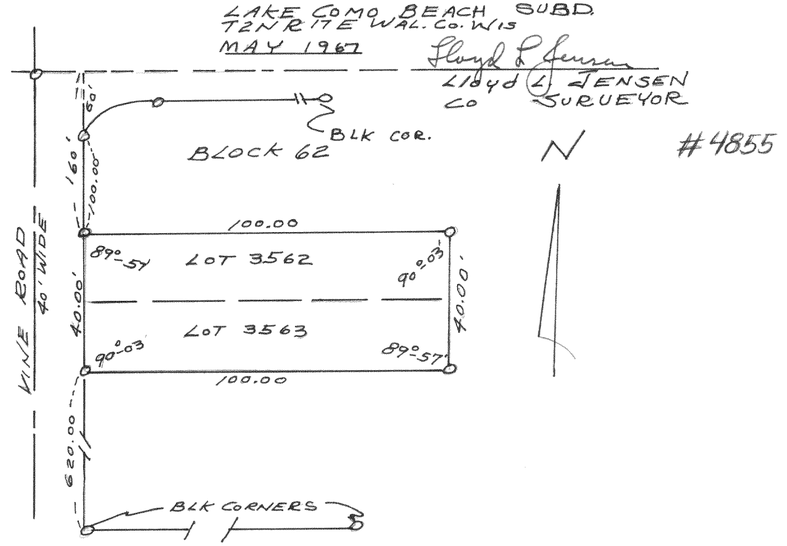

#4856

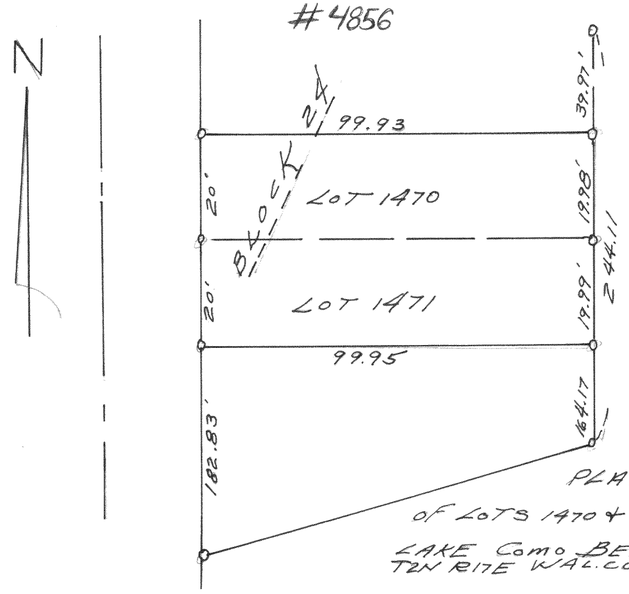


PLAT OF SURVEY
of LOTS 1470 & 1471 BLOCK 24
LAKE COMO BEACH SUBD.
T2N R17E WAL. CO. WIS.

APRIL 1967

Lloyd L. Jensen
LLOYD L. JENSEN
COUNTY SURVEYOR

#4857

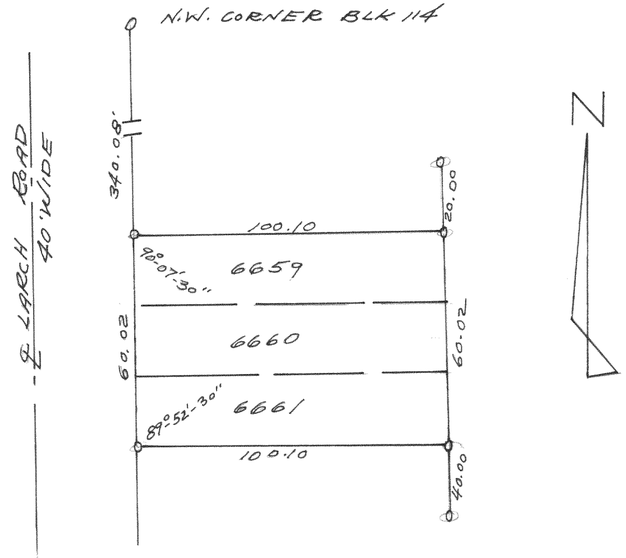

PLAT OF SURVEY
OF
LOTS 6659-6661 BLK 114
LAKE COMO BEACH SUBD. T2N R17E
WAL. CO. WIS
July 5, 1966

Floyd L. Jensen
LLOYD L. JENSEN
CO. SURVEYOR