
#4858

SURVEY OF Lot 6 BLK 4
Freemans 2ND ADD.
Genoa City, WAL Co. Wis.
Oct. 1963

Lloyd L. Jensen
Lloyd L. Jensen Co. Surveyor

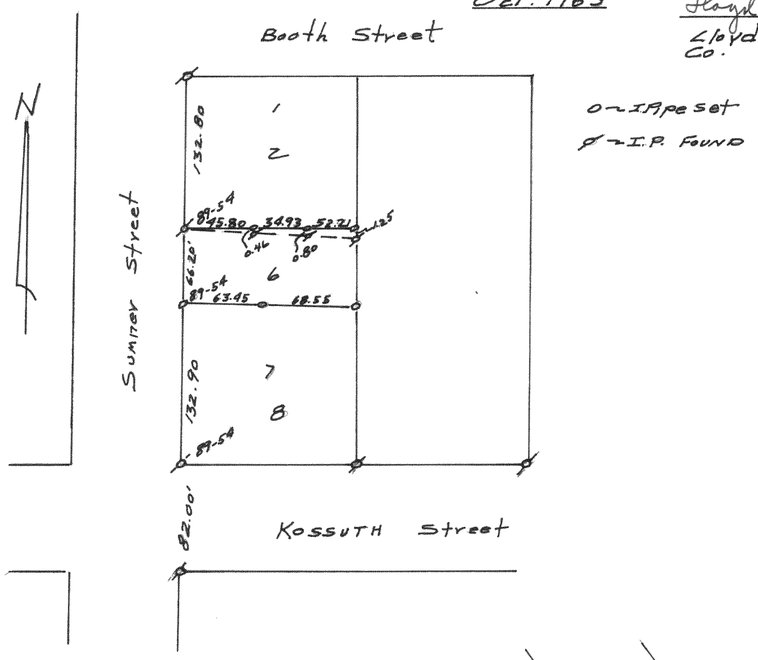


○-IA pe set
⌀-I.P. FOUND

#4859

PLAT OF SURVEY OF THE N. 114.66' OF THE WEST 50.00' OF LOT 2 BLK 10 ORIGINAL PLAT, CITY OF LAKE GENEVA - NW¼ SEC. 36, T2N - R17E WAL. CO. WIS.
DEC 2, 1967


Lloyd L. Jensen
LLOYD L. JENSEN
COUNTY SURVEYOR

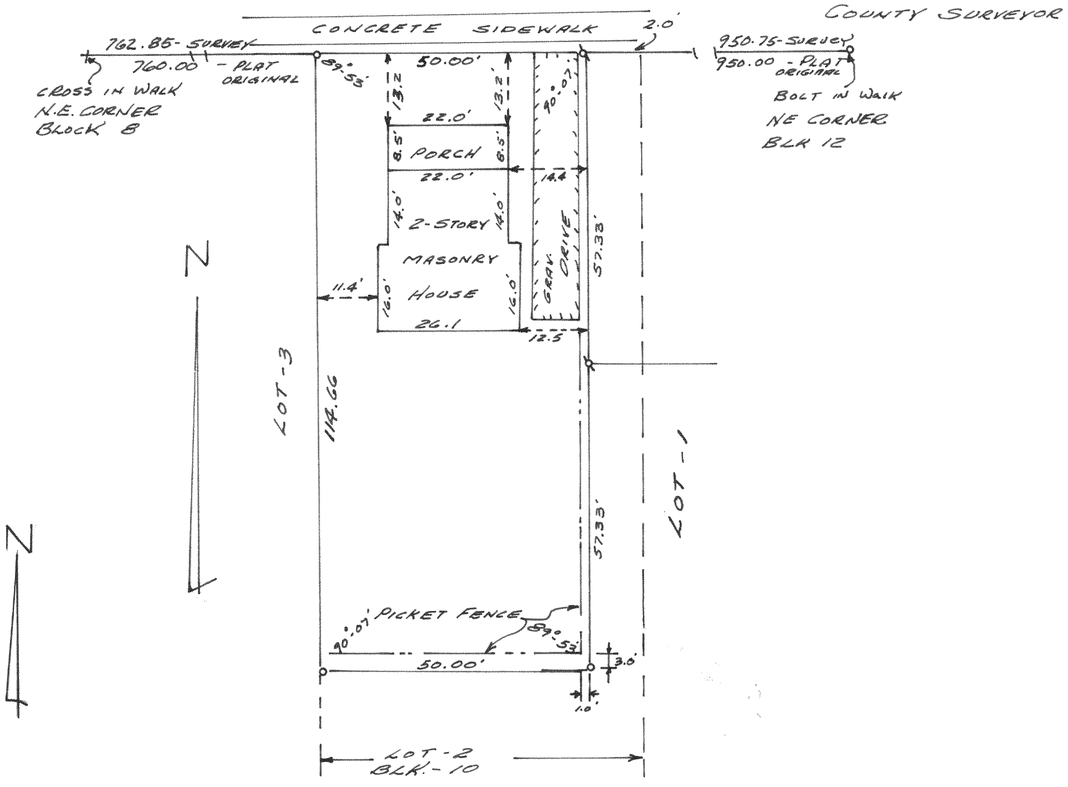

#4860

PLAT OF SURVEY
OF
LOT 12 OF JEWELL'S SUBD.
LOCATED IN THE SE ¼ SEC. 1,
T1N R16E WILLIAMS BAY, WIS.
OCT. 7, 1966

Lloyd L. Jensen
LLOYD L. JENSEN
COUNTY SURVEYOR

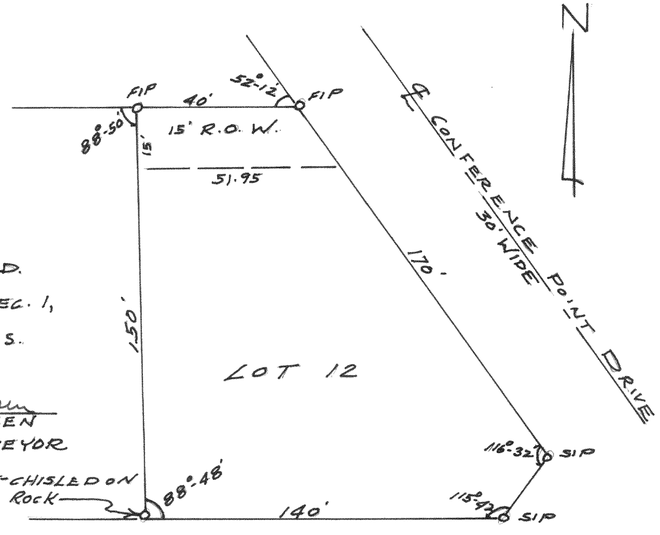

℄ JEWELL DRIVE 30' WIDE