

#4861

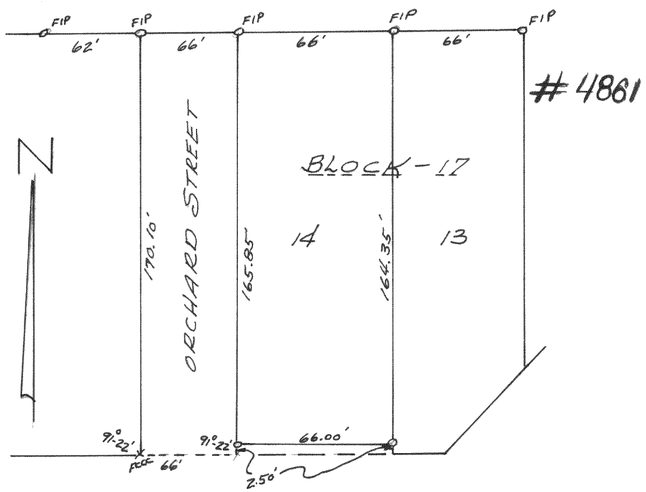

#4862

PLAT OF SURVEY OF LOT 27 STARKS SUB.
WILLIAMS BAY, WIS.
July 1966


Lloyd L Jensen
LLOYD L JENSEN
Co. Surveyor

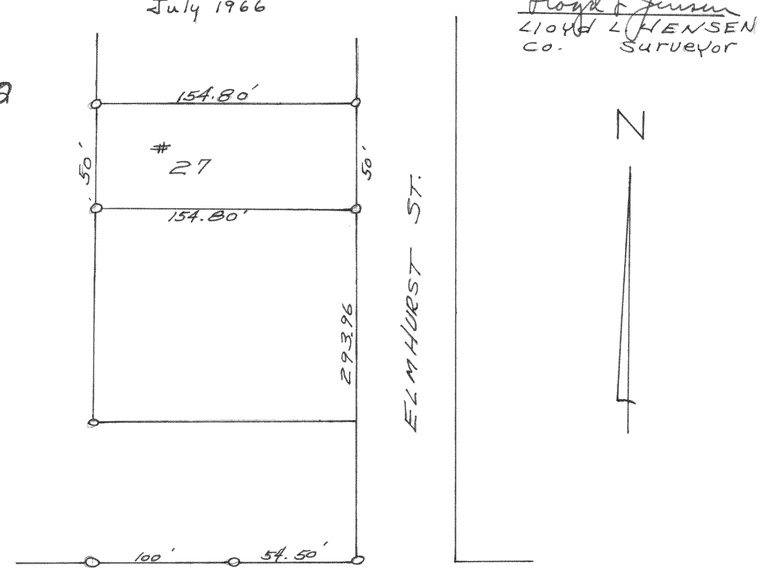

PLAT OF SURVEY OF LOT 14, BLOCK 17
WILLIAMS 2nd Addition, WILLIAMS BAY, WIS.
JULY 1966

Lloyd L Jensen
LLOYD L. JENSEN
COUNTY SURVEYOR


#4863

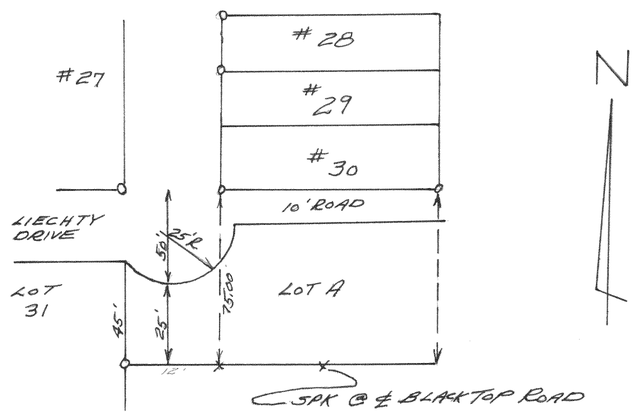

SURVEY OF 25' SETBACK FOR BUILDING
LOT A SUMMER HAVEN, WILLIAMS BAY, WIS.
DEC 1966

Lloyd L Jensen
LLOYD L. JENSEN
CO. SURVEYOR

#4864

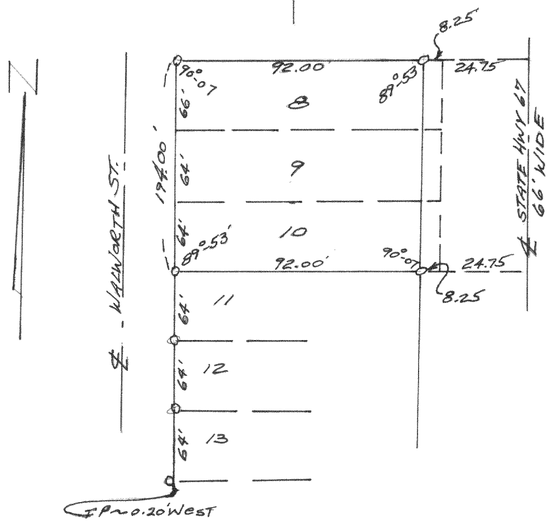

PLAT OF SURVEY OF THE WEST 92'
OF LOTS 8, 9, 10 Wm. H. FRANCIS SUBD.
WILLIAMS BAY, WIS.
Aug 1967

Lloyd L Jensen
LLOYD L. JENSEN
COUNTY SURVEYOR