
PLAT OF SURVEY
OF

#4869 LOT 11 BLOCK B CISCO BEACH SUBDIVISION LOCATED IN THE NW 1/4 SECTION 5, T1N-R 17E, WALWORTH COUNTY, WISCONSIN.

AUG. 1967

Lloyd L Jensen
COUNTY SURVEYOR

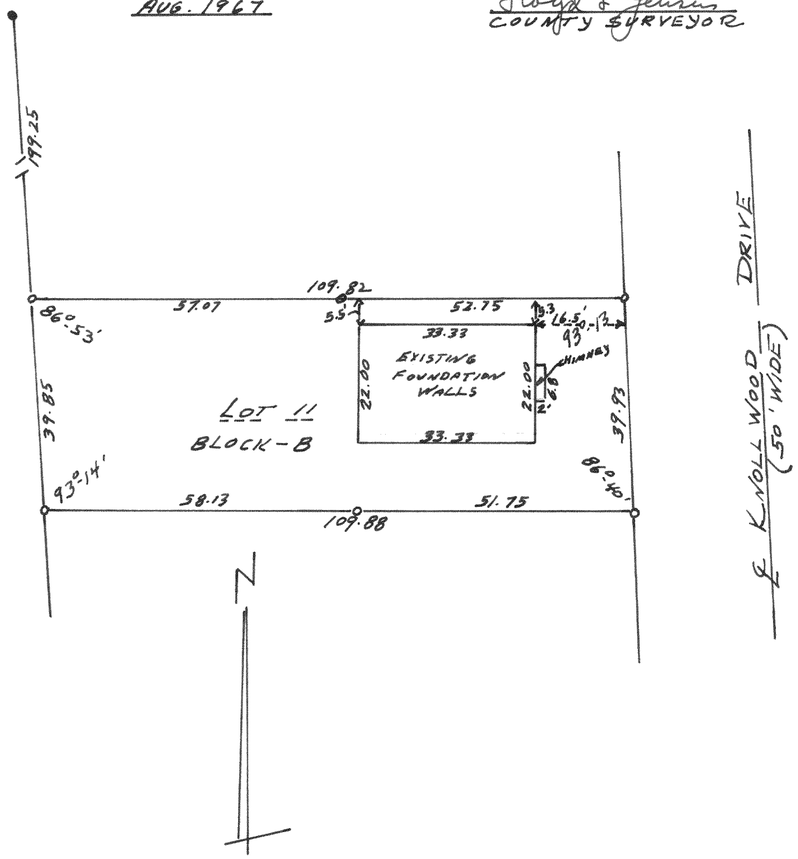

PLAT OF SURVEY
OF

#4870 LOT 45 CEDAR POINT PARK SUBDIVISION SE 1/4 SEC. 6. T1N-R17E, WALWORTH CO. WISCONSIN.

AUG. 1967

Lloyd L Jensen
COUNTY SURVEYOR

