

#2979

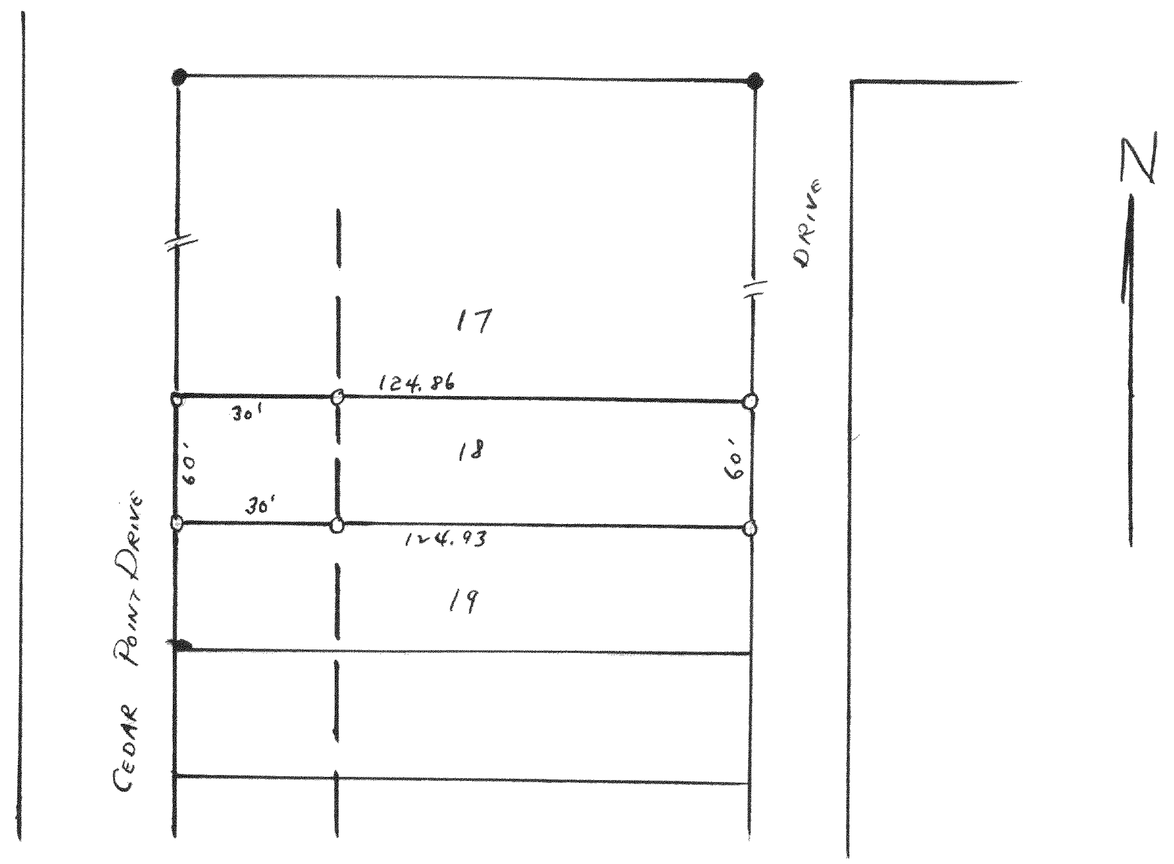

Plat of Survey of Lot 18 Cedar Point Park Subd
Village of Williams Bay Walworth County Wisconsin

February 1954 Lloyd L Jensen CRS
County Surveyor


#2980

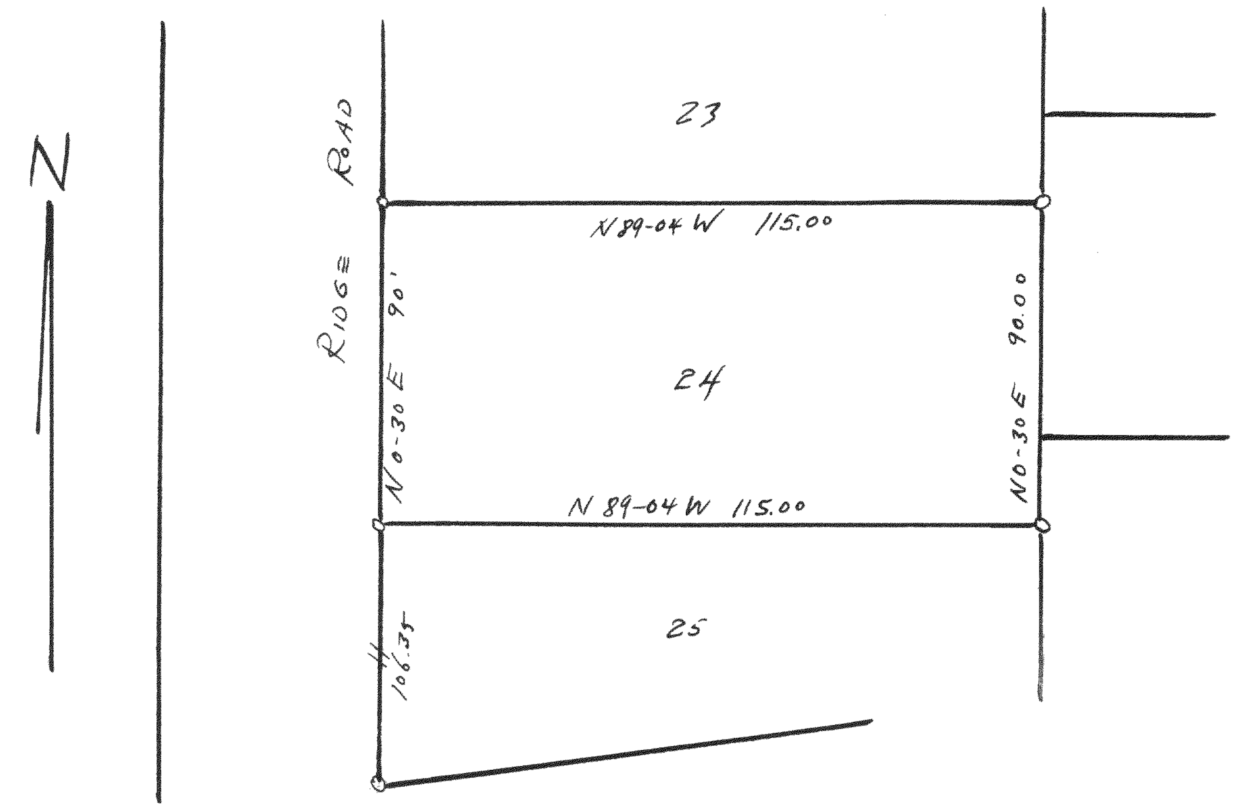

Plat of Survey of Lot 24 Sturwood Addition
To The City of Lake Geneva
Walworth County Wisconsin

March 1954 Lloyd L Jensen CRS
County Surveyor


2981

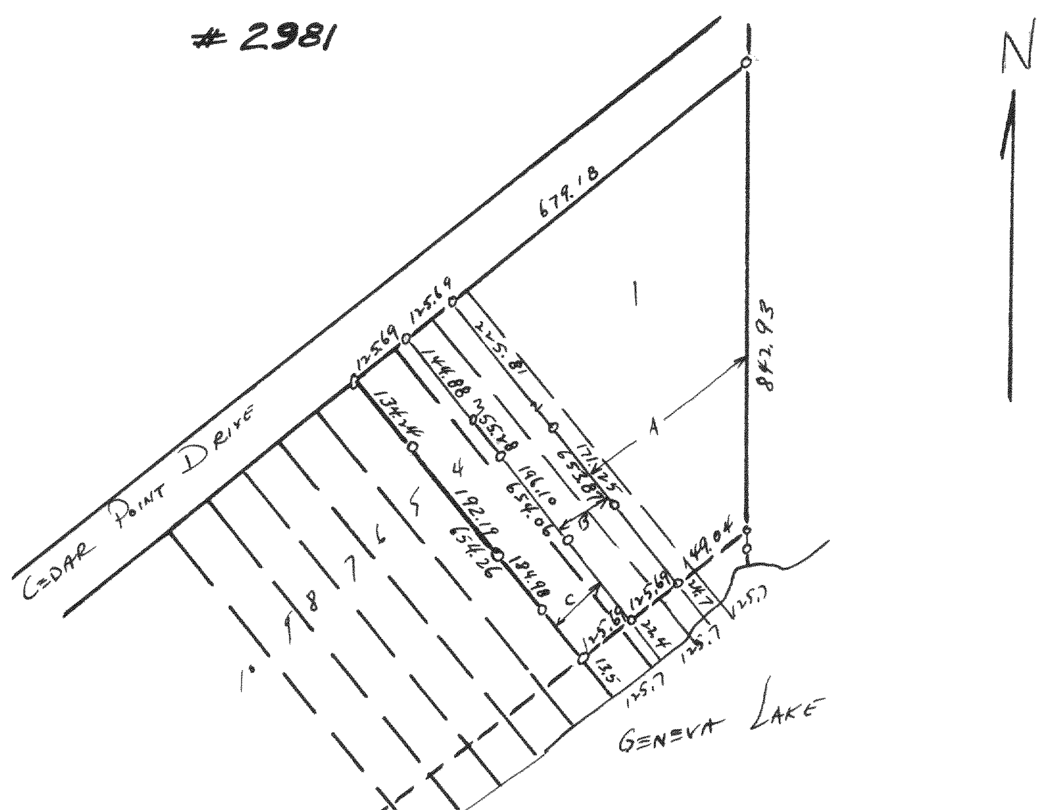

Plat of Survey of
Lots 1-4 of Cedar Point Subd
Village of Williams Bay
Walworth County, Wisc

May 1954 Lloyd L Jensen CRS
County Surveyor

#2982

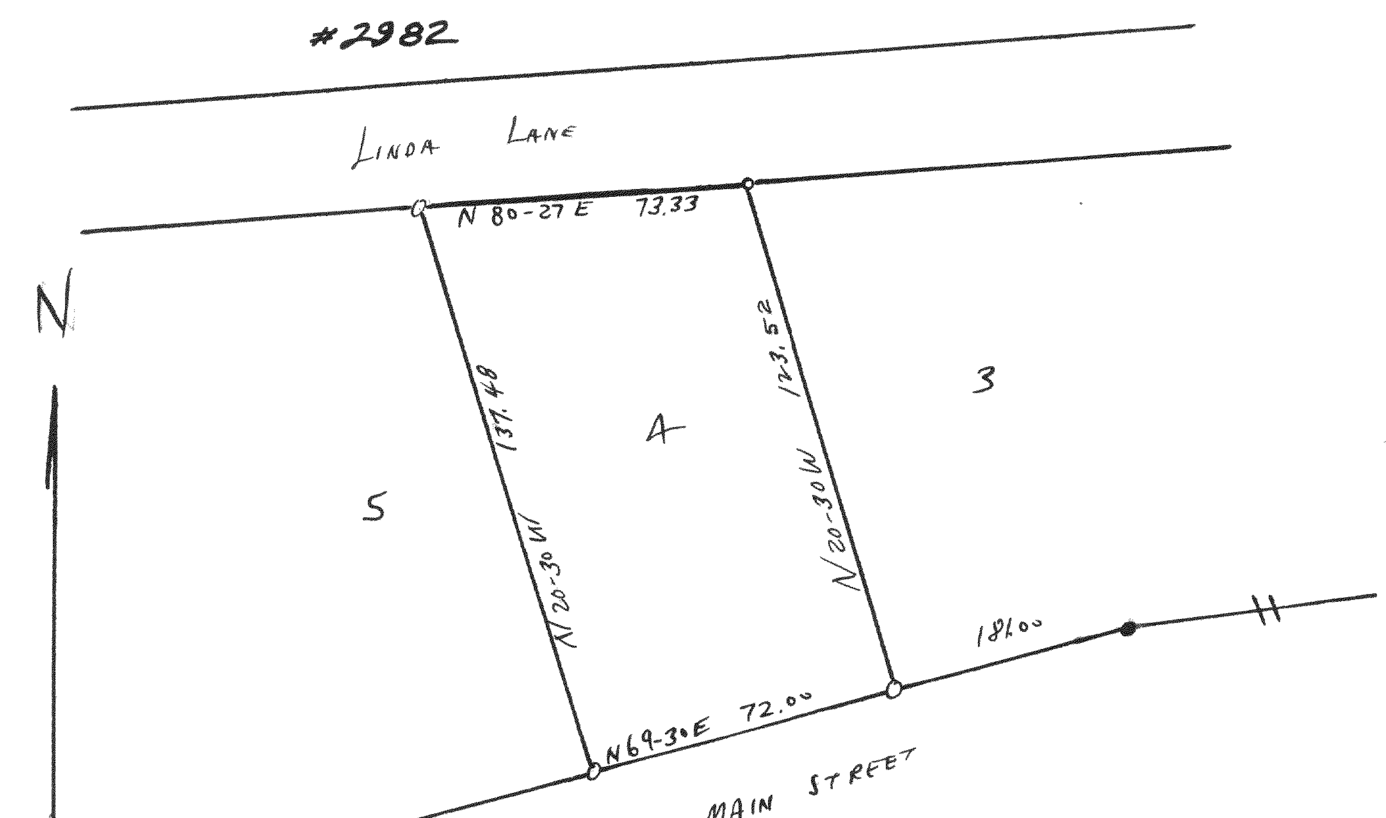

Plat of Survey of Lot 4 Sturwood Addition
To The City of Lake Geneva,
Walworth, County, Wisconsin.

March 1954

Lloyd L Jensen CRS
County Surveyor