
#2983

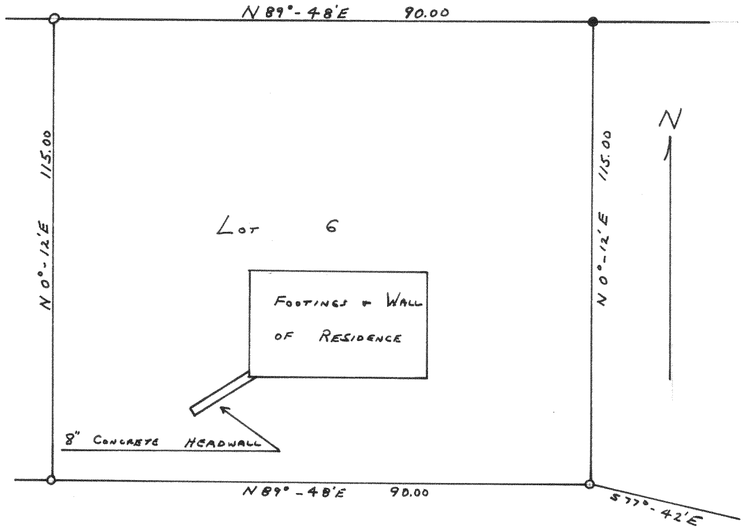


5

Plat of Survey of Lot 6 of Addition D to Country Club Estates Located in the Village of Fontana-on-Geneva Lake Walworth County, Wisconsin

November 1954

Lloyd L. Jensen SA.
County Surveyor

#2985

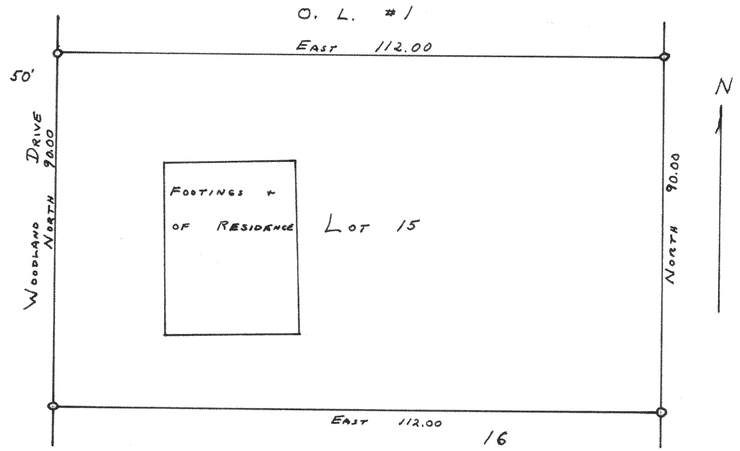


16

Plat of Survey or Lot 15 of Addition D to Country Club Estates Located in the Village of Fontana-on-Geneva Lake Walworth County, Wisconsin.

November 1954

Lloyd L. Jensen SA
County Surveyor

#2984

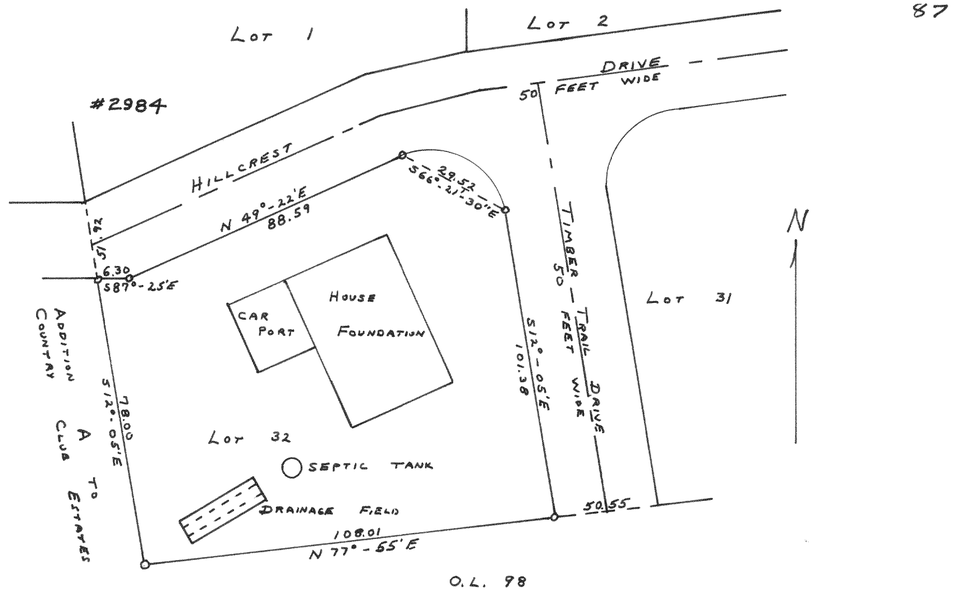

Plat of Survey of Lot 32 of Addition "D" to Country Club Estates Located in the Village of Fontana-on-Geneva Lake Walworth County, Wisconsin.

December 1954

Lloyd L. Jensen SA
County Surveyor

#2986



Plat of Survey of Lot 27 Addition D To Country Club Estates Village of Fontana Walworth County Wis

Nov 1954

Lloyd L Jensen CPS
County Surveyor