

#2987

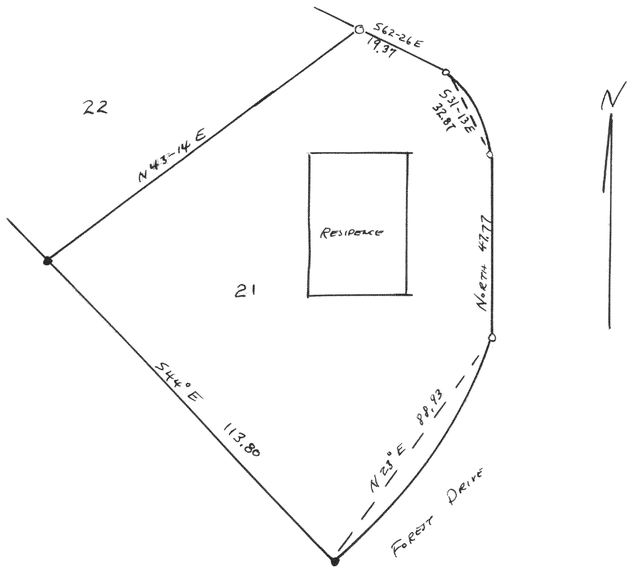

Plat of Survey of Lot 21 Add'n "D" T. Country Club Estates
Village of Fontana —on— Geneva Lake
Walworth County, Wisconsin
Nov 1956 Lloyd L Jones
County Surveyor


For Survey of Addition "E" To
Country Club Estates Part of O.L. 90
Village of Fontana, Wisconsin Located in
Sections 14 & 23, See Volume 12
page 101 & 102 in Register of
Deeds Office, Walworth County, Wisconsin.

#2988

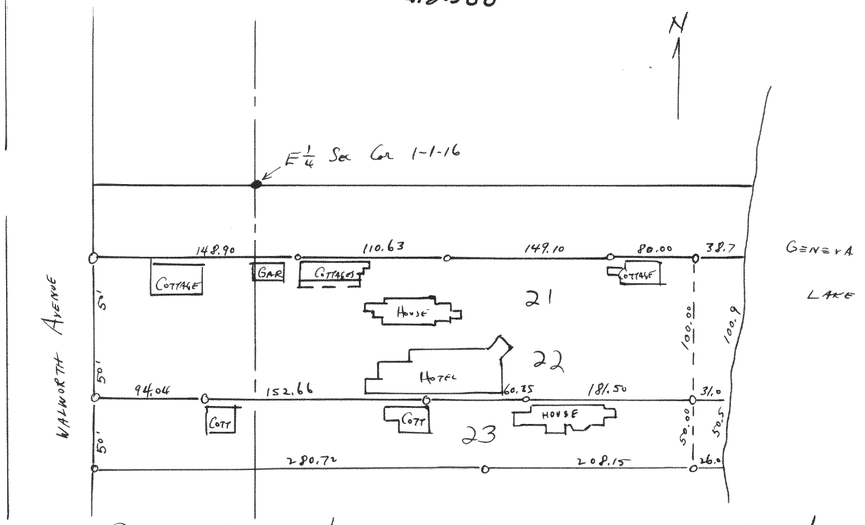

Plat of Survey of Lots 21-23, Block 7 of Williams Third Add'n
Village of Williams Bay, Walworth County Wis
Dec 1954 Lloyd L Jones
County Surveyor

#2989

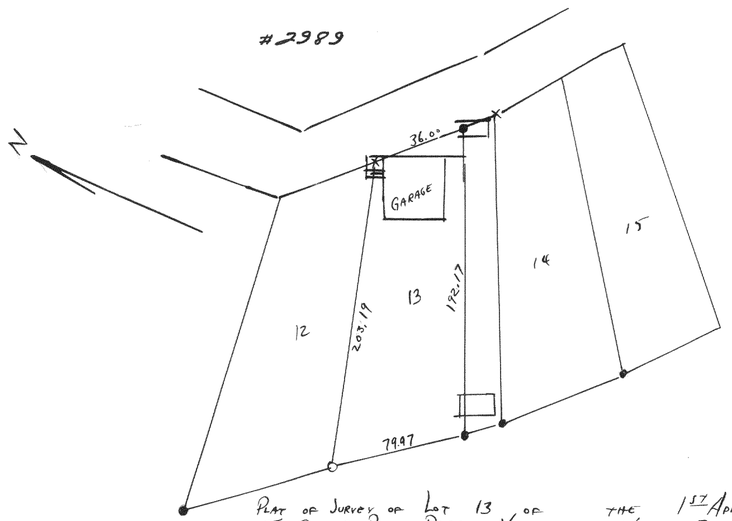

Plat of Survey of Lot 13 of the 1st Addition
To Cedar Point Park, Village of Williams Bay
Walworth County, Wis
Oct 1954 Lloyd L Jones
County Surveyor