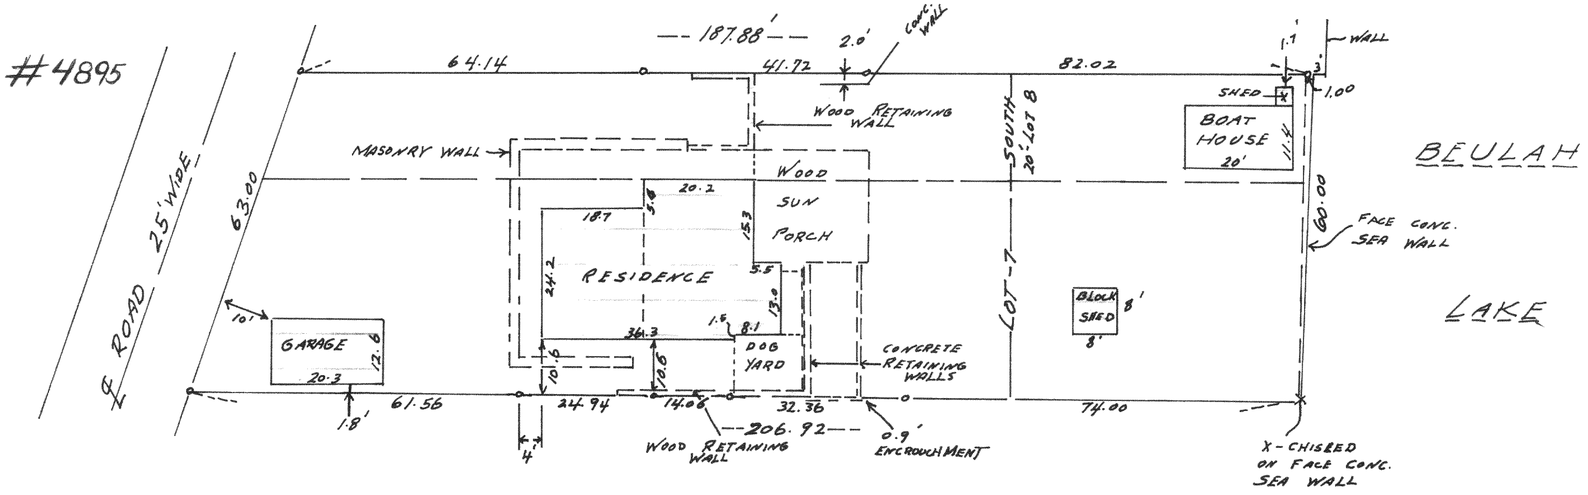


PLAT OF SURVEY
OF

LOT 7 AND THE SOUTH 20 FEET LOT 8 - BLOCK 1 - WILMER GROVE BEACH SUBDIVISION E½ SECTION 18, T 4 N - R 18 E, WALWORTH COUNTY, WISCONSIN.

JUNE 9, 1967

Floyd L. Jensen
COUNTY SURVEYOR