
PLAT OF SURVEY

OF

PART OF LOTS 2 & 3 BLK. 6 CL. DOUGLASS ADD.
SEC. 15, T1N R16E VILLAGE OF FONTANA, WIS.
AUG. 1967

Lloyd R Jensen
COUNTY SURVEYOR

#4908

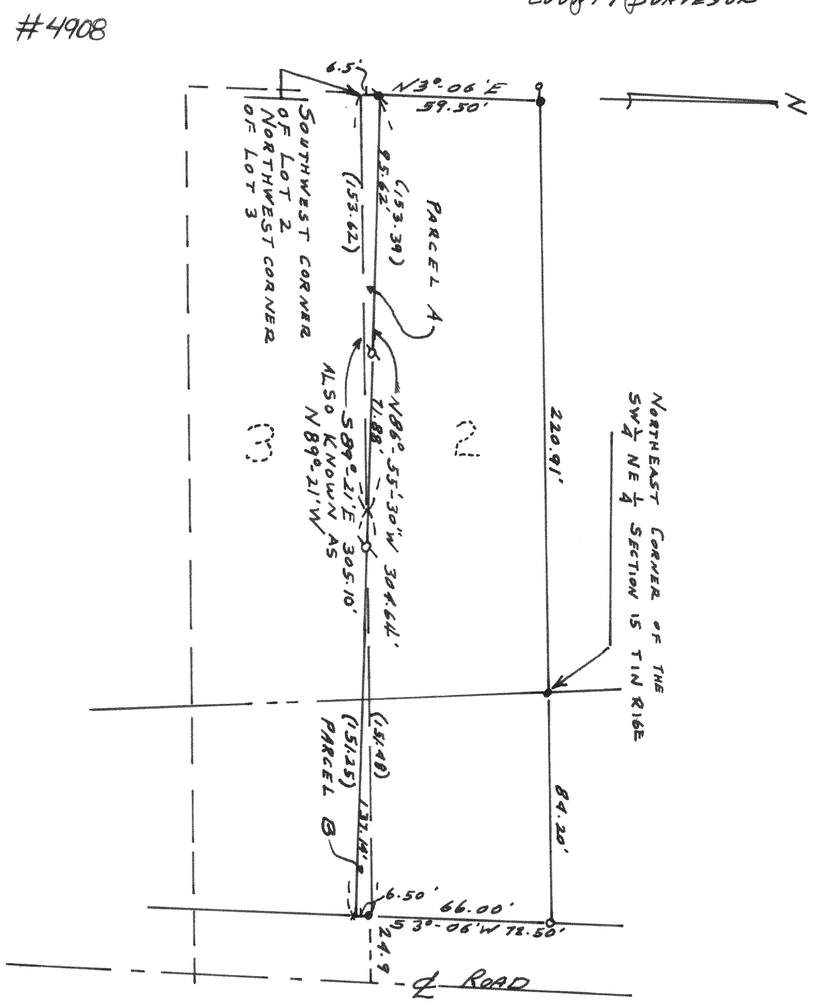

PLAT OF SURVEY

OF

SEPT. 1967

Lloyd R Jensen
COUNTY SURVEYOR

#4909

