#4916

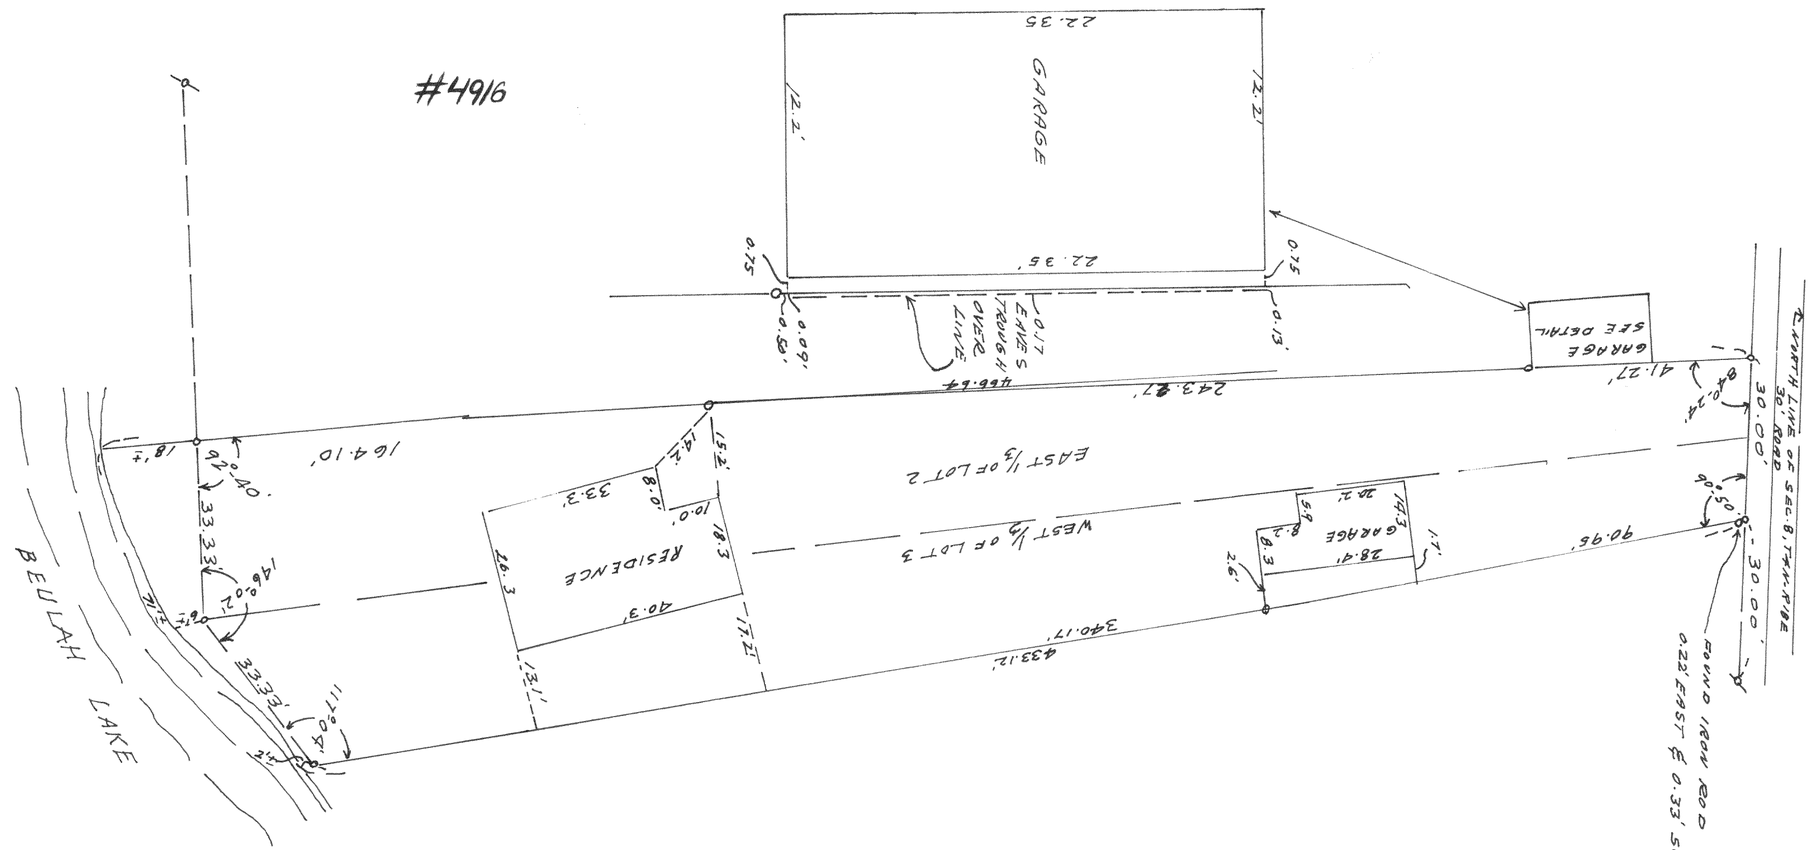

PLAT OF SURVEY
OF
THE EAST 1/3 OF LOT 2 & THE WEST 1/3
OF LOT 3 OF ROMADKA PARK SUBD.
LOCATED IN THE NE 1/4 SECTION 8
& THE SE 1/4 SECTION 5, T4N R18E
WALWORTH COUNTY, WISCONSIN

JAN. 1968

Lloyd L Jensen
COUNTY SURVEYOR