
#4916

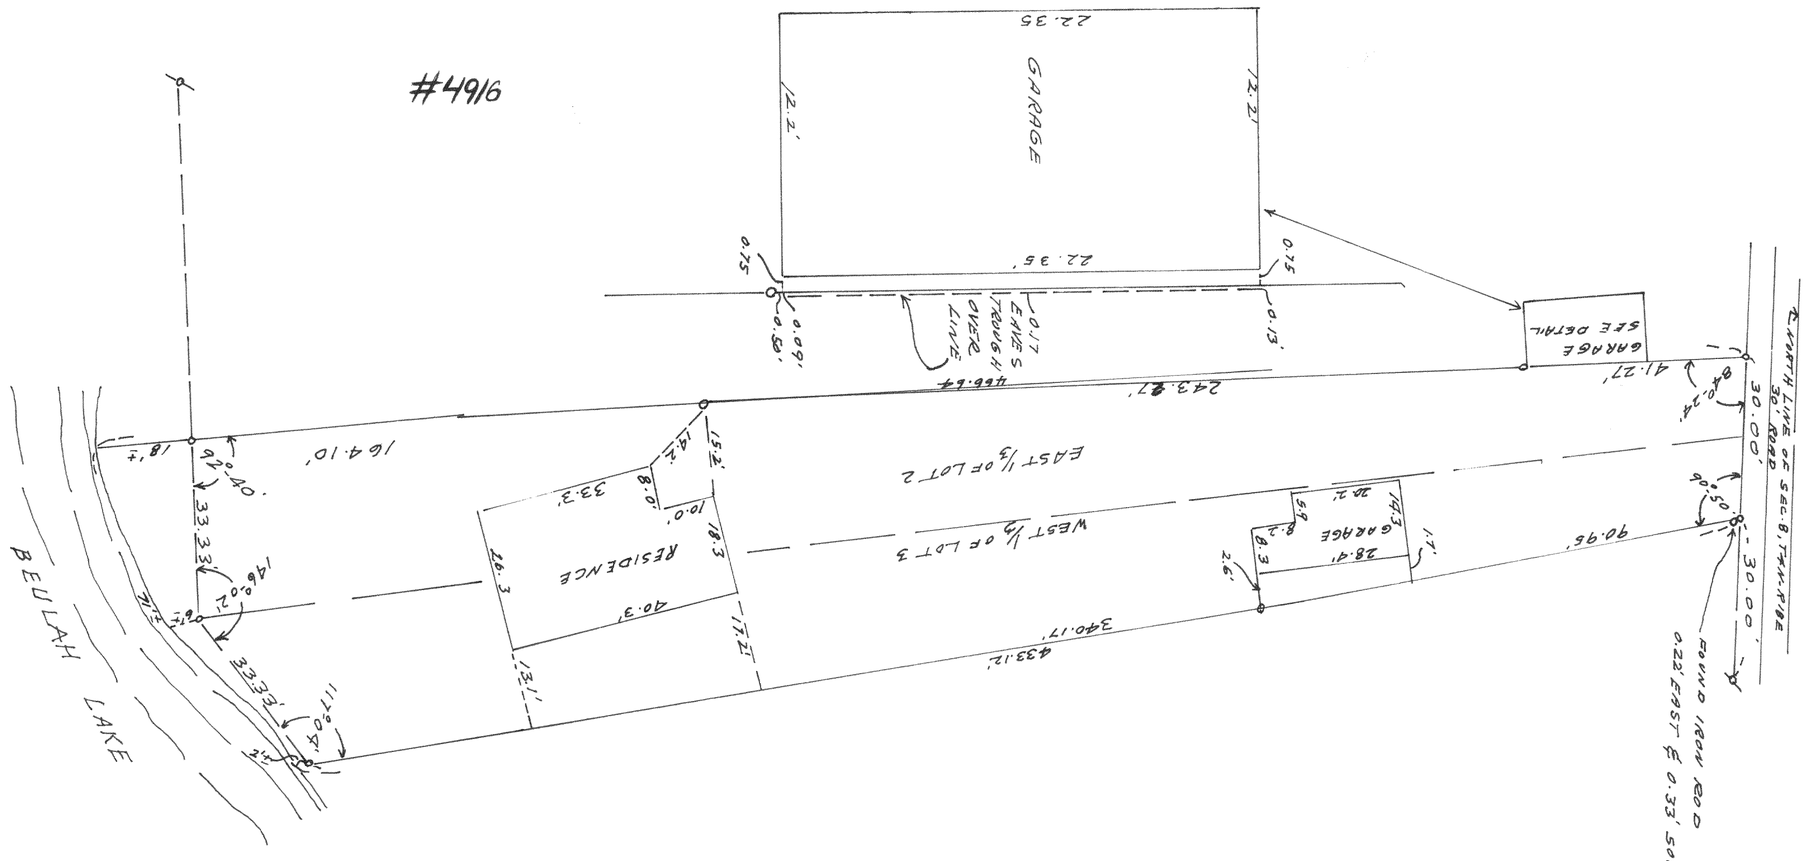

PLAT OF SURVEY
OF
THE EAST 1/3 OF LOT 2, & THE WEST 1/3 OF LOT 3 OF ROMADKA PARK SUBD. LOCATED IN THE NE 1/4 SECTION 8 & THE SE 1/4 SECTION 5, T4N R18E WALWORTH COUNTY, WISCONSIN

JAN. 1968

Lloyd L Jensen
COUNTY SURVEYOR