

2645

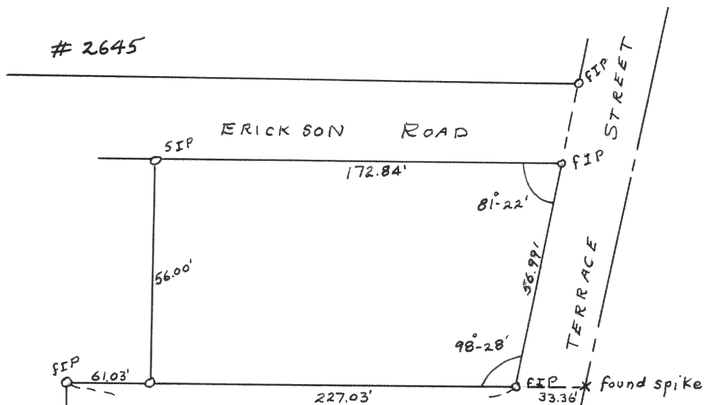

Plat of survey of land located in the NW¼ of Section 18, T2N R16E, City of Delavan
Dec. 29, 1951

Lloyd L Jensen (R.L.S.)
County Surveyor

2646

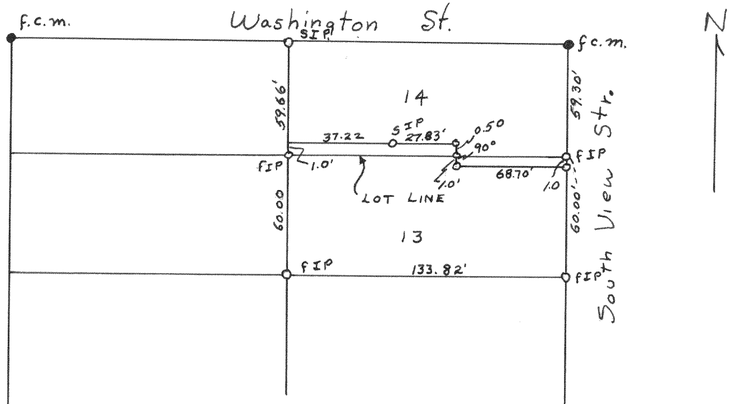


Plat of survey of lots 13 and 14 of Block 2 of Sunset View Subdivision in the City of Delavan.

June 4, 1952

Lloyd L Jensen (R.L.S.)
County Surveyor

2647

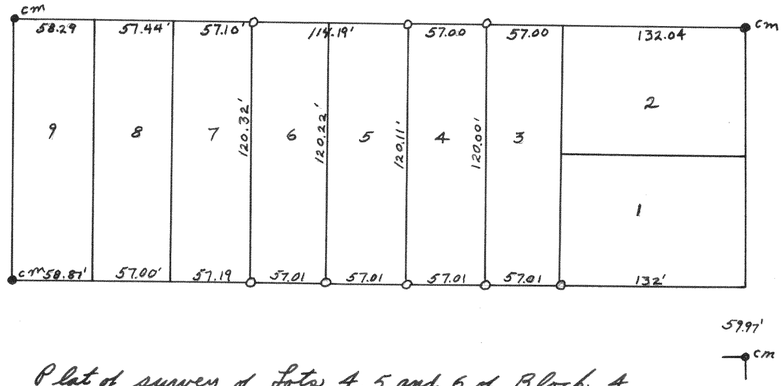


Plat of survey of Lots 4, 5 and 6 of Block 4 of Fairview Heights in the City of Delavan.

April 24, 1952

Lloyd L Jensen (R.L.S.)
County Surveyor

2648

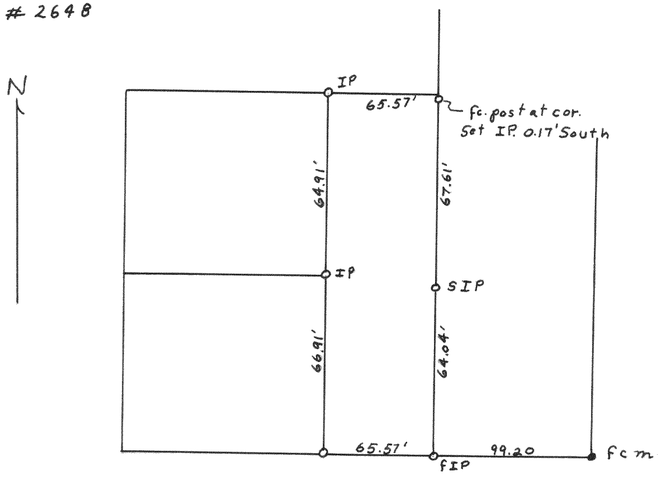

MICHIGAN STR.

Plat of survey of a parcel of land in the City of Delavan on Michigan Street

April 10, 1952

Lloyd L Jensen (R.L.S.)
County Surveyor