

902

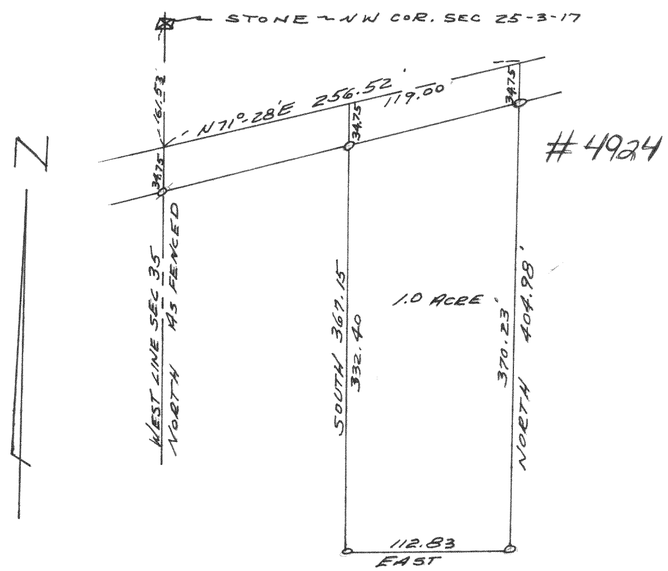


PLAT OF SURVEY OF
A PARCEL LOCATED IN THE NW¼ SEC 35-3-17
WAL. CO. WIS DEC 1967

Floyd L Jensen
LLOYD L JENSEN
CO. SURVEYOR

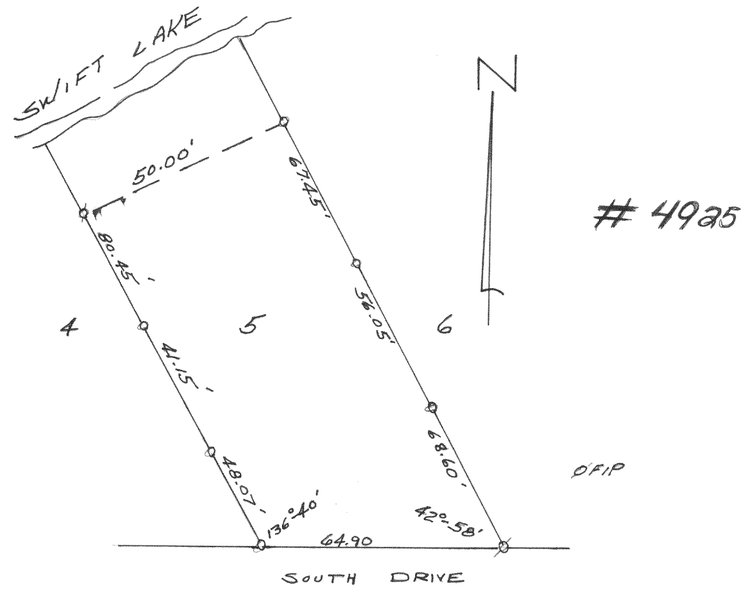


PLAT OF SURVEY OF LOTS 5 BLK 2
SWIFT LAKE SUBD. T4N R17E
WAL. CO. WIS.
JULY 1967

Floyd L. Jensen
LLOYD L. JENSEN
COUNTY SURVEYOR

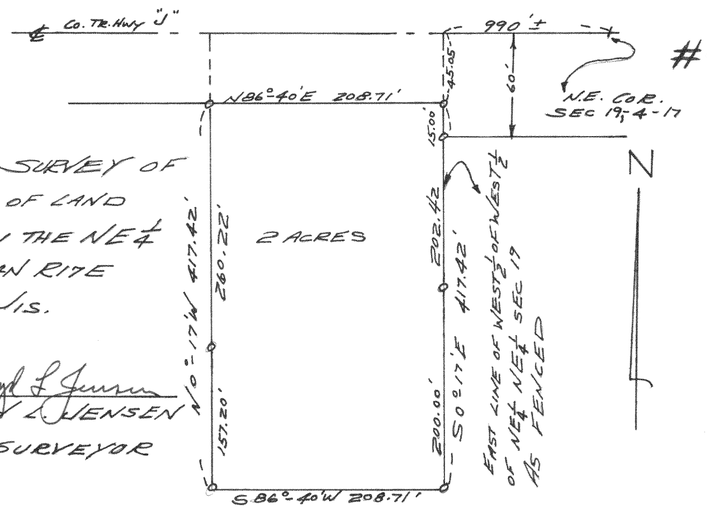

Floyd L Jensen
LLOYD L JENSEN
Co. SURVEYOR

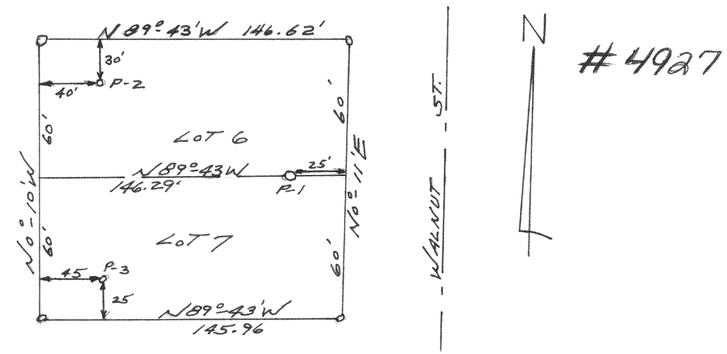

PLAT OF SURVEY OF LOTS 6 + 7
BLK 22 MIRAMAR ADD. #1 LOC. IN
NE¼ SEC 10, T4N R18E WAL. CO. WIS.
MARCH 1967

Floyd L Jensen
LLOYD L JENSEN
CO. SURVEYOR