

906

SURVEY OF A PARCEL
IN THE SW¼ SEC. 20
T4N R18E EAST TROY, WIS.
OCT 1966

Lloyd L Jensen
LLOYD L. JENSEN
CO. SURVEYOR

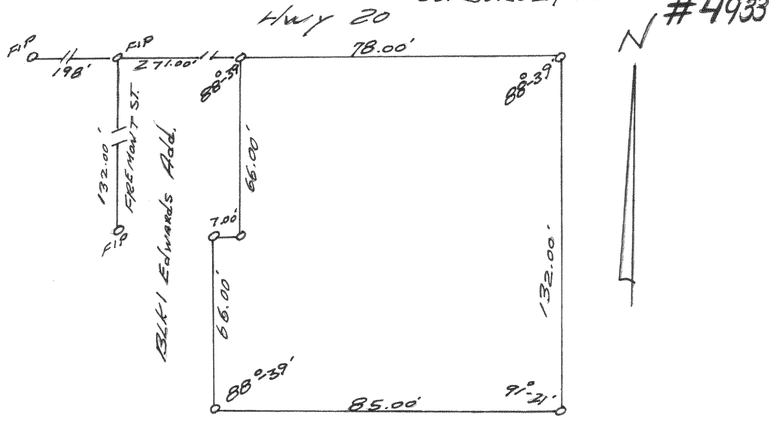

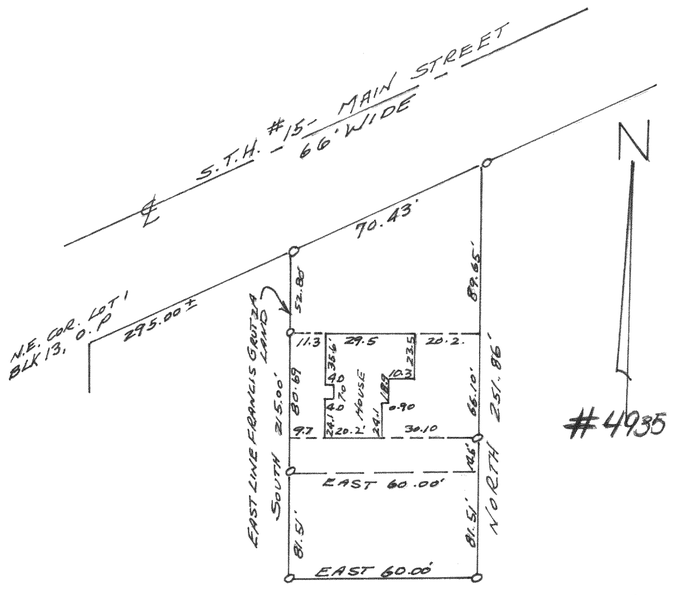



PLAT OF SURVEY OF LOT IN SW¼
SEC. 20, T4N R18E, EAST TROY, WIS.
JUNE 5, 1967

Lloyd L Jensen
Lloyd L Jensen
County Surveyor

SURVEY OF NORTH LINE LOT 9 BLK 35
DAVIS Add. ELKHORN, WISCONSIN.
April 1967

Lloyd L Jensen
LLOYD L. JENSEN
COUNTY SURVEYOR

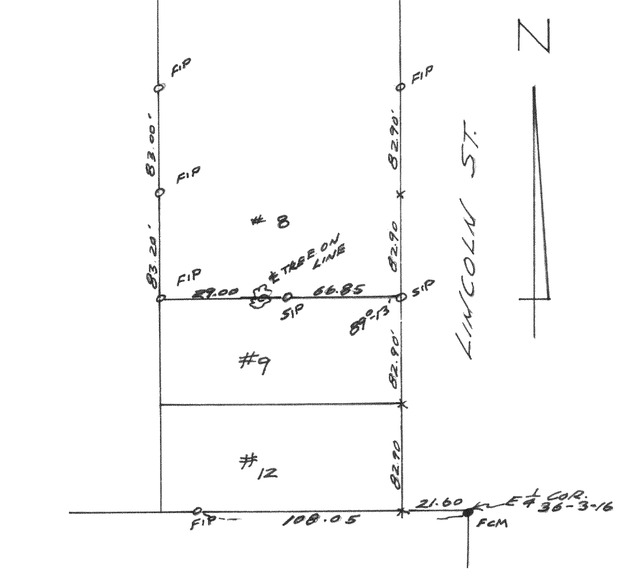

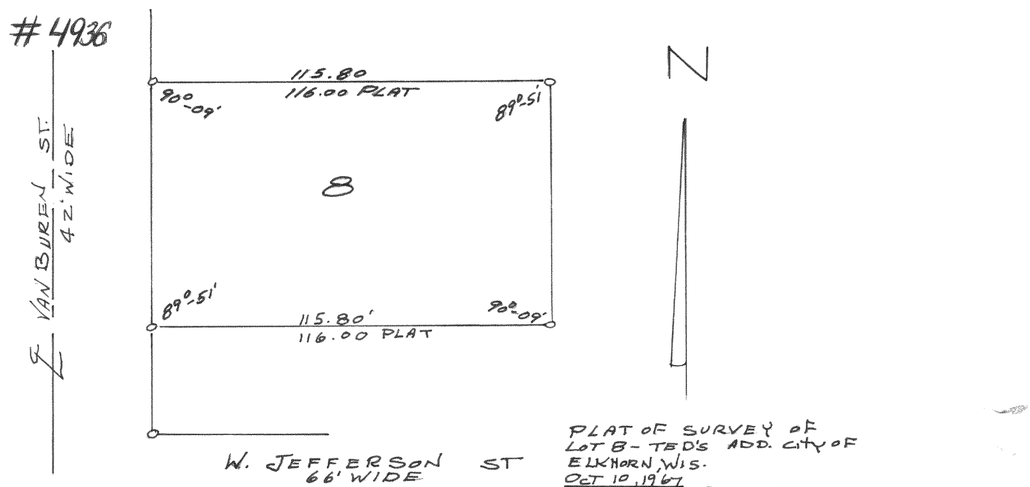

PLAT OF SURVEY OF
LOT 8 - TED'S ADD. CITY OF
ELKHORN, WIS.
OCT 10, 1967

Lloyd L Jensen
LLOYD L. JENSEN
COUNTY SURVEYOR