

#2999

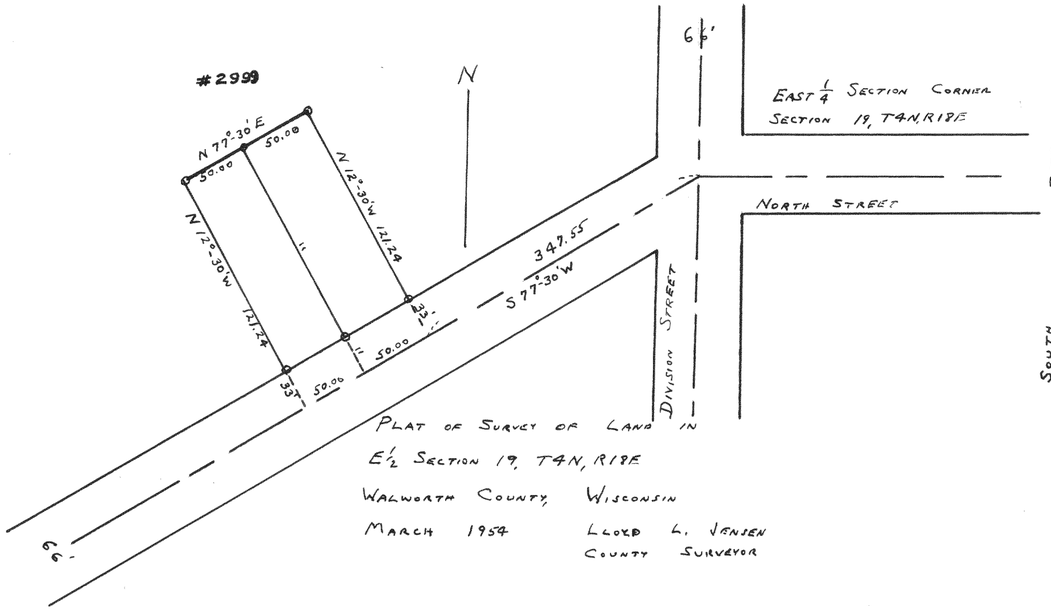


PLAT OF SURVEY OF LAND IN
E½ SECTION 19, T4N, R18E
WALWORTH COUNTY, WISCONSIN
MARCH 1954 LLOYD L. JENSEN
COUNTY SURVEYOR

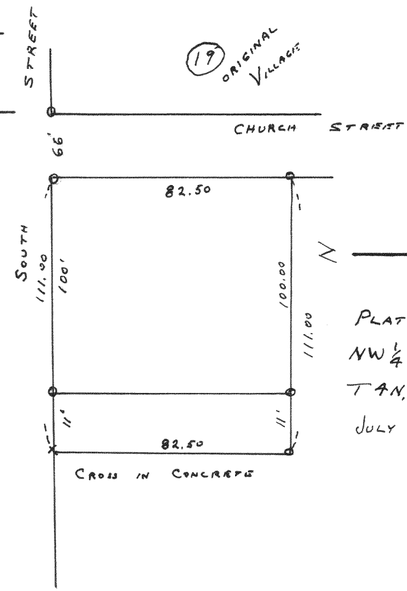

#3000

PLAT OF SURVEY OF LAND IN
NW¼ OF NW¼ OF SECTION 29,
T4N, R18E WALWORTH COUNTY, WISCONSIN
JULY 1954 LLOYD L. JENSEN
COUNTY SURVEYOR

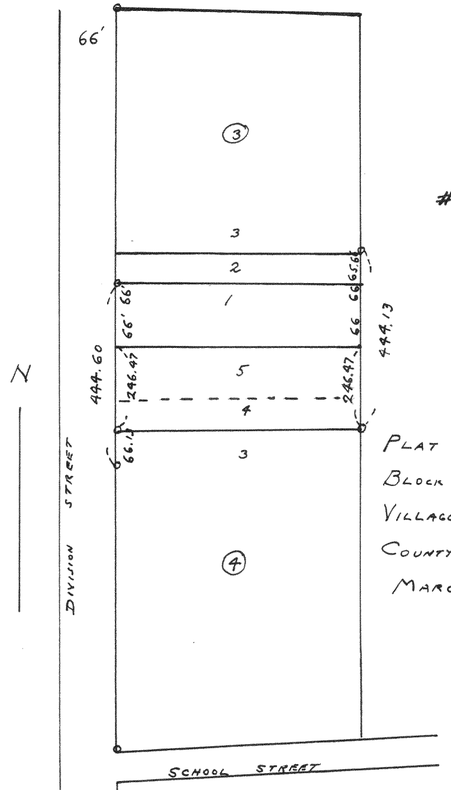



#3001

PLAT OF SURVEY OF LOT 3
BLOCK 4 S. B. EDWARD'S ADDITION
VILLAGE OF EAST TROY, WALWORTH
COUNTY, WISCONSIN
MARCH 1954 LLOYD L. JENSEN
COUNTY SURVEYOR

#3001½

PLAT OF SURVEY OF LAND IN NE¼ OF SE¼ OF SECTION
19, T4N, R18E WALWORTH COUNTY, WIS.
OCTOBER 1954 LLOYD L. JENSEN
COUNTY SURVEYOR

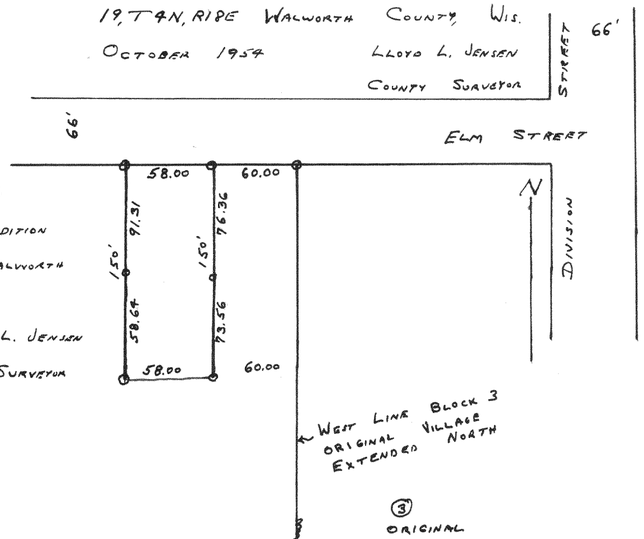

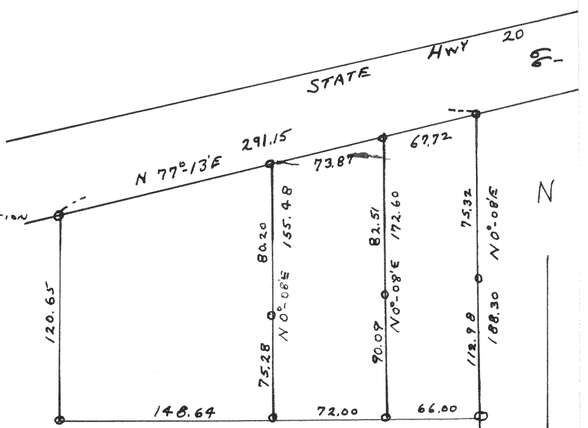

#3002

Plat of Survey of land in
Village of East Troy
1954