
#4943

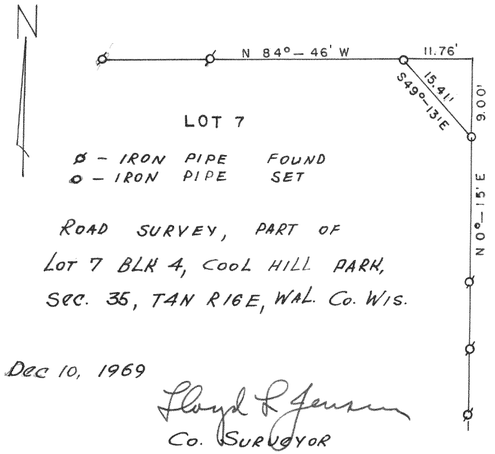


ROAD SURVEY, PART OF
LOT 7 BLK 4, COOL HILL PARK,
SEC. 35, T4N R16E, WAL. CO. WIS.

Dec 10, 1969

Lloyd L Jensen
Co. SURVEYOR

#4944

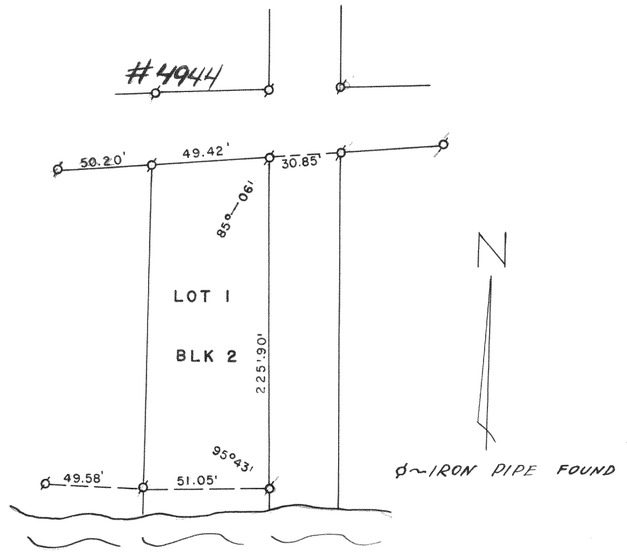


PLAT OF SURVEY OF
LOT 1 BLK 2 COOPERS MID LAKE SUBD.

July 1968

Lloyd L Jensen
Co SURVEYOR


#4945

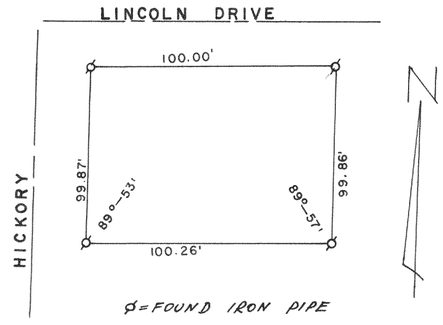

SURVEY OF
LOTS 5720-5724, BLK 102
LAKE COMO BEACH SUBD.
AVG. 1968

Lloyd L Jensen
Co. SURVEYOR


#4946

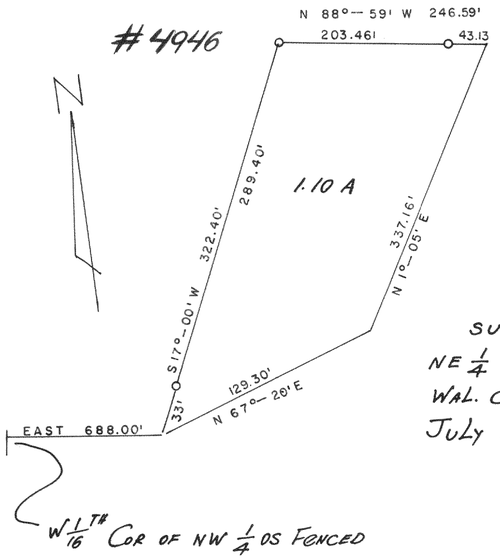

SURVEY IN THE
NE 1/4 OF SECTION 14, T4N R16E
WAL. CO. WIS.
JULY 22, 1968

Lloyd L Jensen
Co. SURVEYOR

#4947

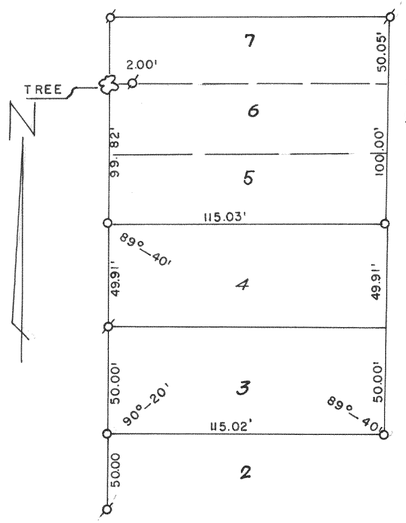

SURVEY OF LOTS 3-4
BLK 25 SUNSET HILLS
SEC 33, T2N R17E
WAL. CO. WIS
OCT. 1968

Lloyd L Jensen
Co. SURVEYOR