
912

#4949

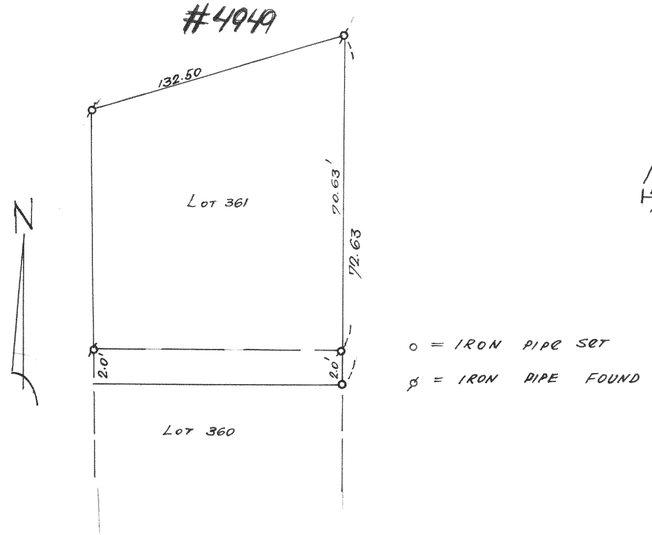

o = IRON PIPE SET

⌀ = IRON PIPE FOUND

PLAT OF SURVEY OF

LOT 361 & THE N. 2.0' OF LOT 360


LAKE DELAVAN HIGHLANDS

T2N R16E, WAL. CO. WIS.

MAY 1969

Floyd L Jensen
COUNTY SURVEYOR

#4950

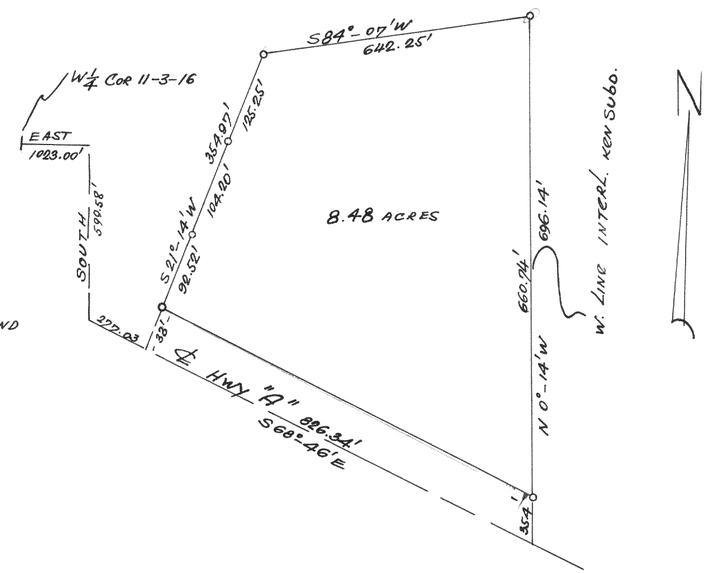


SURVEY OF PARCEL IN THE

SW¼ SEC. 11-3-16

JULY 1968

Floyd L Jensen
Co. SURVEYOR

#4951

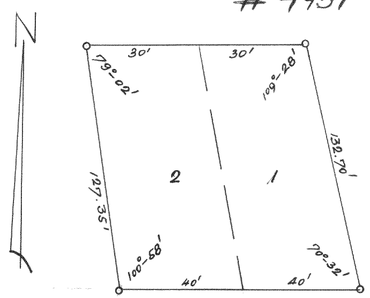

PLAT OF SURVEY

OF LOTS 1 & 2 BLK. 1

NORTH LAKE SHORE WOODS

SEPT. 1968

Floyd L Jensen
Co. SURVEYOR

o = CONC. MONU. SET

SURVEY OF PARCEL IN

THE N½ S½ SEC 25-4-16

MAY 1970

Floyd L Jensen
Co. SURVEYOR

#4952

