
#4954

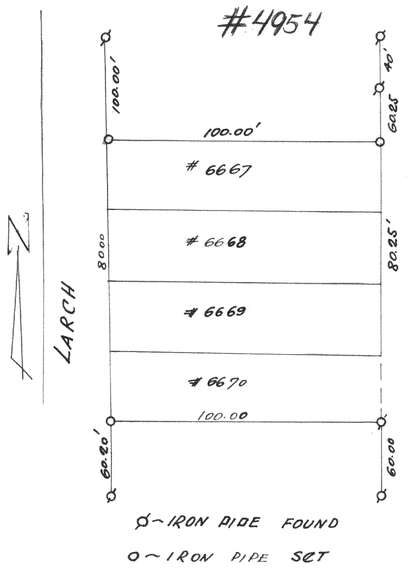

⊘ - IRON PIPE FOUND

O - IRON PIPE SET

PLAT OF SURVEY OF
LOTS 6667 TO 6670 LAKE
COMO BEACH SUBD.
T2N R17E, WAL. Co. WIS.
JULY 1969

Floyd L. Jensen
Co. SURVEYOR

#4955

PLAT OF SURVEY OF
MONTSMA FARM LOCATED IN
SEC. 5+8, T2N R17E,
WAL. Co. WIS.
MAR. 1969

Floyd L. Jensen
Co. SURVEYOR

