

#3003

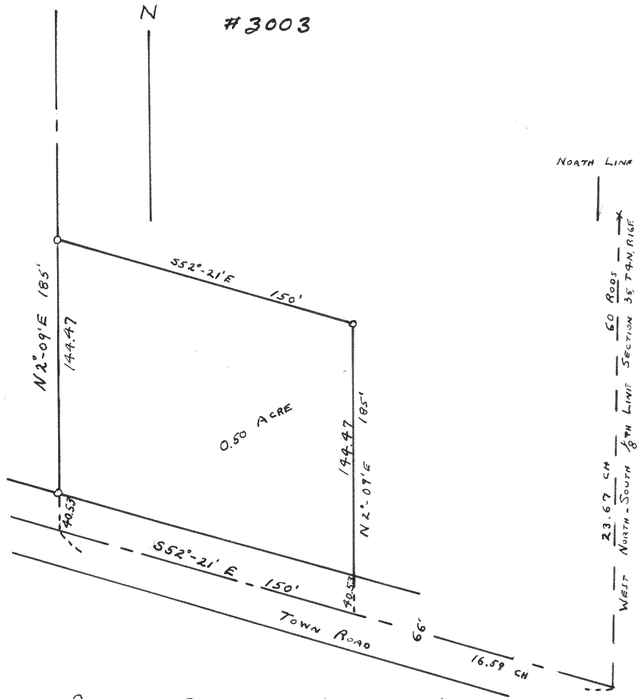


PLAT OF SURVEY OF LAND IN NORTHWEST 1/4
SECTION 36, T4N, R16E WALWORTH COUNTY,
WISCONSIN.
MARCH 1954 LLOYD L. JENSEN
COUNTY SURVEYOR

#3004

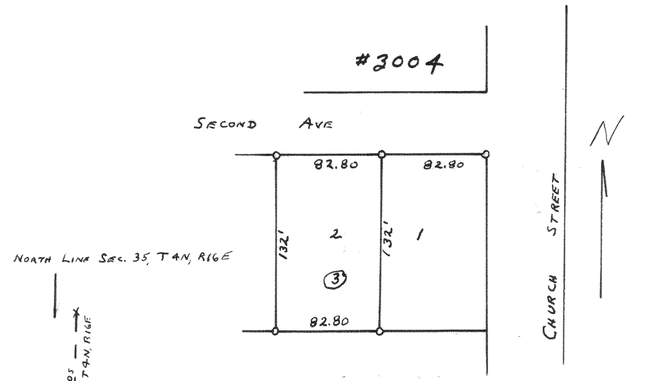

PLAT OF SURVEY OF LOT 2, BLOCK 3
STANFORD'S ADDITION CITY OF ELKHORN
WALWORTH COUNTY WISCONSIN
OCT. 1954 LLOYD L. JENSEN
COUNTY SURVEYOR


#3005

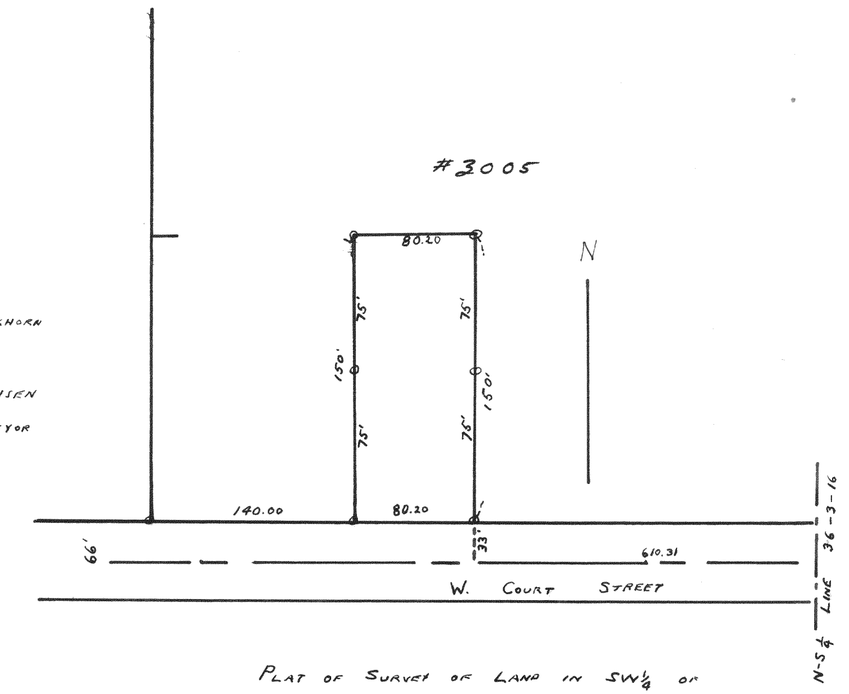


PLAT OF SURVEY OF LAND IN SW1/4 OF
SECTION 36, T3N, R16E WALWORTH COUNTY,
WISCONSIN.
SEPTEMBER 1954 LLOYD L. JENSEN
COUNTY SURVEYOR

#3006

PLAT OF SURVEY OF LAND IN SOUTHWEST 1/4 OF
SECTION 36, T3N, R16E WALWORTH COUNTY, WIS.
APRIL 1954 LLOYD L. JENSEN
COUNTY SURVEYOR

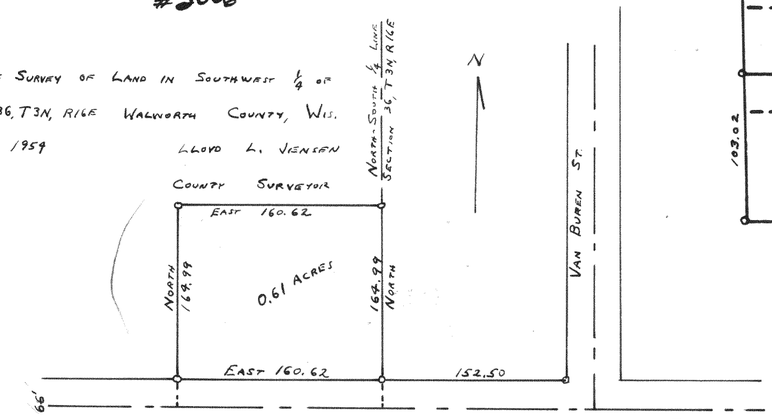

#3007

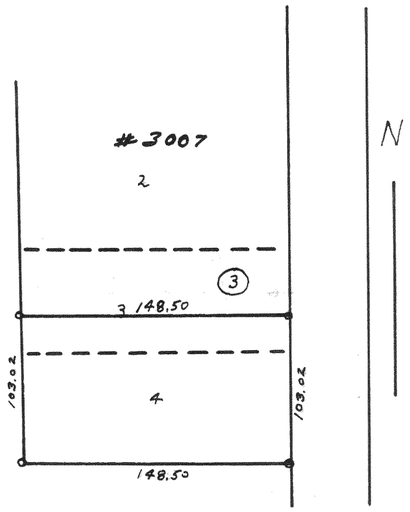

PLAT OF SURVEY OF LOT 4 AND SOUTH 28.02 FEET OF
LOT 3 BLOCK 3 RIDGEWAY AND MARTINS ADDITION
CITY OF ELKHORN, WALWORTH COUNTY, WISCONSIN
NOVEMBER 1954 LLOYD L. JENSEN
COUNTY SURVEYOR