
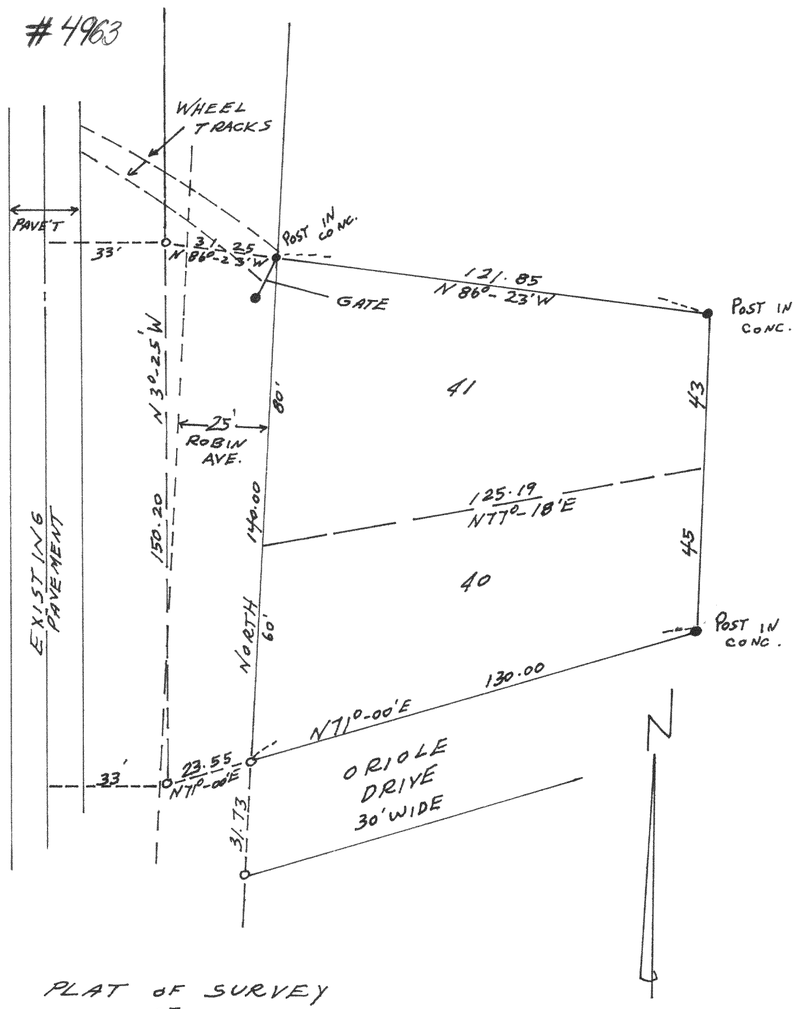



PLAT OF SURVEY
OF

LAND WEST OF FROEDTERT'S GREEN LAKE PARK NW 1/4 SECTION 26, T4N-R18E WALWORTH CO., WIS.

JULY 11, 1969

Floyd L. Jensen
COUNTY SURVEYOR

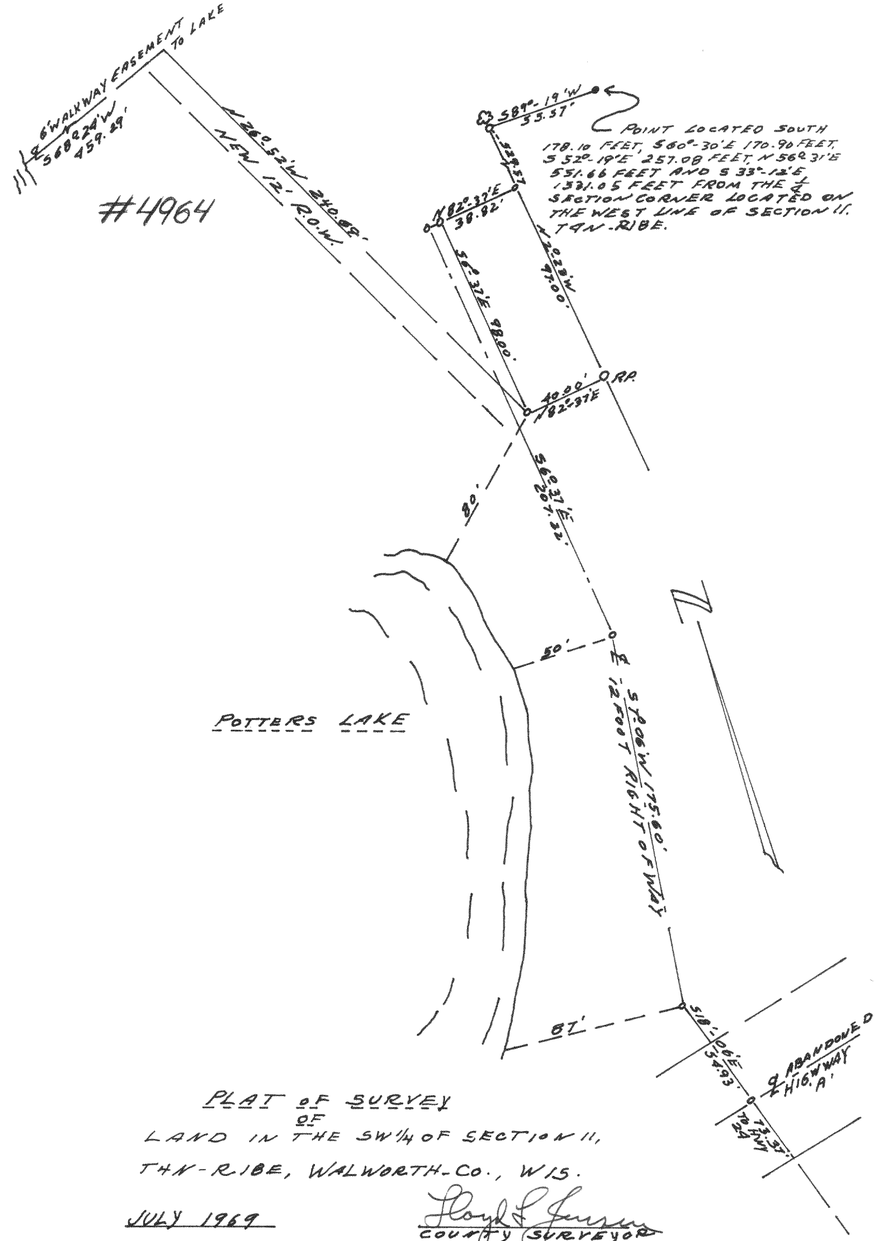


PLAT OF SURVEY
OF
LAND IN THE SW 1/4 OF SECTION 11, T4N-R18E, WALWORTH CO., WIS.

JULY 1969

Floyd L. Jensen
COUNTY SURVEYOR