

#3027

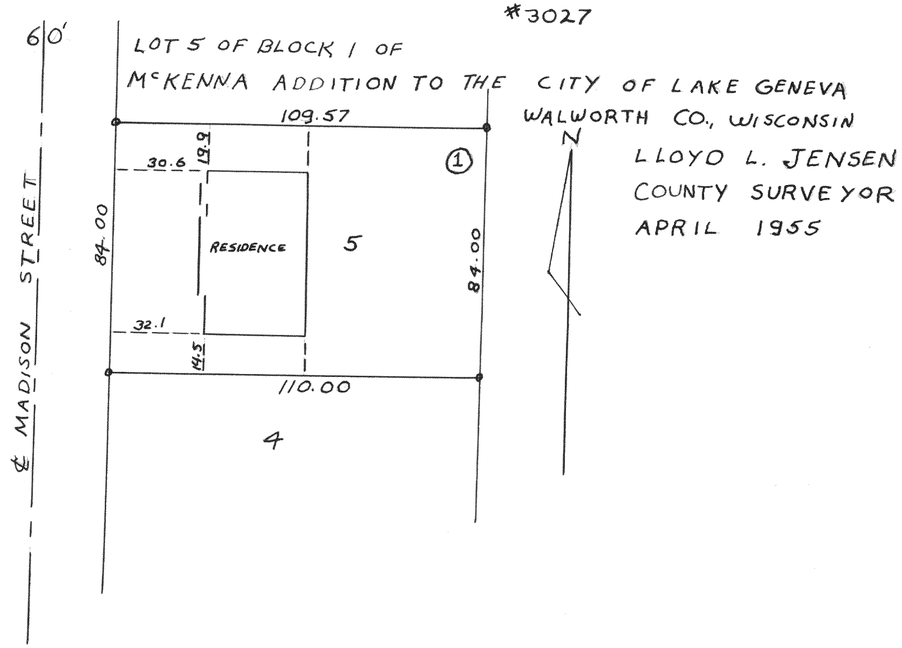

#3028

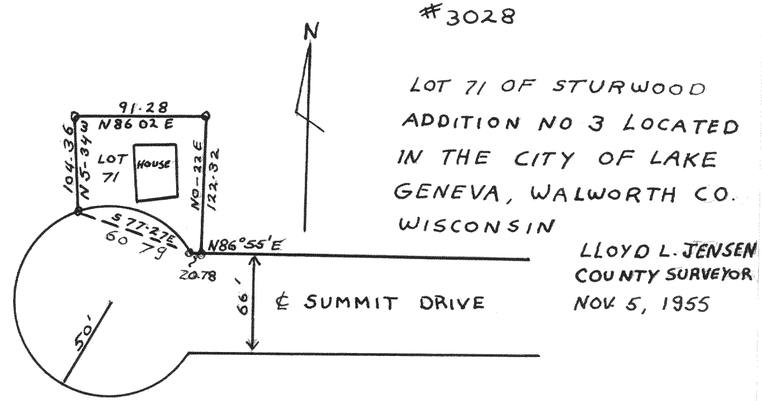

LOT 71 OF STURWOOD ADDITION NO 3 LOCATED IN THE CITY OF LAKE GENEVA, WALWORTH CO. WISCONSIN

#3029

