DUNHAM SURVEYING, S.C.
SURVEYING & SUBDIVIDING
DELAVAN, WISCONSIN 53115

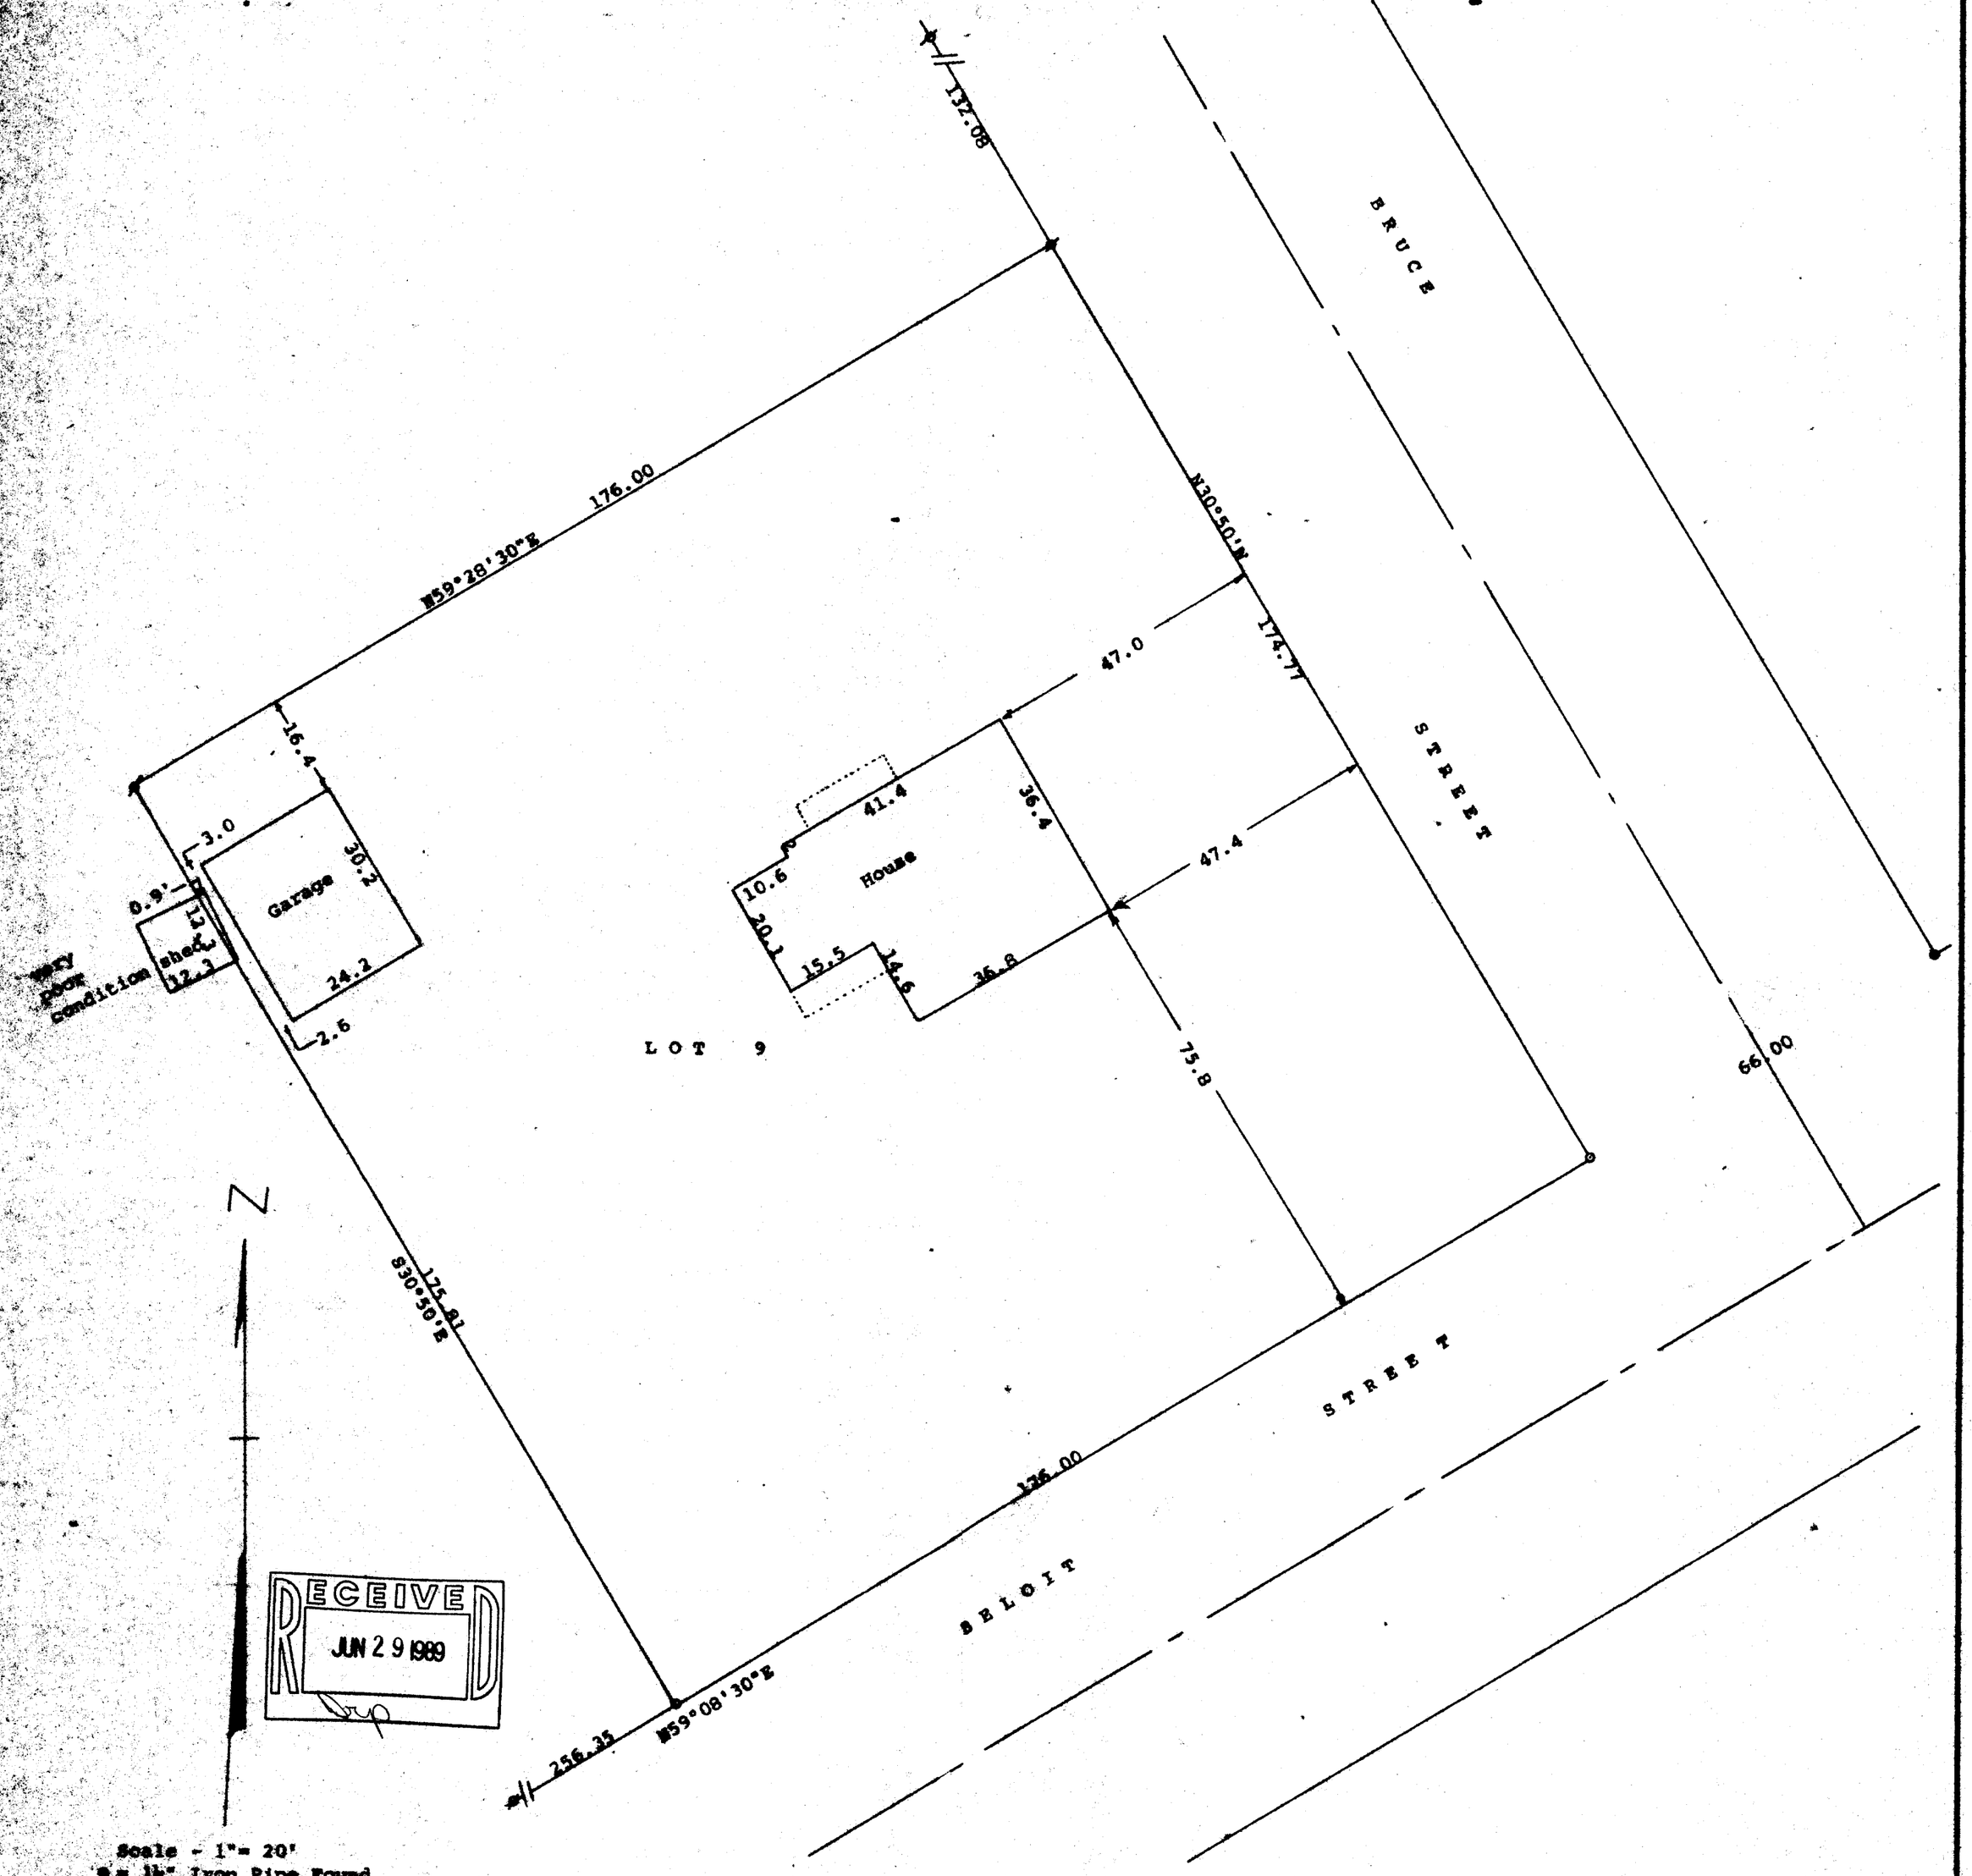

RECEIVED
JUN 29 1989

Scale - 1"= 20'
● = 1¼" Iron Pipe Found
⊗ = 1" Iron Pipe Found
○ = 1" Iron Pipe Set
Bearings referenced to the previously assumed bearing of S30°50'E along the southwesterly line of Lot 9
Survey ordered by: Danielson & Osman
25North Wisconsin Street
Darien, WI 53114

STATE OF WISCONSIN)
COUNTY OF WALWORTH) SS

I, George T. Dunham, Surveyor, certify that I have surveyed the property described as follows:

Lot 9, Block 24, John Bruce's Addition to the Village of Darien, Walworth County, Wisconsin,

and that the plat shown hereon is a correct representation thereof and shows the size and location of the property, its exterior boundaries, the location of all visible structures and dimensions of all principal buildings thereon, boundary fences, apparent easements, roadways and visible encroachments, if any, and that I have surveyed the property hereon described, according to the official records, to the best of my knowledge and belief.

March 15, 1989

George T. Dunham, Surveyor

WISCONSIN LAND SURVEYOR
GEORGE T. DUNHAM
S-306
DELAVAN WIS.

1-219