


PLAT OF SURVEY

LOT 2 OF CERTIFIED SURVEY MAP No. 2638, RECORDED IN VOLUME 13 ON PAGE 192 - 193, BEING PART OF THE S.W. 1/4 OF THE N.W. 1/4 OF SECTION 27 AND PART OF THE S.E. 1/4 OF THE N.E. 1/4 OF SECTION 28, T. 2 N., R. 15 E. OF THE 4TH P.M., VILLAGE OF DARIEN, WALWORTH COUNTY, WISCONSIN.

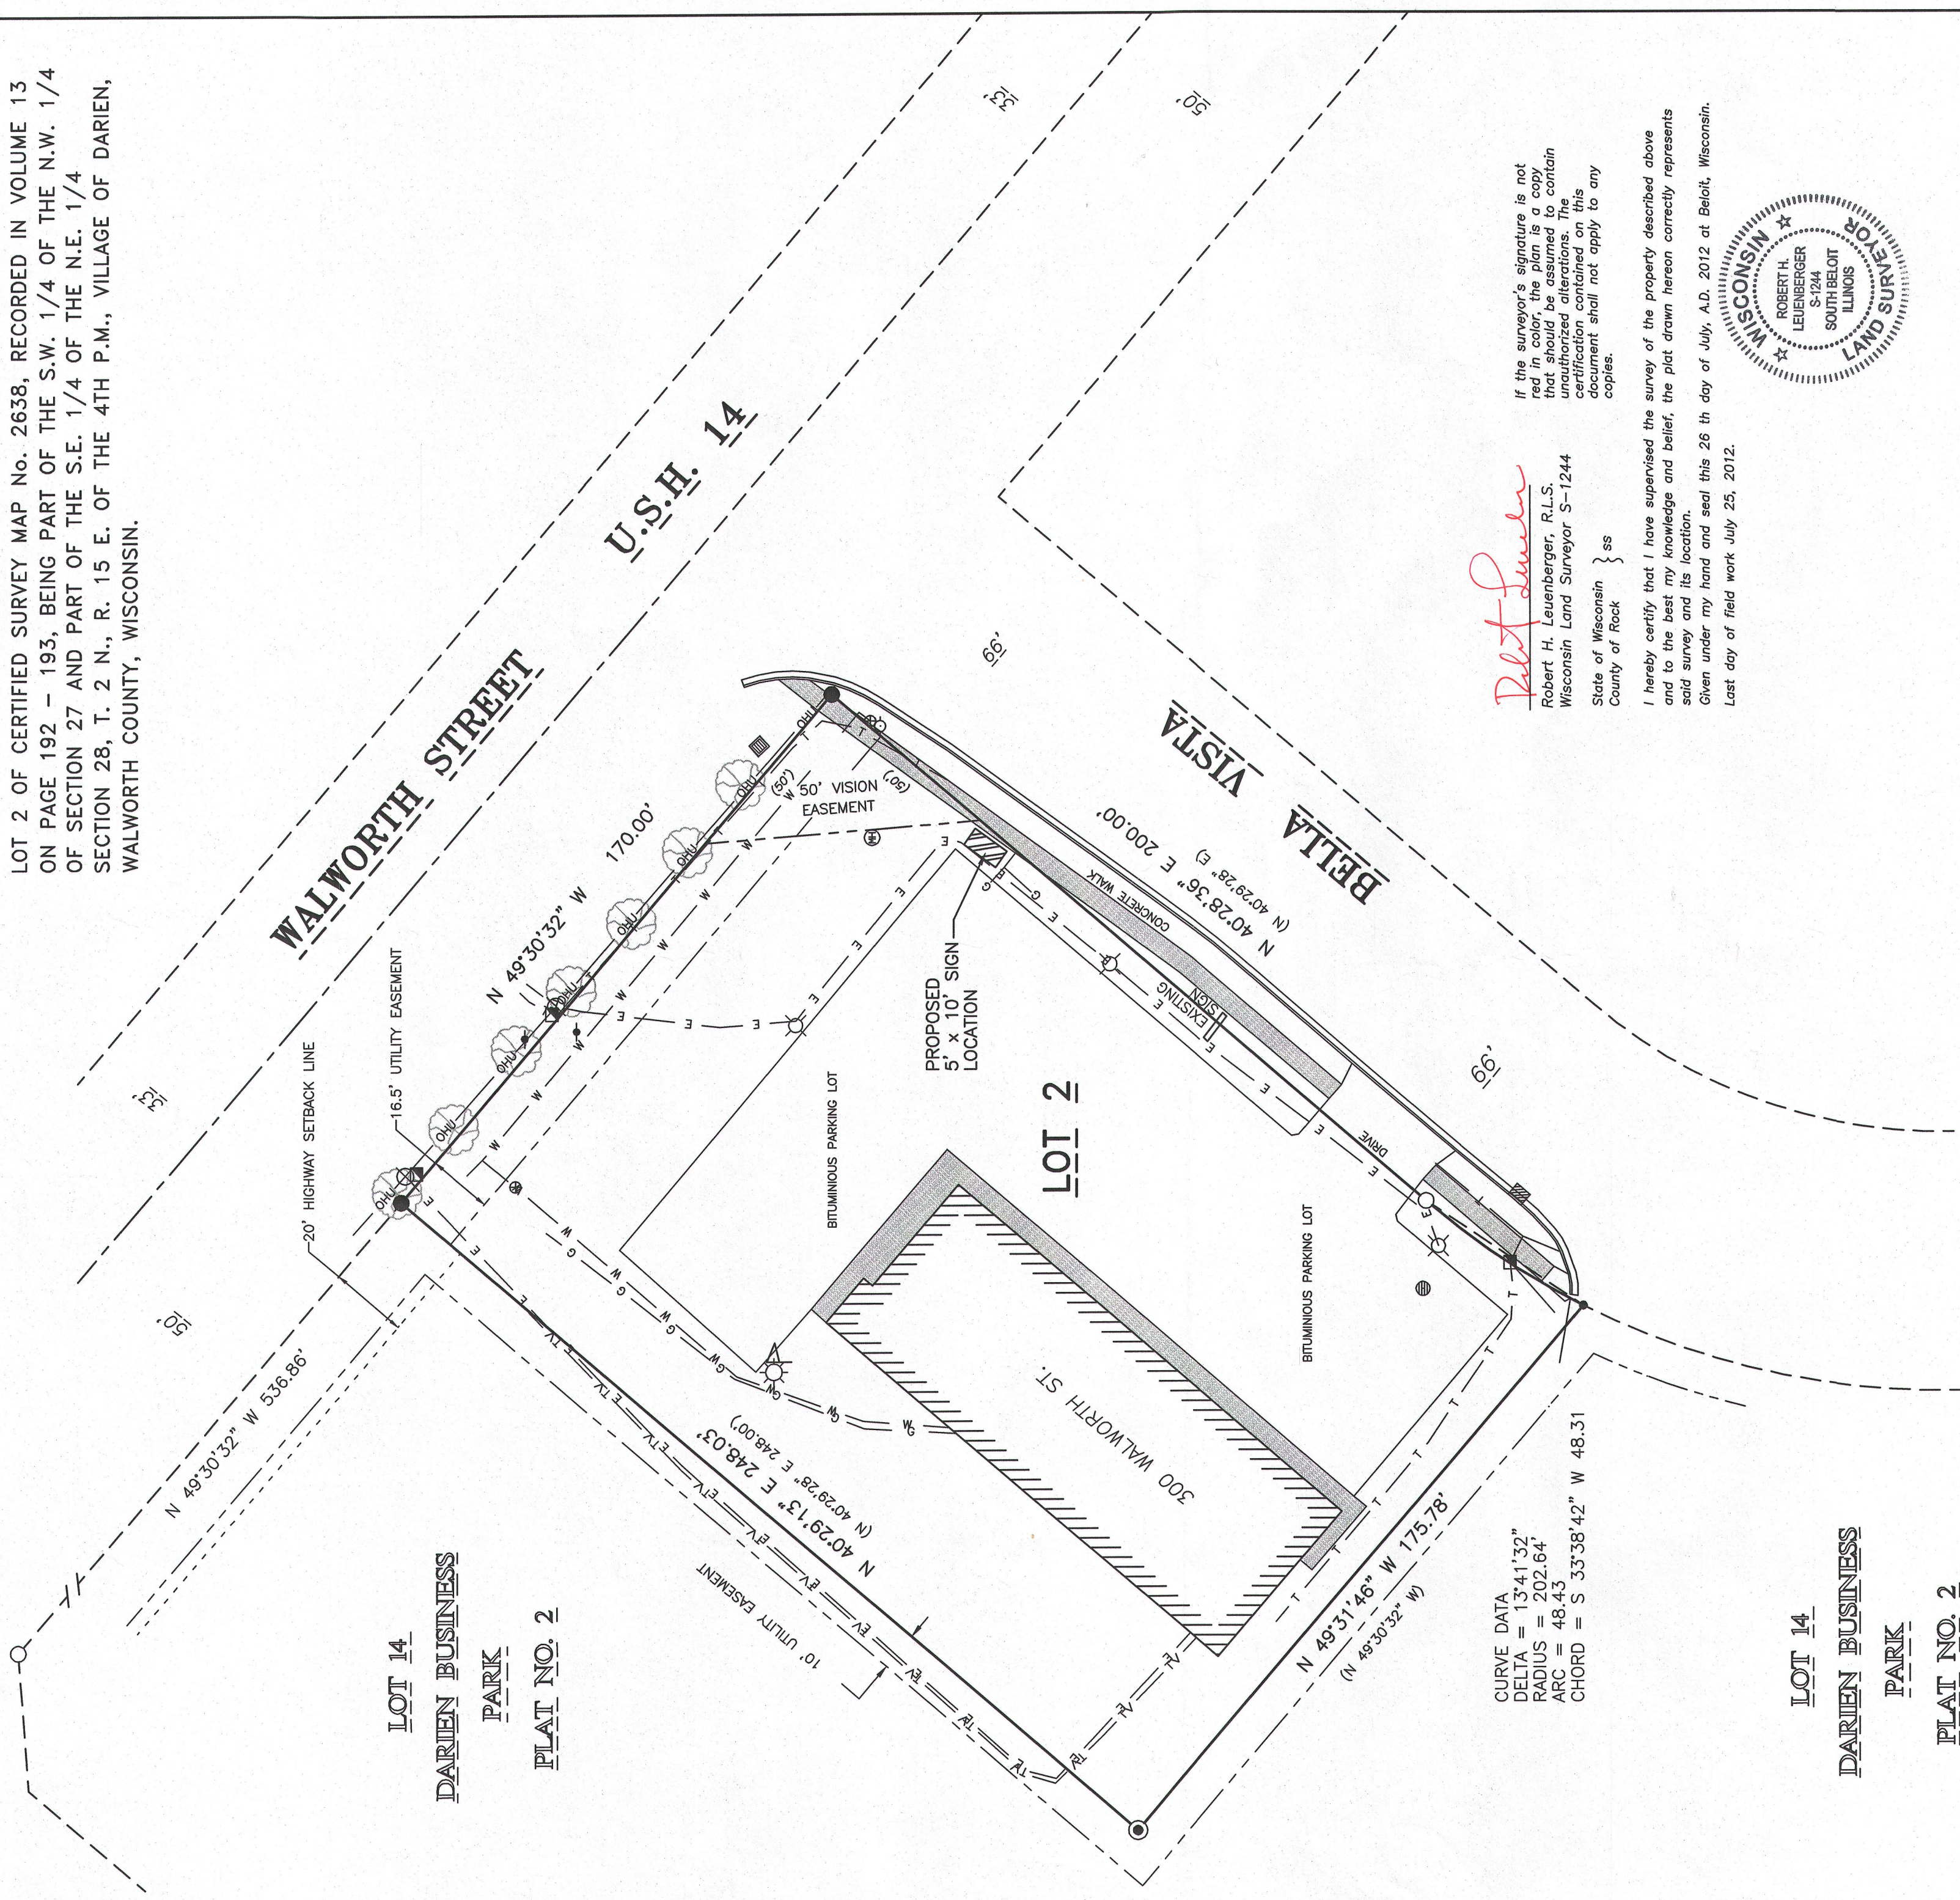


CURVE DATA
DELTA = 13°41'32"
RADIUS = 202.64'
ARC = 48.43
CHORD = S 33°38'

If the surveyor's signature is not red in color, the plan is a copy that should be assumed to contain unauthorized alterations. The certification contained on this document shall not apply to any copies.


I hereby certify that I have supervised the survey of the property described above and to the best my knowledge and belief, the plat drawn hereon correctly represents said survey and its location.

Given under my hand and seal this 26 th day of July, A.D. 2012 at Beloit, Wisconsin.

Last day of field work July 25, 2012.

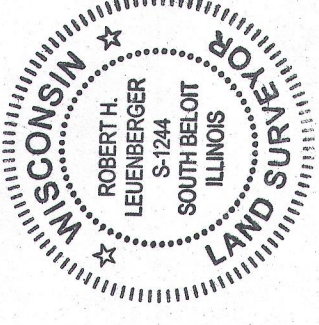

LOT 14
DARIEN BUSINESS
PARK
PLAT NO. 2

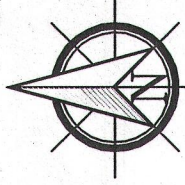

SCALE: 1" = 30'

0 15 30 60
BEARINGS ARE BASED UPON THE NORTH LINE OF LOT 2
C.S.M. #2638 VOL. 13 PG. 192 BEING S 49°30'32" E

ORDER NO. 31397

**FOR THE EXCLUSIVE USE OF:
BELOIT HEALTH SYSTEM**

BOOK 552 PAGE 39

File Name: J:\31351-31399\31397 Beloit Health System\31397.DWG
Plotted on 07/26/12 at 15:05:10.

MONUMENT KEY

—●— Iron Rebar Set
3/4" x 24" (1.5 Lbs./Ft.)

—●— MAG Nail Set

—○— 3/4" Iron Rebar Found

—○— 1 1/4" Pin Found

☒ TELEPHONE PEDESTAL

☼ GROUND LIGHT ✂ LIGHTPOLE

—●— GUY WIRE Ø UTILITY POLE

⊕ WATER VALVE

 COILS INLET
 ROLL INLET

 SQUARE INLET

MANHOLE

UNDERGROUND CABLE IN
UNDERGROUND ELECTRIC

UNDERGROUND GAS LINE

OVERHEAD UTILITIES

UNDERGROUND PHONE LINE

UNDERGROUND WATER LINE

RECEIVED
AUG 8 2013
By id

ORDER NO. 31397

**FOR THE EXCLUSIVE USE OF:
BELOIT HEALTH SYSTEM**

BOOK 552 PAGE 39

File Name: J:\31351-31399\31397 Beloit Health System\31397.DWG
Plotted on 07/26/12 at 15:05:10.

Batterman
engineers surveyors planners

2857 Bartells Drive
608.365.4464
Beloit, Wisconsin 53511
www.rhbatterman.com

QA2638—2 001-577