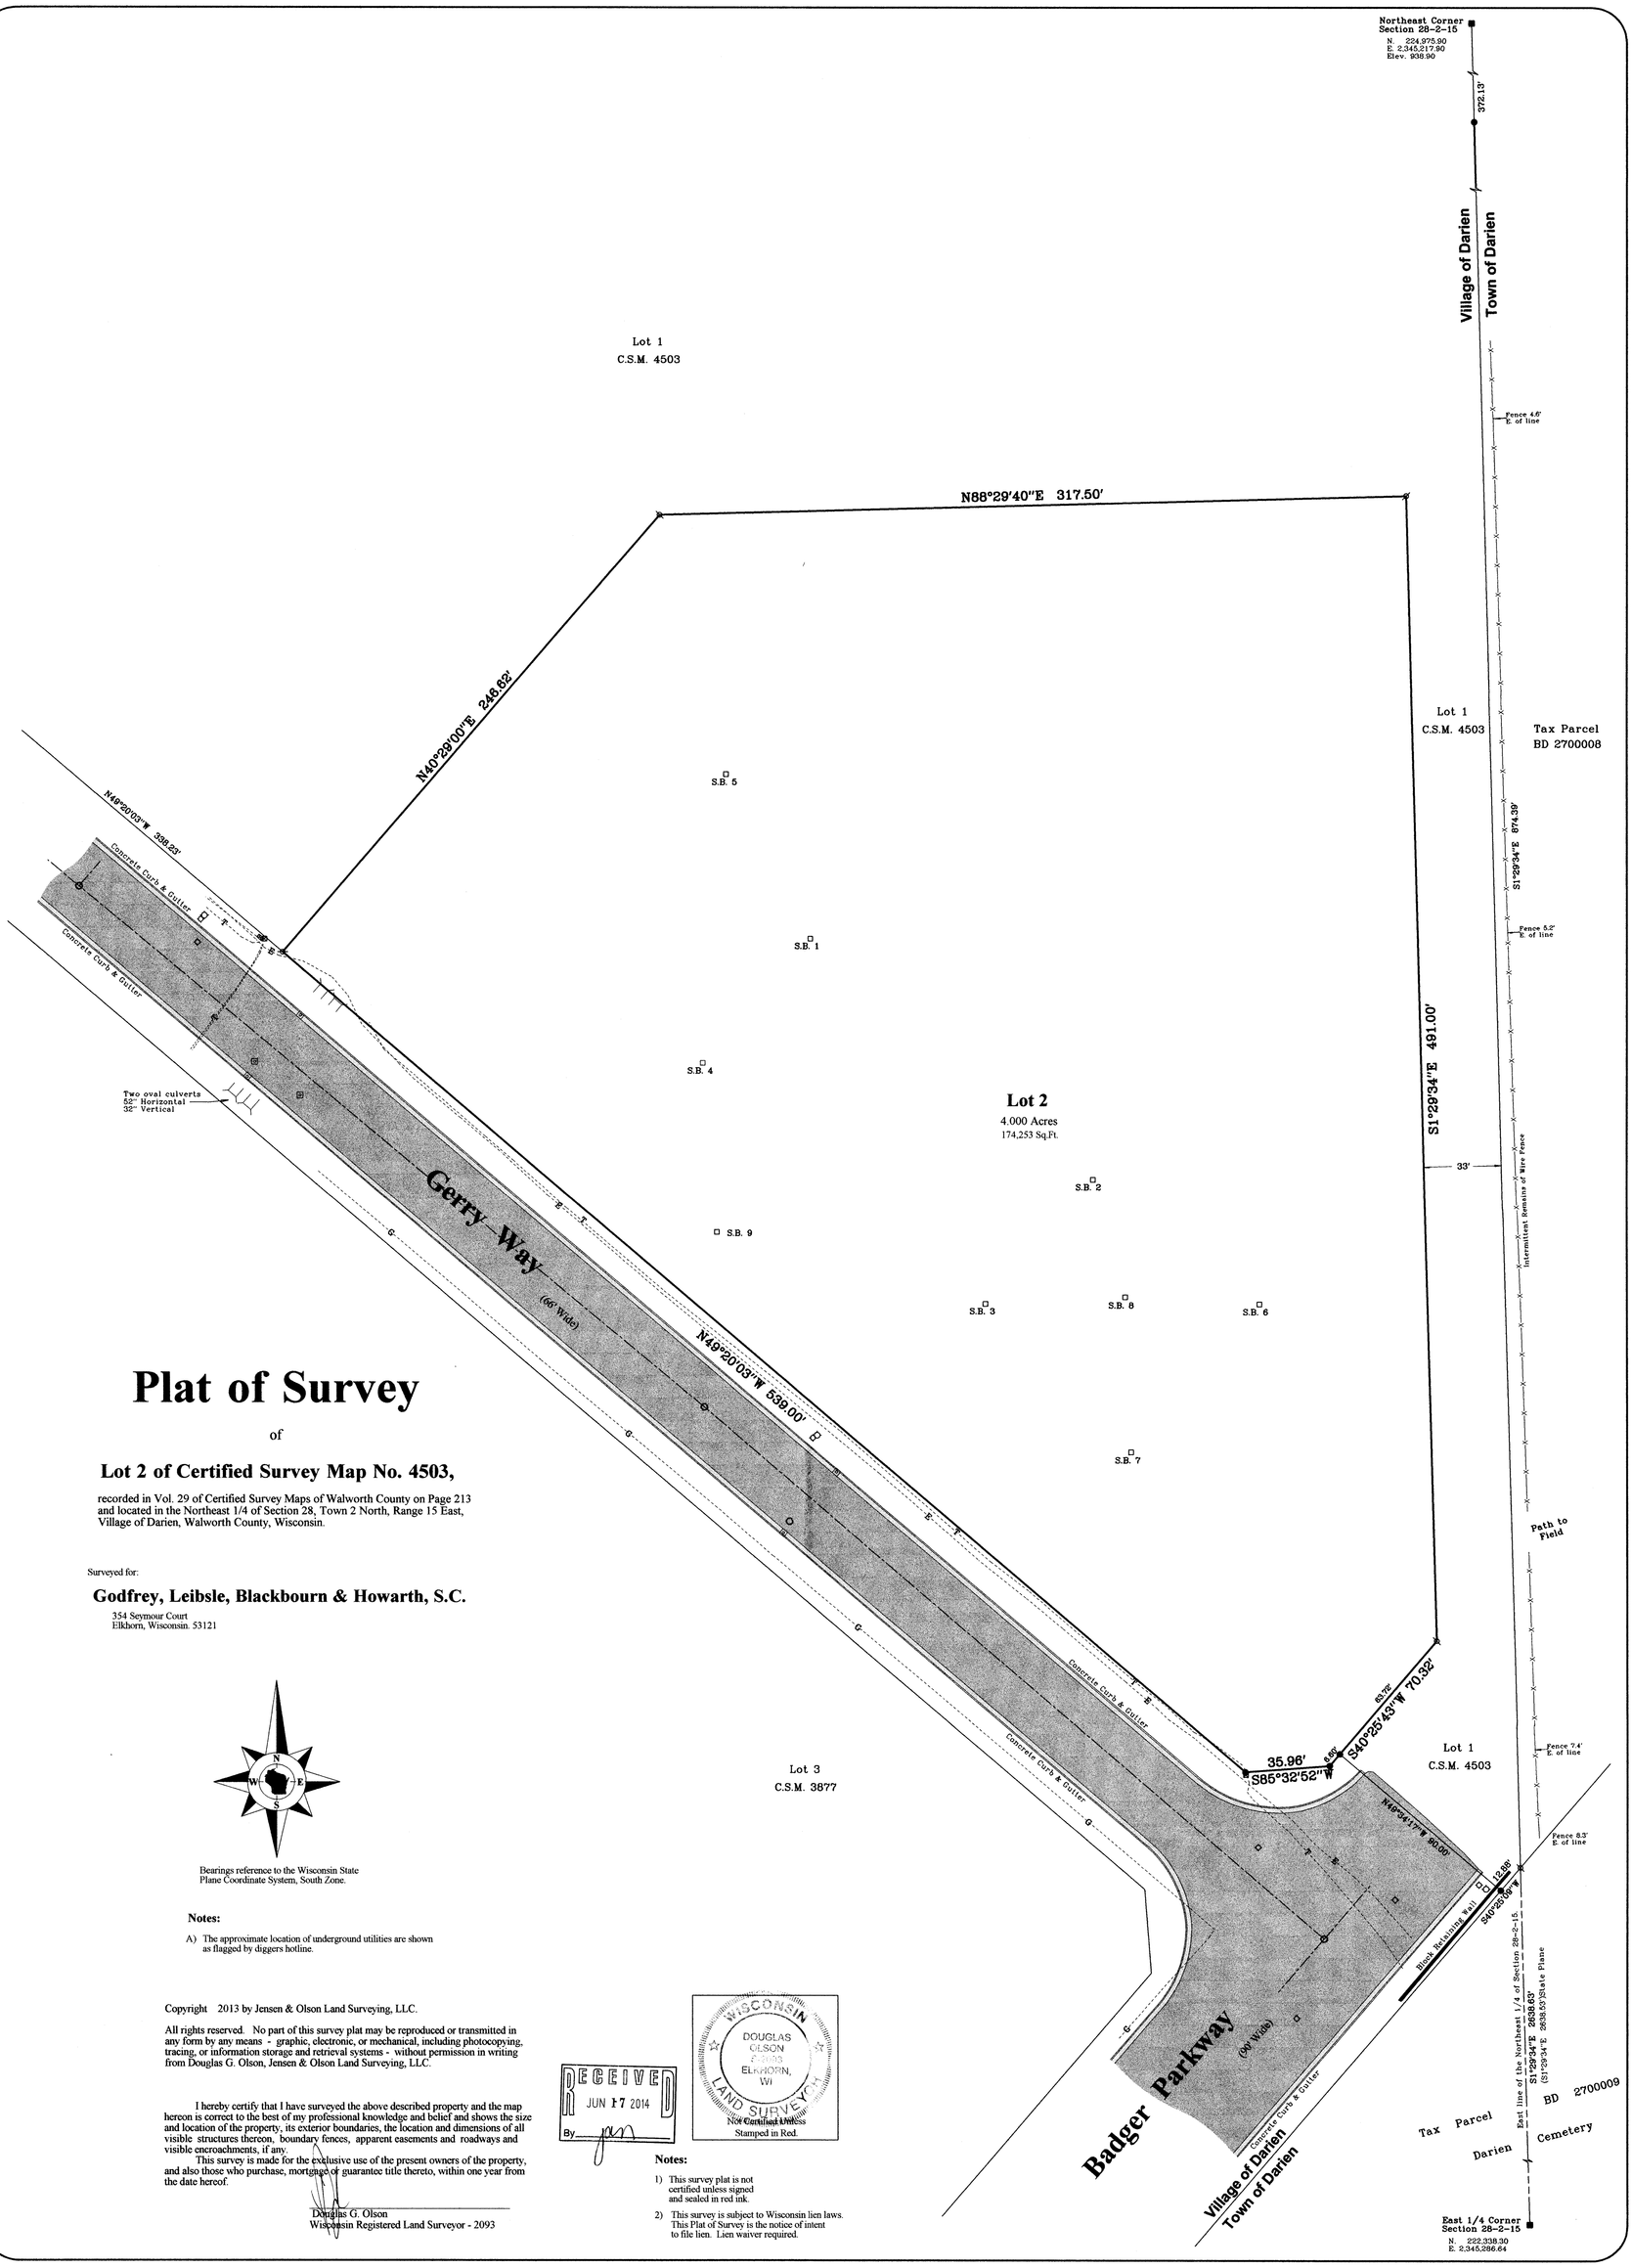

Plat of Survey

of

Lot 2 of Certified Survey Map No. 4503,

recorded in Vol. 29 of Certified Survey Maps of Walworth County on Page 213 and located in the Northeast 1/4 of Section 28, Town 2 North, Range 15 East, Village of Darien, Walworth County, Wisconsin.

Surveyed for:

Godfrey, Leibsle, Blackbourn & Howarth, S.C.

354 Seymour Court
Elkhorn, Wisconsin. 53121

Bearings reference to the Wisconsin State Plane Coordinate System, South Zone.

Notes:

A) The approximate location of underground utilities are shown as flagged by diggers hotline.

Copyright 2013 by Jensen & Olson Land Surveying, LLC.

All rights reserved. No part of this survey plat may be reproduced or transmitted in any form by any means - graphic, electronic, or mechanical, including photocopying, tracing, or information storage and retrieval systems - without permission in writing from Douglas G. Olson, Jensen & Olson Land Surveying, LLC.

I hereby certify that I have surveyed the above described property and the map hereon is correct to the best of my professional knowledge and belief and shows the size and location of the property, its exterior boundaries, the location and dimensions of all visible structures thereon, boundary fences, apparent easements and roadways and visible encroachments, if any.

This survey is made for the exclusive use of the present owners of the property, and also those who purchase, mortgage or guarantee title thereto, within one year from the date hereof.

Douglas G. Olson
Wisconsin Registered Land Surveyor - 2093

RECEIVED
JUN 17 2014
By

WISCONSIN
DOUGLAS OLSON
2093
ELKHORN, WI
LAND SURVEYOR
Not Certified Unless Stamped in Red.

Notes:

1) This survey plat is not certified unless signed and sealed in red ink.

2) This survey is subject to Wisconsin lien laws. This Plat of Survey is the notice of intent to file lien. Lien waiver required.

2013.110

Sheet 1 of 1 Sheets

Drawing Name: t2nr15c-2013110-2013110Plat.scj

Job Reference Number

2013.110

Legend

- Found County Section Corner
- Found Iron Pipe
- Found Iron Rod
- Set Wood Lath - Soil Boring Location
- ( ) Recorded Information
- Fire Hydrant
- Water Valve
- Utility Box or Pedestal — See Note A Above
- Manhole — Underground Utilities
- Catch Basin — -E- Electric Line
- Asphalt Surface — -G- Gas Line
- Concrete Surface — -T- Telephone Line

Jensen & Olson Land Surveying, LLC

45 South Wisconsin Street * P.O. Box 322 * Elkhorn, Wisconsin. 53121
Telephone: (262) 723-3434 * Facsimile: (262) 723-8044
Email: jensen.olson@elknet.net

Scale in Feet

1" = 30'

0' 15' 30' 60' 90'

Survey date: December 17, 2013.
Revisions: No. 1 - Legal

GA4503-2 001-581