

LAND-MARK SURVEYING

Mark L. Miritz

Wisconsin Professional Land Surveyor S-2582



N9330 Knuteson Drive
Whitewater, WI 53190
Phone: (262) 495-3284
MARKMIRITZ@
LAND-MARKSURVEYING.COM

PLAT OF SURVEY

LOT 4 OF CERTIFIED SURVEY MAP NO. 1986, LOCATED
IN THE EAST 1/2 OF SECTION 27, TOWN 2 NORTH,
RANGE 15 EAST, VILLAGE OF DARIEN, WALWORTH
COUNTY, WISCONSIN.

OWNER: SUNRISE GARDENS LLC
203 E. BELOIT STREET
DARIEN, WI 53114

BELOIT STREET A.K.A. C.T.H. "X"

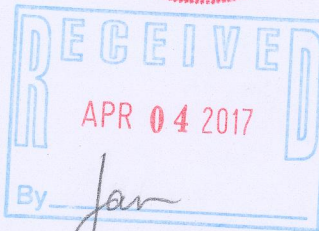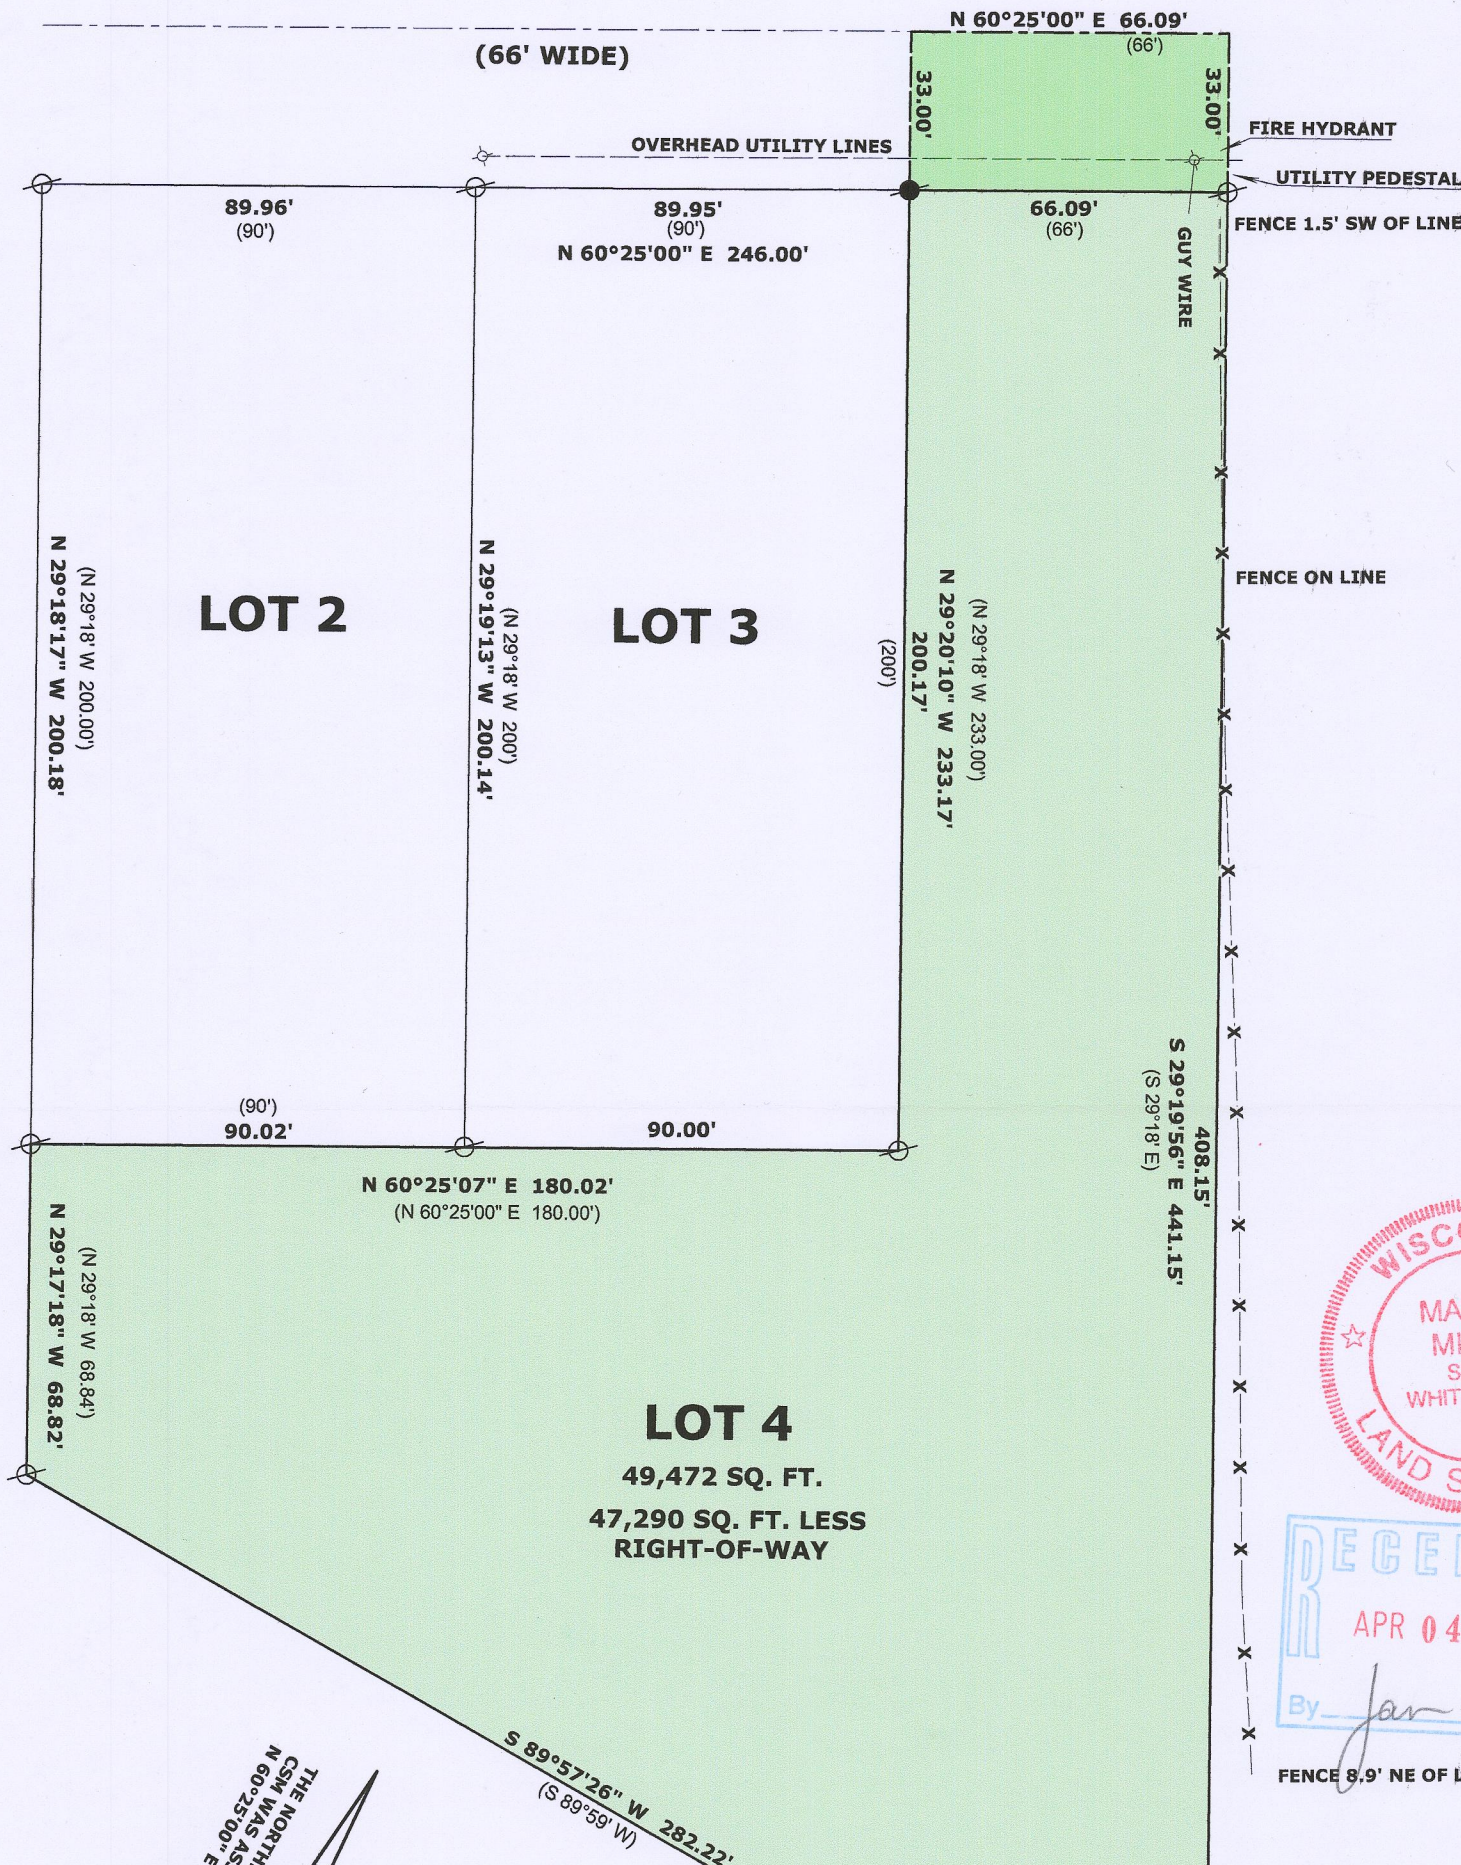

QA1986-4 001-603