PLAT OF SURVEY

LOTS 14 OF DARIEN BUSINESS PARK PLAT NO. 2

LOCATED IN PART OF THE SW 1/4 OF THE NW 1/4 OF SECTION 27 AND PART OF THE SE 1/4 OF THE NE 1/4 OF SECTION 28, TOWN 2 NORTH, RANGE 15 EAST, VILLAGE OF DARIEN, WALWORTH COUNTY, WISCONSIN

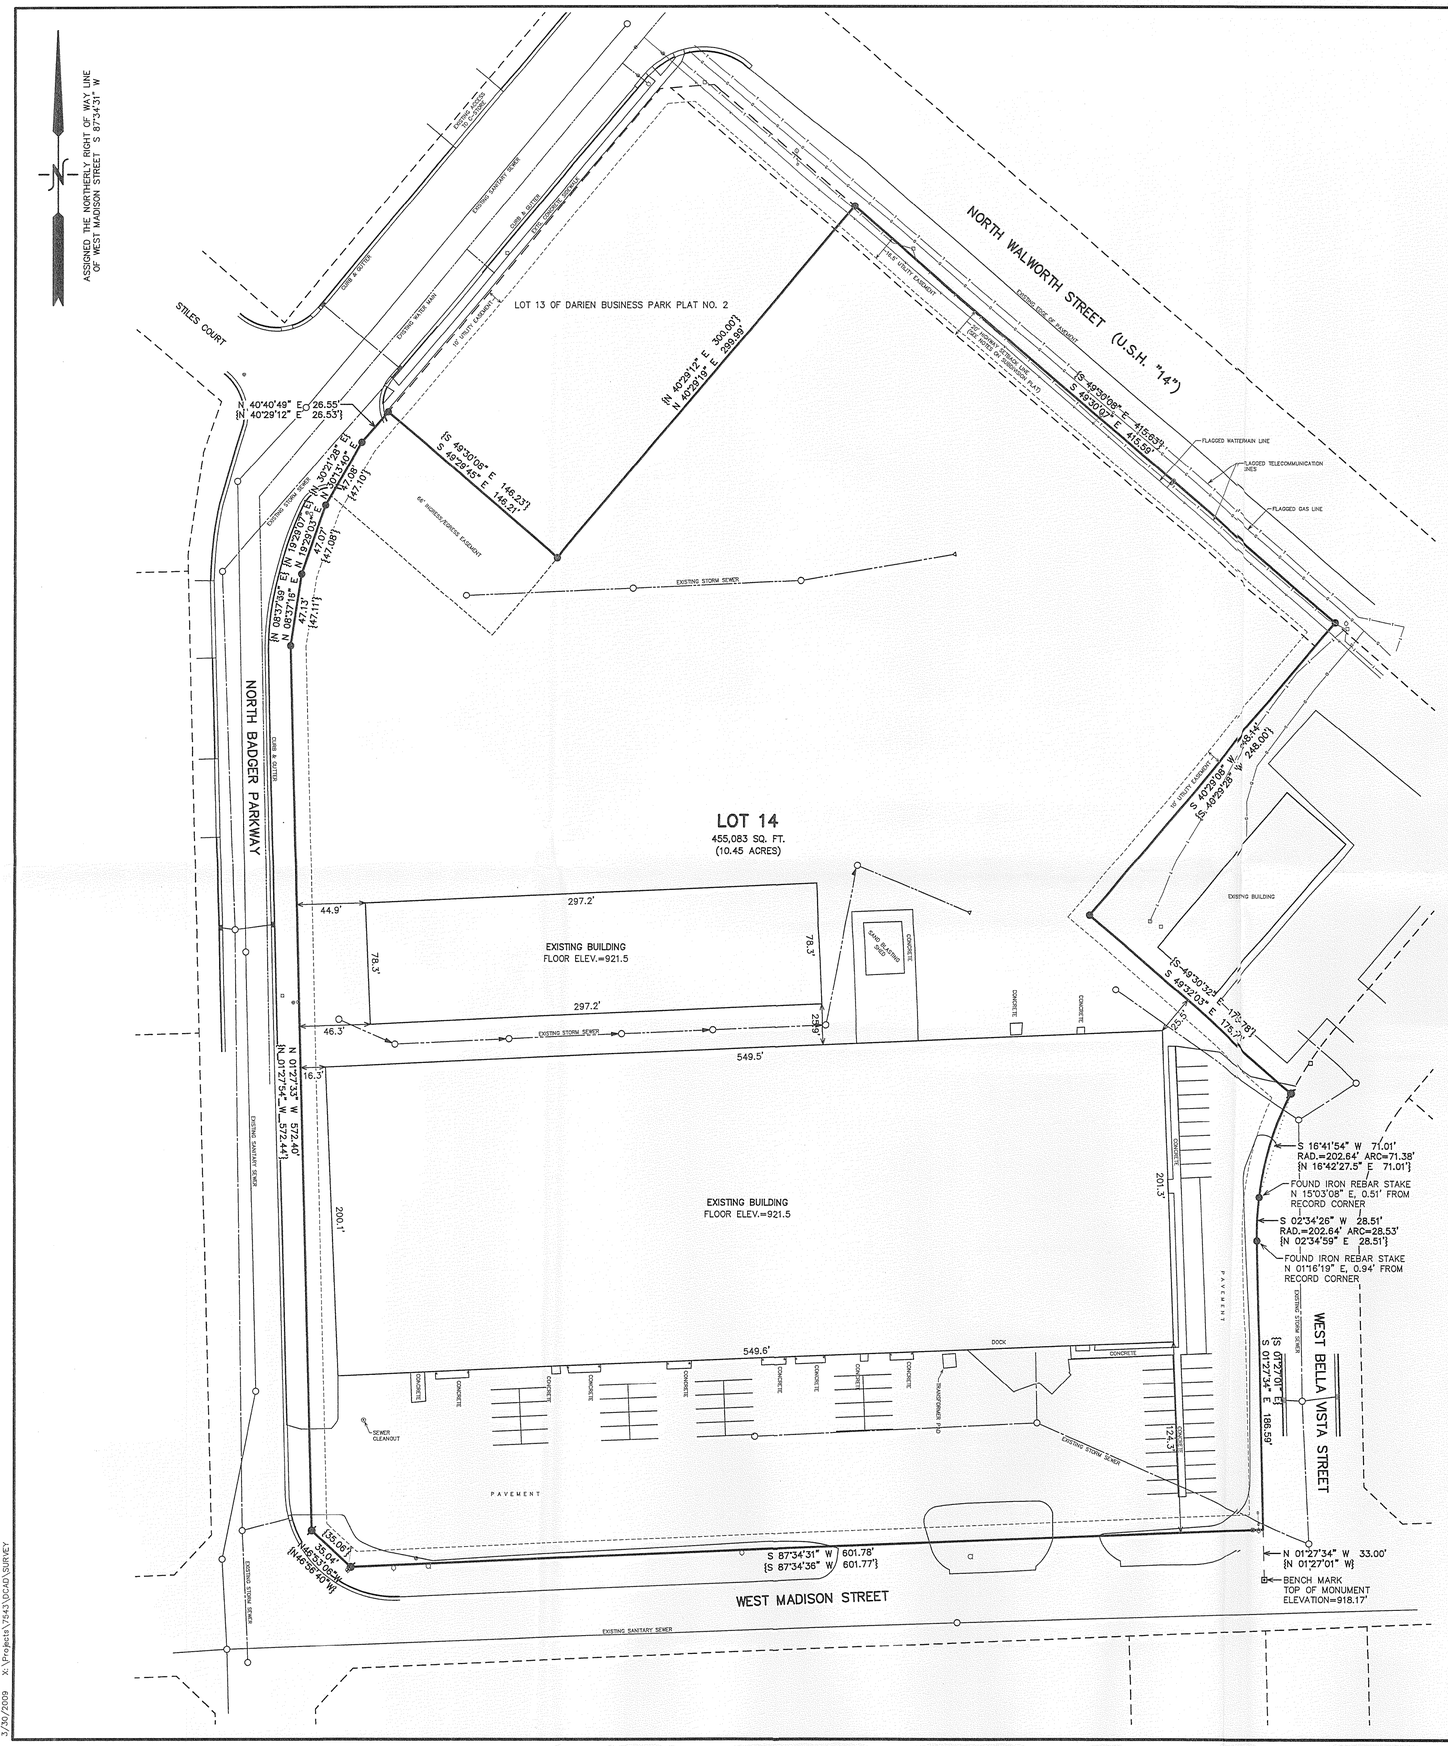

RECEIVED
MAY 19 2009
By SMF

NOTE: COPIES OF THIS MAP TO WHICH THE FOLLOWING CERTIFICATE WILL APPLY SHOW THE SURVEYOR'S ORIGINAL SEAL AND SIGNATURE IN RED INK. COPIES BY ANY OTHER MEANS MAY HAVE ALTERATIONS WHICH DO NOT REPRESENT THE SURVEYOR'S WORK PRODUCT.

I HEREBY CERTIFY THAT THE ABOVE DESCRIBED PROPERTY HAS BEEN SURVEYED UNDER MY DIRECTION AND THAT THE ABOVE MAP IS A TRUE REPRESENTATION THEREOF AND SHOWS THE SIZE AND LOCATION OF THE PROPERTY AND ITS EXTERIOR BOUNDARIES. THIS SURVEY IS MADE FOR THE USE OF THE PRESENT OWNERS OF THE PROPERTY, AND ALSO THOSE WHO PURCHASE, MORTGAGE, OR GUARANTEE THE TITLE THERETO WITHIN ONE YEAR FROM THE DATE HEREOF.

WISCONSIN PETER S. GORDON S-2101 ELKHORN, WI LAND SURVEYOR

DATED: 3/30/2009

PETER S. GORDON R.L.S. 2101

PLAT OF SURVEY

– WORK ORDERED BY –
PROFESSIONAL POWER PRODUCTS
448 W. MADISON STREET
DARIEN, WI 53114

FARRIS, HANSEN & ASSOCIATES, INC.
ENGINEERING – ARCHITECTURE – SURVEYING
7 RIDGWAY COURT P.O. BOX 437
ELKHORN, WISCONSIN 53121
OFFICE: (262) 723-2098 FAX: (262) 723-5886

REVISIONS

PROJECT NO. 7543

DATE 03/30/2009

SHEET NO. 1 OF 1

3/30/2009 X:\Projects\7543\DCAD\SURVEY

QDBP2-2

001-549