


Lot 1
C.S.M. 4503

Village of Darien
Town of Darien


Northeast Corner
Section 28-2-15
E. 234621.790
B.M. 1983.50

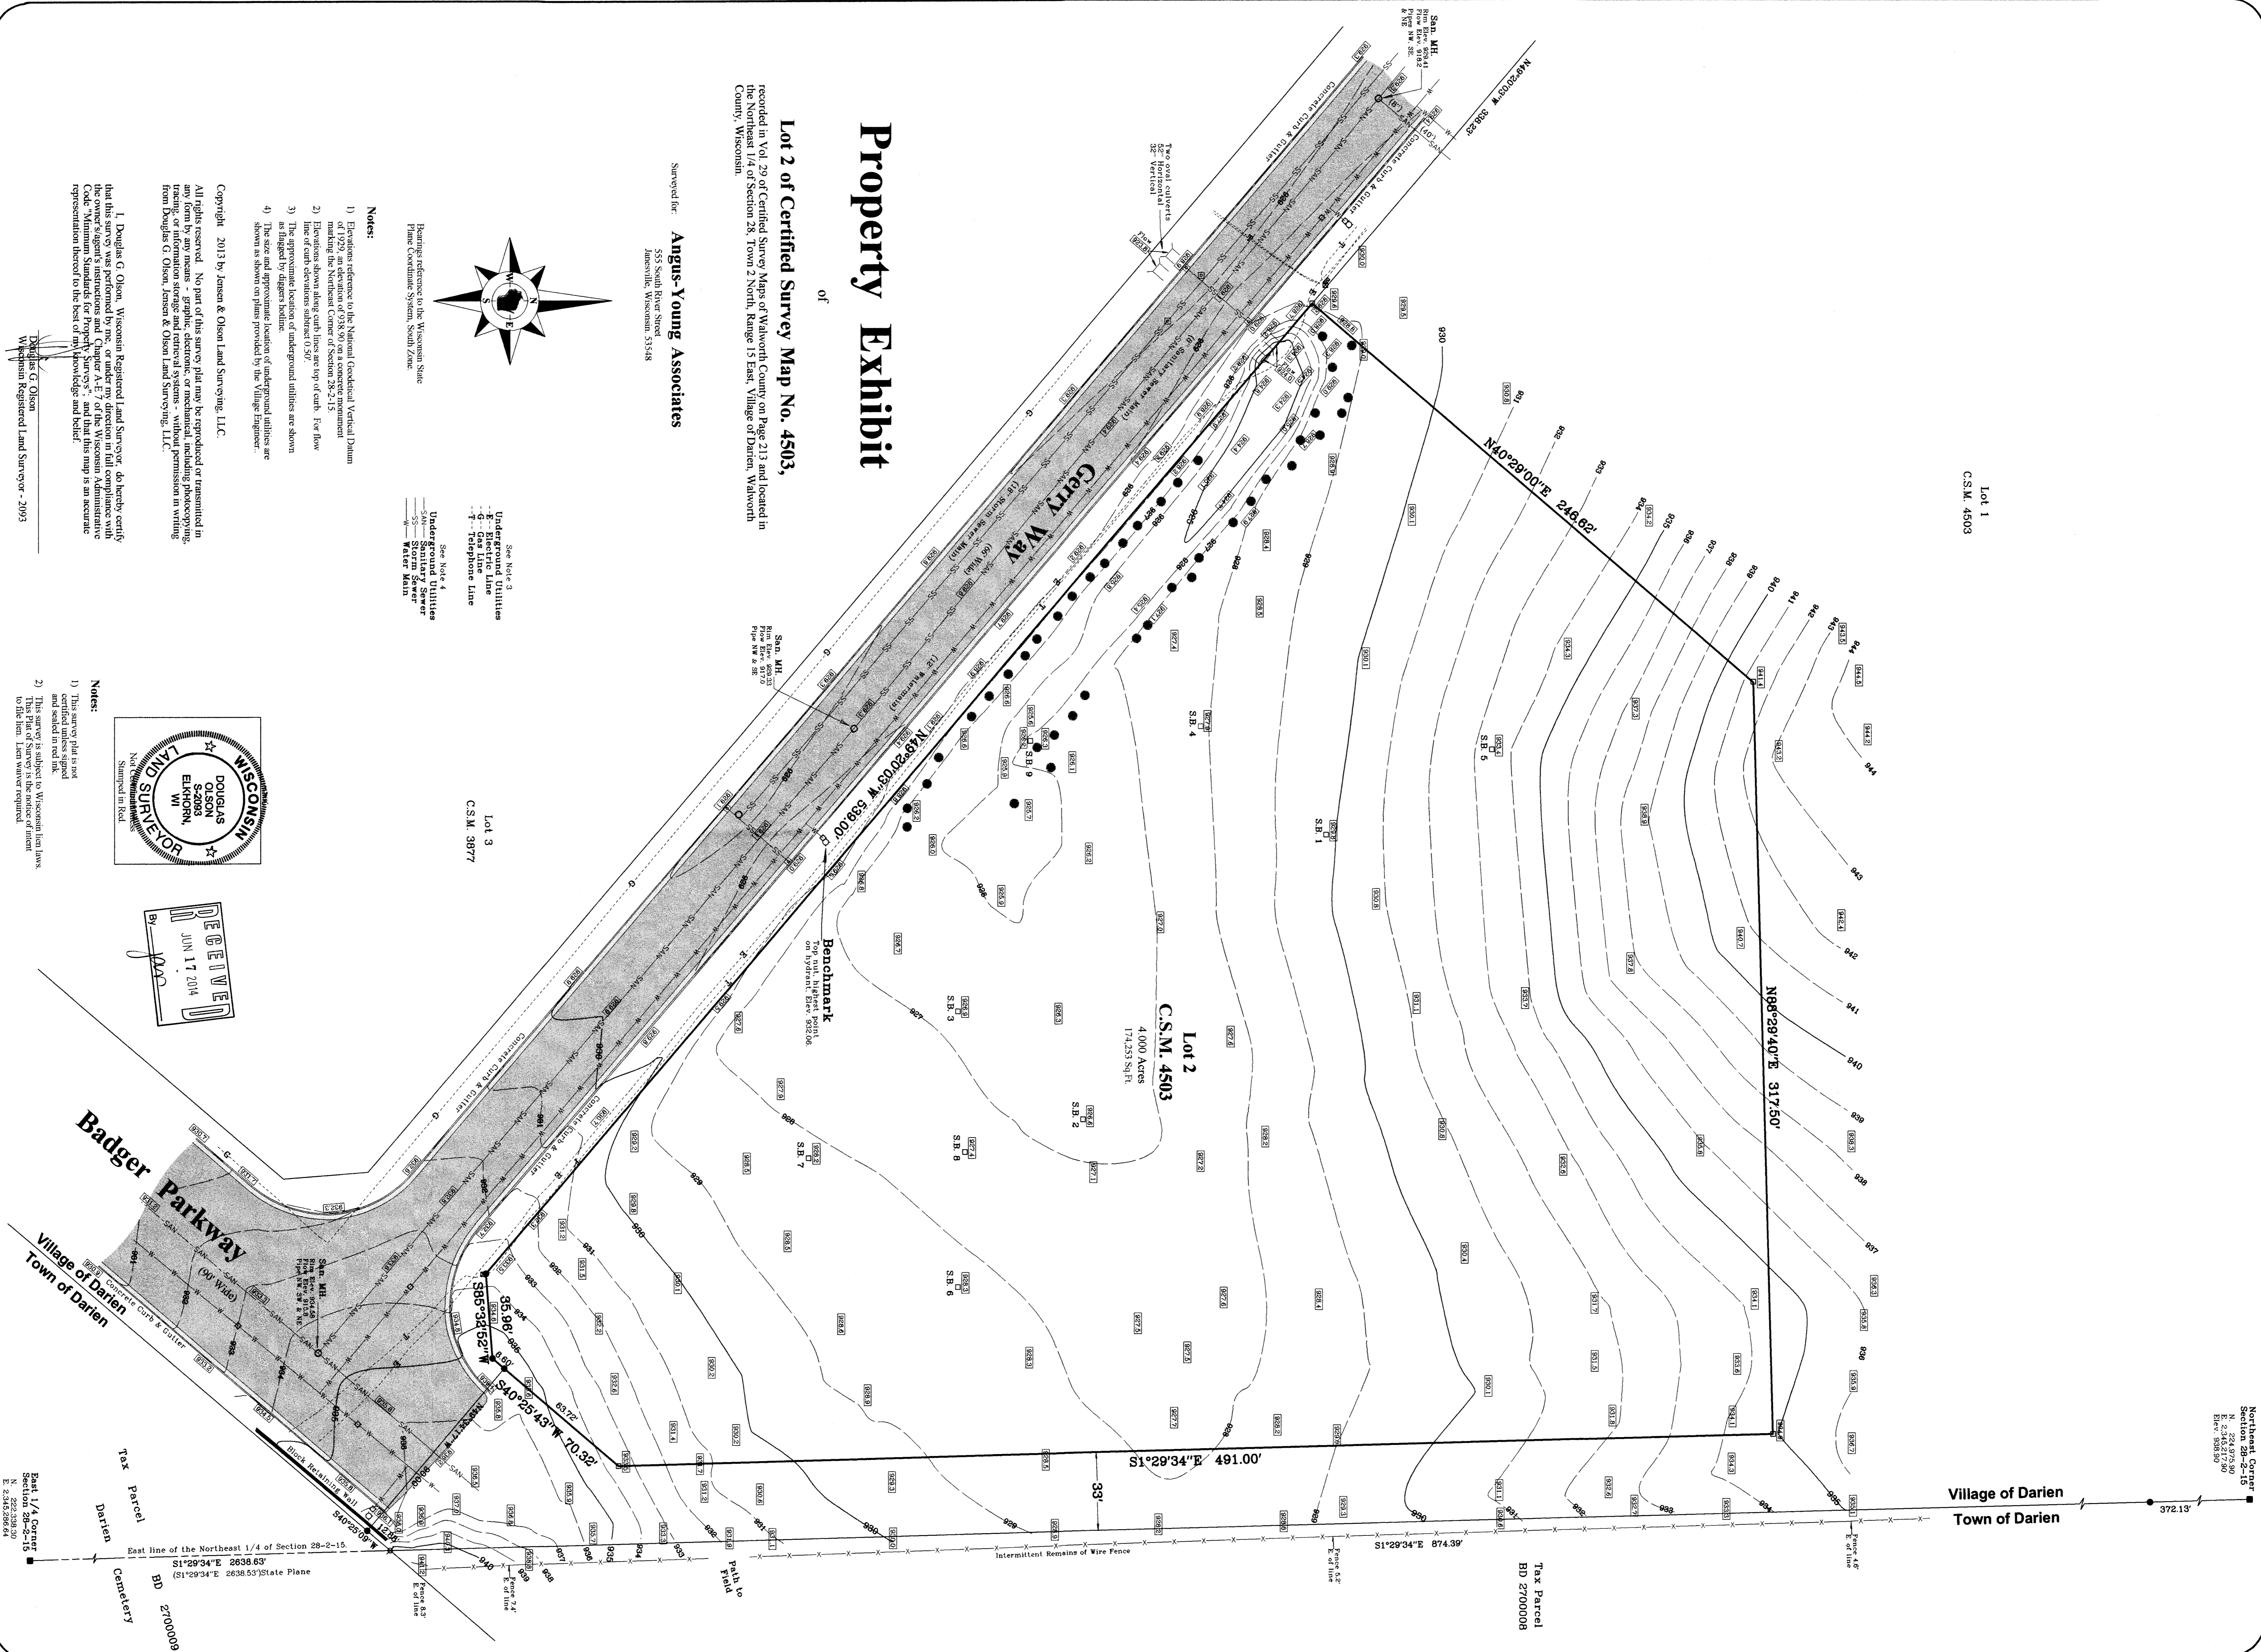

Property Exhibit

Lot 2 of Certified Survey Map No. 4503,
recorded in Vol. 29 of Certified Survey Maps of Walworth County on Page 213 and located in
the Northeast 1/4 of Section 28, Town 2 North, Range 15 East, Village of Darien, Walworth
County, Wisconsin

Surveyed for:
Angus-Young Associates
555 South River Street
Janesville, Wisconsin 53548

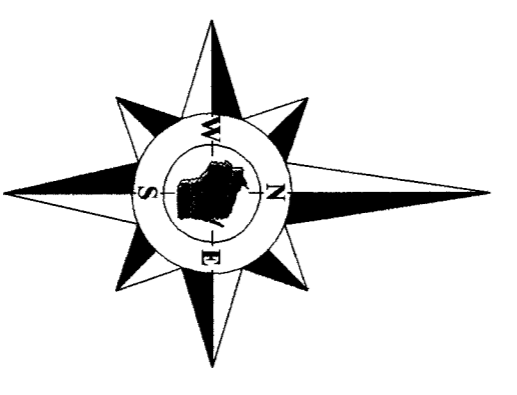


See Note 3
Underground Utilities
- E - Electric Line
- G - Gas Line
- T - Telephone Line
See Note 4
Underground Utilities

- Notes:**
- 1) Elevations reference to the National Geodetic Vertical Datum of 1929; an elevation of 938.99' on a concrete monument marking the Northeast Corner of Section 28-2-15.
 - 3) The approximate location of underground utilities are shown as indicated by digger's holes.
 - 4) The size and approximate location of underground utilities are shown as shown on plans provided by the Village Engineer.

Copyright 2013 by Jensen & Olson Land Surveying, LLC.
All rights reserved. No part of this survey plat may be reproduced or transmitted in any form by any means - graphic, electronic, or mechanical, including photocopying, tracing, or information storage and retrieval systems - without permission in writing from Douglas G. Olson, Jensen & Olson Land Surveying, LLC.

I, Douglas G. Olson, Wisconsin Registered Land Surveyor, do hereby certify that this survey was performed by me, or under my direction in full compliance with the owner's agent's instructions and Chapter A-E 7 of the Wisconsin Administrative Code "Minimum Standards for Property Surveys", and that this map is an accurate representation thereof to the best of my knowledge and belief.

Douglas G. Olson
Wisconsin Registered Land Surveyor - 2093

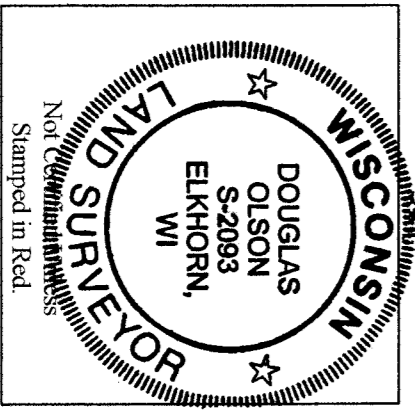


- Notes:**

Sheet 1 of 1 Sheets
Job Reference Number
2013.110

Legend

Found Iron Pipe	Found County Section Corner
Set, Road Lath	Abutment
Recorded Information	Spot Elevation
Water Valve	Spot Elevation
Utility Box or Federal	Spot Elevation
Catch Basin	Spot Elevation
Asphalt Surface	Spot Elevation
Concrete Surface	Spot Elevation

Jensen & Olson Land Surveying, LLC
45 South Wisconsin Street * P.O. Box 322 * Elkhorn, Wisconsin, 53121
Telephone: (262) 723-3434 * Facsimile: (262) 723-8044
Email: jensen.olson@elkhor.net

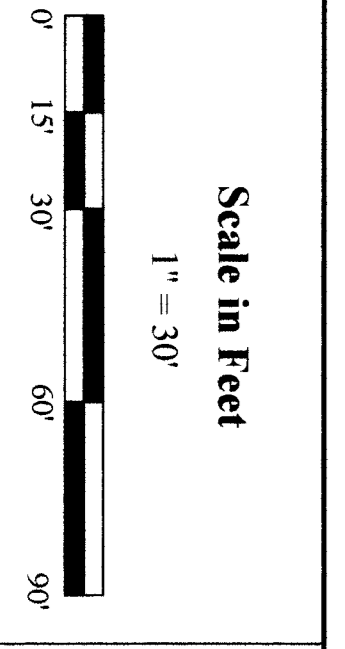

Survey date: October 7, 2013.
Revisions: No. 1 - CSM recording information, UTILITY lines shown per plan

QA4503-7

001-583