Plat of Survey

of

Lot 1 of Certified Survey Map No. 4758,

recorded in Vol. 31 of Certified Survey Maps of Walworth County on Page 268 and located in the Northeast 1/4 of the Northeast 1/4 of Section 28, Town 2 North, Range 15 East, Village of Darien, Walworth County, Wisconsin.

Surveyed for: **Gerry Pelishek**
45 South Walworth Street
Darien, Wisconsin 53114

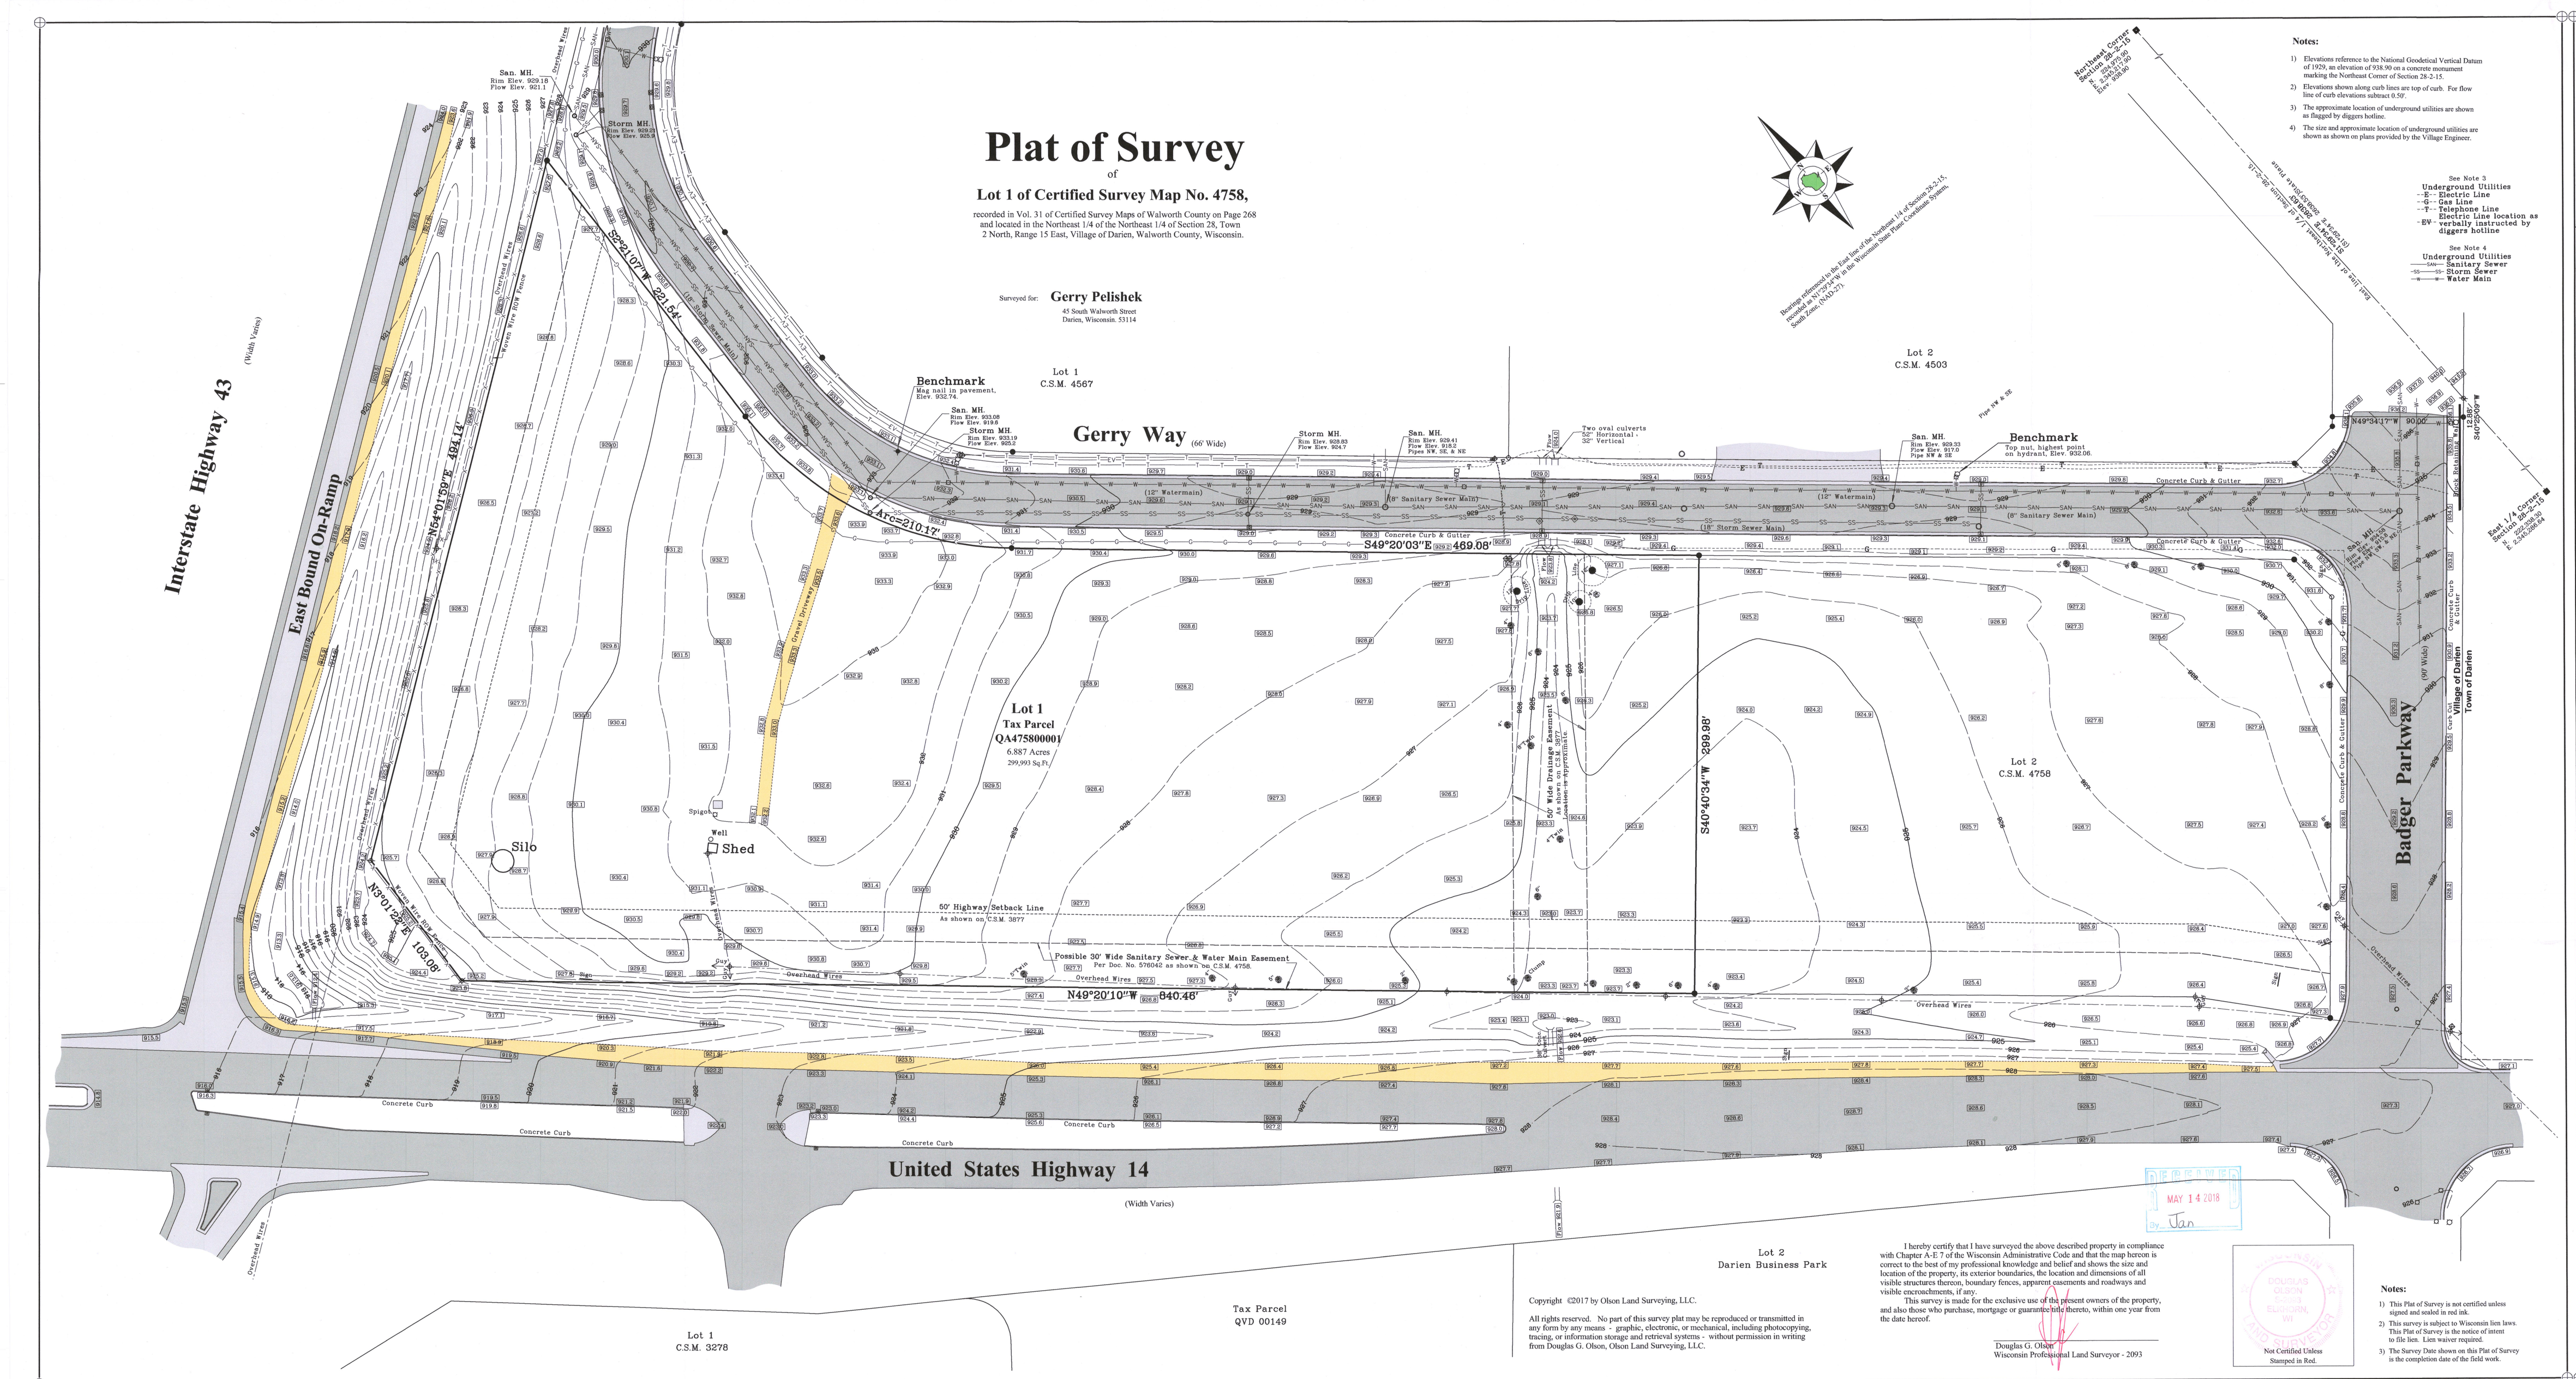

Notes:

1) Elevations reference to the National Geodetical Vertical Datum of 1929, an elevation of 938.90 on a concrete monument marking the Northeast Corner of Section 28-2-15.
2) Elevations shown along curb lines are top of curb. For flow line of curb elevations subtract 0.50'.
3) The approximate location of underground utilities are shown as flagged by diggers hotline.
4) The size and approximate location of underground utilities are shown as shown on plans provided by the Village Engineer.

See Note 3
Underground Utilities
-E- Electric Line
-G- Gas Line
-T- Telephone Line
Electric Line location as
-EW- verbally instructed by diggers hotline

See Note 4
Underground Utilities
San Sanitary Sewer
SS Storm Sewer
Water Main

Bearings referenced to the East line of the Northeast 1/4 of Section 28-2-15, recorded as N1°52'54"E in the Wisconsin State Plane Coordinate System, South Zone (NAD1 27).

Legend of Symbols & Abbreviations

Found 1" Iron Pipe
Found 3/4" Rebar
Set 1" Iron Pipe, 1.68 lbs. per lin. ft.
Utility Pole
Guy Anchor
Manhole
Hydrant
Mailbox
Asphalt Surface
Concrete Surface
Brick Pavers
Pine Without Cones
Deciduous Tree
Coniferous Tree

DRAWN
MAY 14 2018
By Jan

I hereby certify that I have surveyed the above described property in compliance with Chapter A-E 7 of the Wisconsin Administrative Code and that the map hereon is correct to the best of my professional knowledge and belief and shows the size and location of the property, its exterior boundaries, the location and dimensions of all visible structures thereon, boundary fences, apparent easements and roadways and visible encroachments, if any.

This survey is made for the exclusive use of the present owners of the property, and also those who purchase, mortgage or guarantee title thereto, within one year from the date hereof.

Douglas G. Olson
Wisconsin Professional Land Surveyor - 2093

DOUGLAS G. OLSON — S-2093 — WISCONSIN — LAND SURVEYOR

Not Certified Unless Stamped in Red.

Notes:

1) This Plat of Survey is not certified unless signed and sealed in red ink.
2) This survey is subject to Wisconsin lien laws. This Plat of Survey is the notice of intent to file lien. Lien waiver required.
3) The Survey Date shown on this Plat of Survey is the completion date of the field work.

Copyright ©2017 by Olson Land Surveying, LLC.

All rights reserved. No part of this survey plat may be reproduced or transmitted in any form by any means - graphic, electronic, or mechanical, including photocopying, tracing, or information storage and retrieval systems - without permission in writing from Douglas G. Olson, Olson Land Surveying, LLC.

Survey date: December 2, 2016.
Revisions: No. 1 – C.S.M. 4758

Scale in Feet
1" = 40'
0' 20' 40' 80' 120'

OLSON
LAND SURVEYING, LLC
Rural | Residential | Commercial
45 South Wisconsin Street | P.O. Box 322
Elkhorn, WI 53121
Telephone: (262) 723-3434
Facsimile: (262) 723-8044
Email: doug@olsonsurveying.com
Website: www.olsonsurveying.com

Sheet 1 of 1 Sheets

Drawing Name:

Job Reference Number
2015.045

2015.045

QA4758-1 001-612