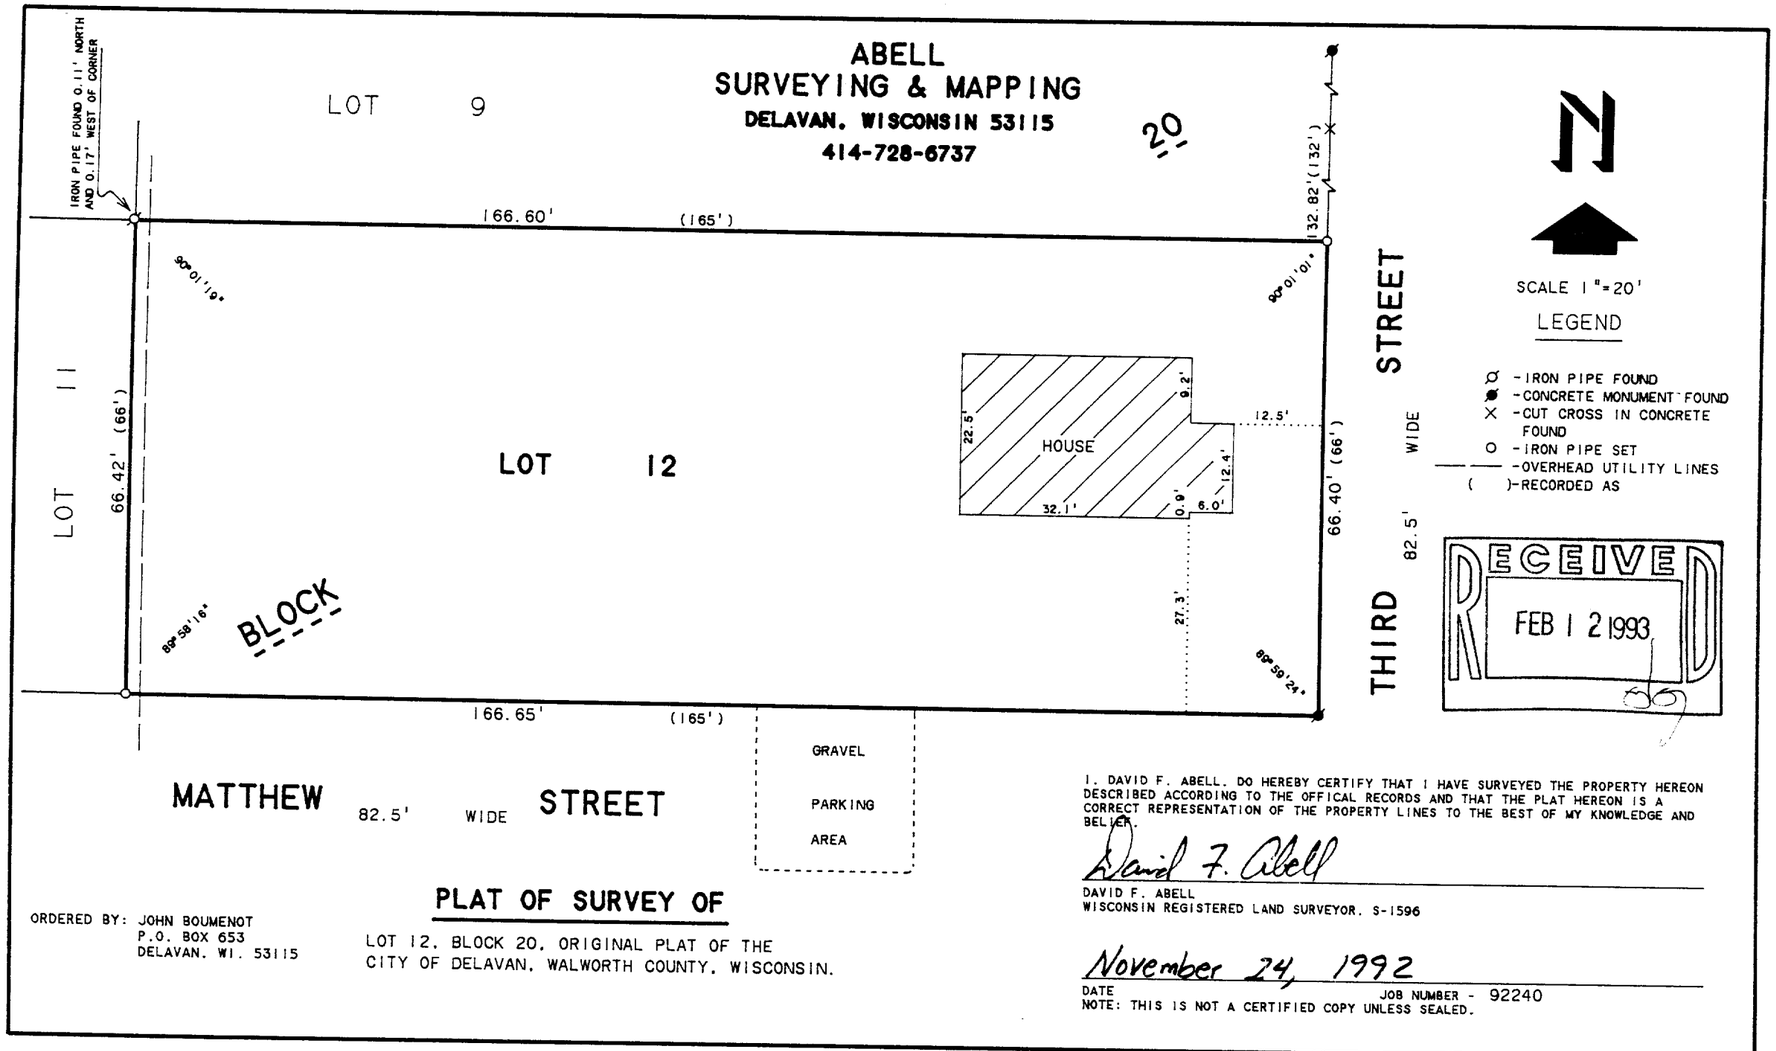


ORDERED BY: JOHN BOUMENOT
P.O. BOX 653
DELAVAN, WI. 53115

## PLAT OF SURVEY OF

LOT 12, BLOCK 20, ORIGINAL PLAT OF THE CITY OF DELAVAN, WALWORTH COUNTY, WISCONSIN.

I, DAVID F. ABELL, DO HEREBY CERTIFY THAT I HAVE SURVEYED THE PROPERTY HEREON DESCRIBED ACCORDING TO THE OFFICAL RECORDS AND THAT THE PLAT HEREON IS A CORRECT REPRESENTATION OF THE PROPERTY LINES TO THE BEST OF MY KNOWLEDGE AND BELIEF.

David F. Abell

DAVID F. ABELL
WISCONSIN REGISTERED LAND SURVEYOR, S-1596

November 24, 1992

DATE

JOB NUMBER - 92240

NOTE: THIS IS NOT A CERTIFIED COPY UNLESS SEALED.

Ø02-1225

XOP-215