DUNHAM & RASMUSSEN

SURVEYING & ENGINEERING

DELAVAN, WISCONSIN

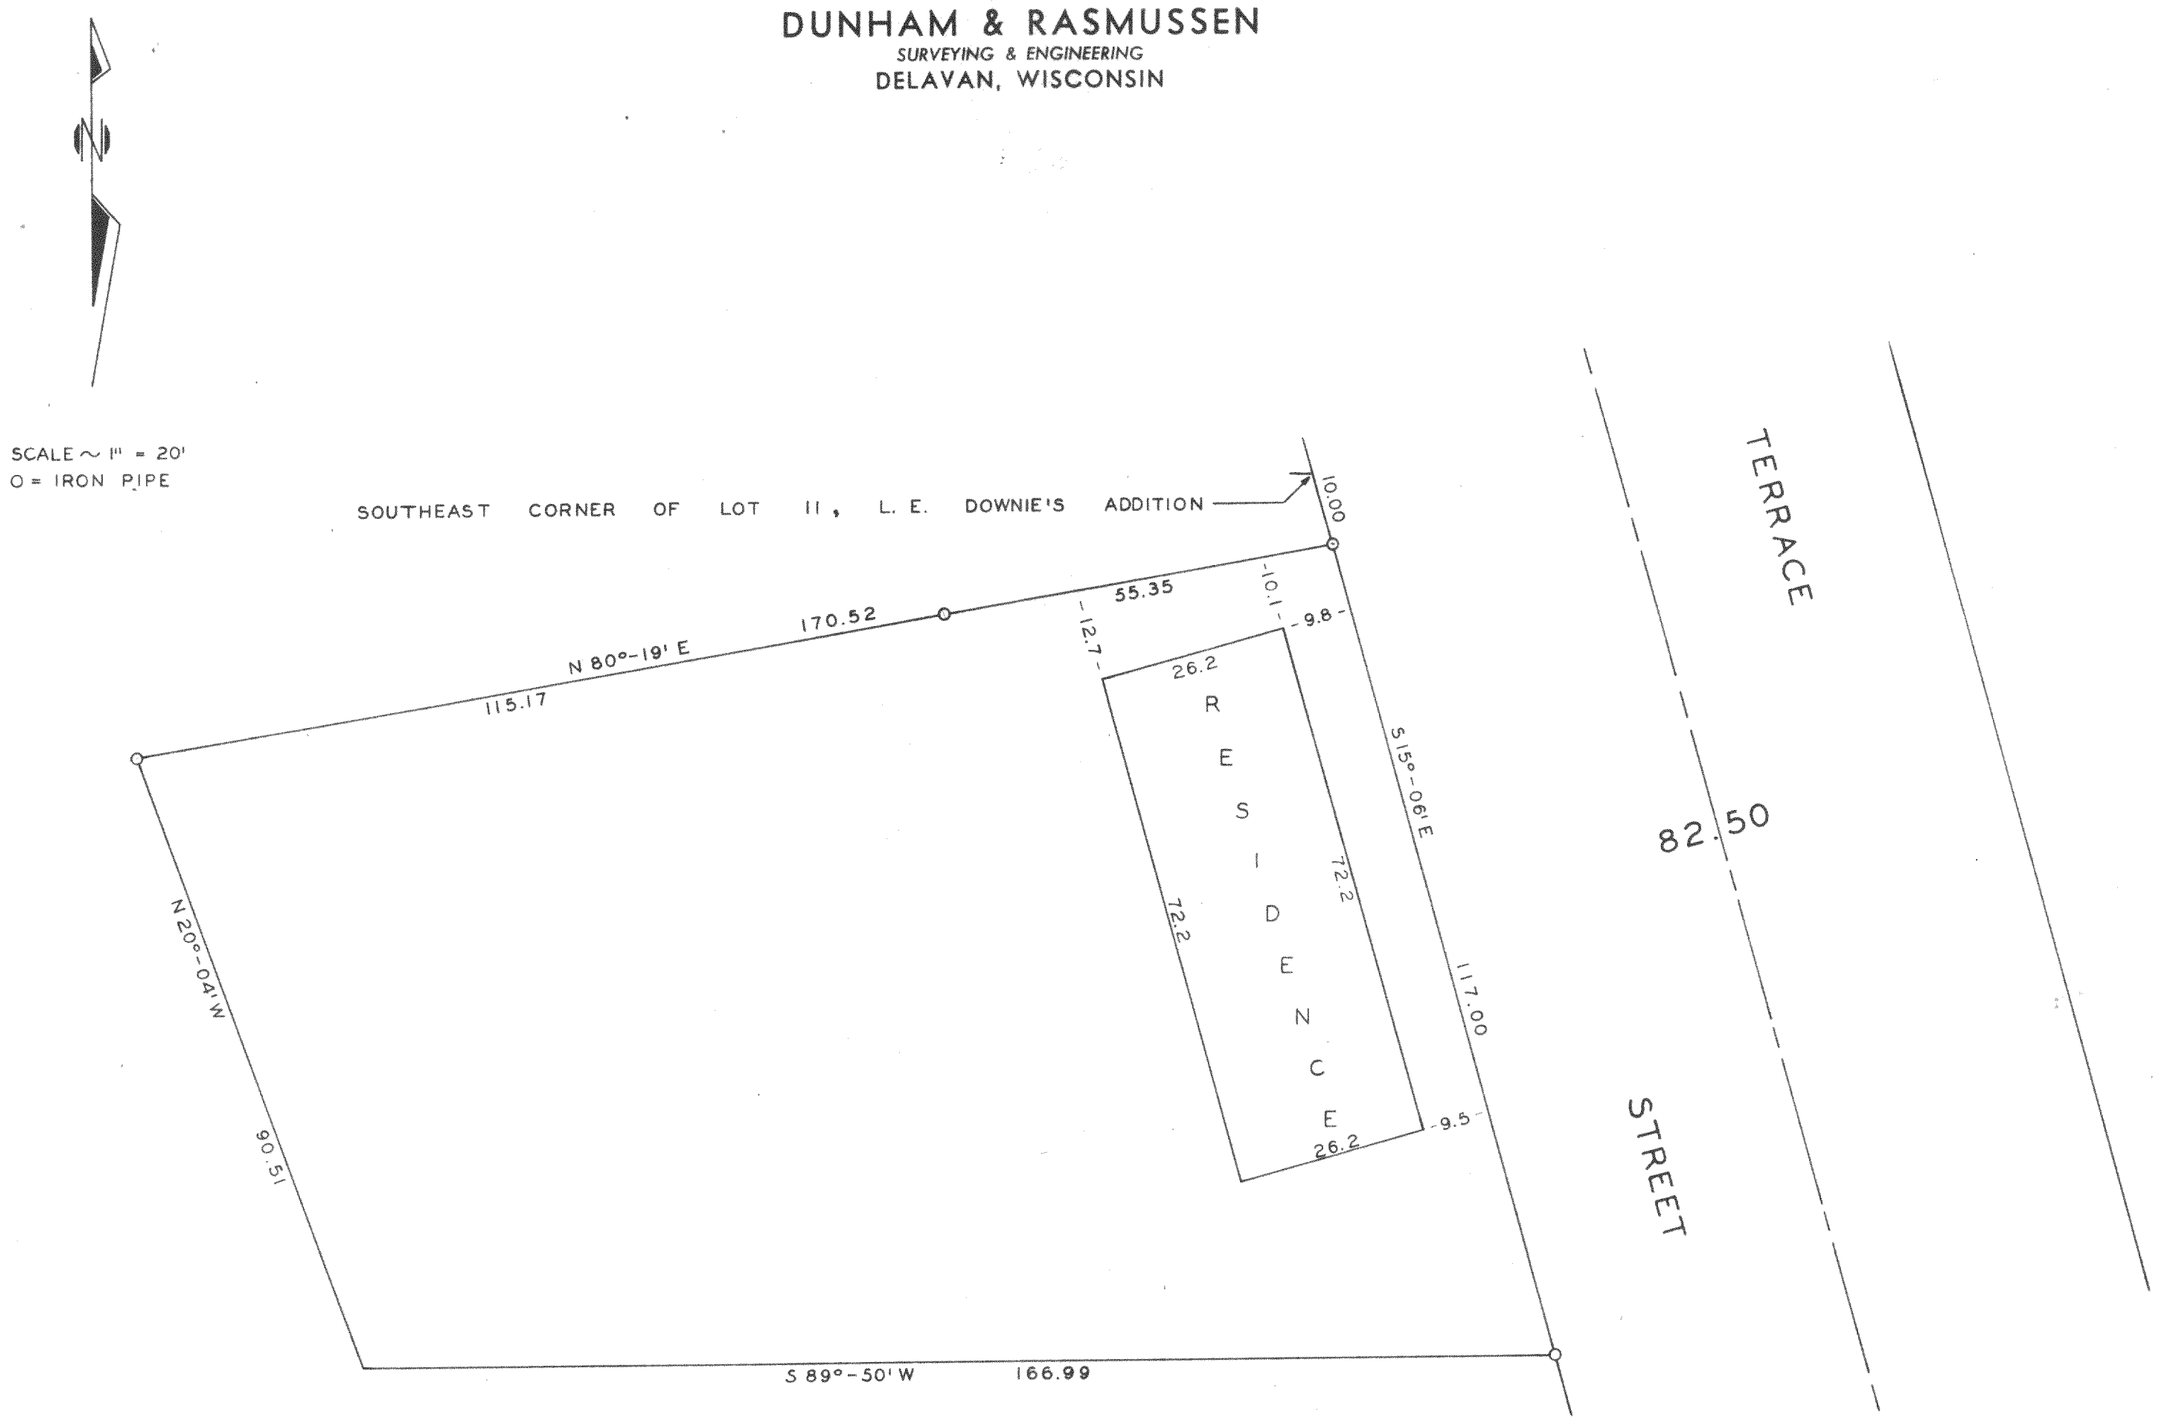

STATE OF WISCONSIN)
WALWORTH COUNTY) SS

I, George T. Dunham, do hereby certify that I have surveyed the parcel of land described as follows;

Beginning at the southeast corner of Lot 11, L. E. Downie's Addition to the City of Delavan, as platted and recorded with the Register of Deeds in and for Walworth County, Wisconsin; run thence south 15° - 06' east on the westerly line of Terrace Street, 10.00 feet to a point, said point marks the place of beginning of parcel of land hereinafter described; thence continue south 15° - 06' east on the westerly line of Terrace Street, 117.00 feet to a concrete monument; thence south 89° - 50' west, 166.99 feet to a point; thence north 20° - 04' west, 90.51 feet to a point, thence north 80° - 19' east, 170.52 feet to a point on the westerly line of Terrace Street and the place of beginning. Said parcel of land is a part of Assessor's lot #127, located in the Southwest quarter of Section 18, Town 2 North, Range 16 East of the 4th P. M., City of Delavan, Walworth County, Wisconsin.

and that the plat shown above is a correct representation of the property lines and the improvements located thereon.
July 29, 1960

George T. Dunham

George T. Dunham, Surveyor

K & E—195L 250-4-60

UP-127A

2-156