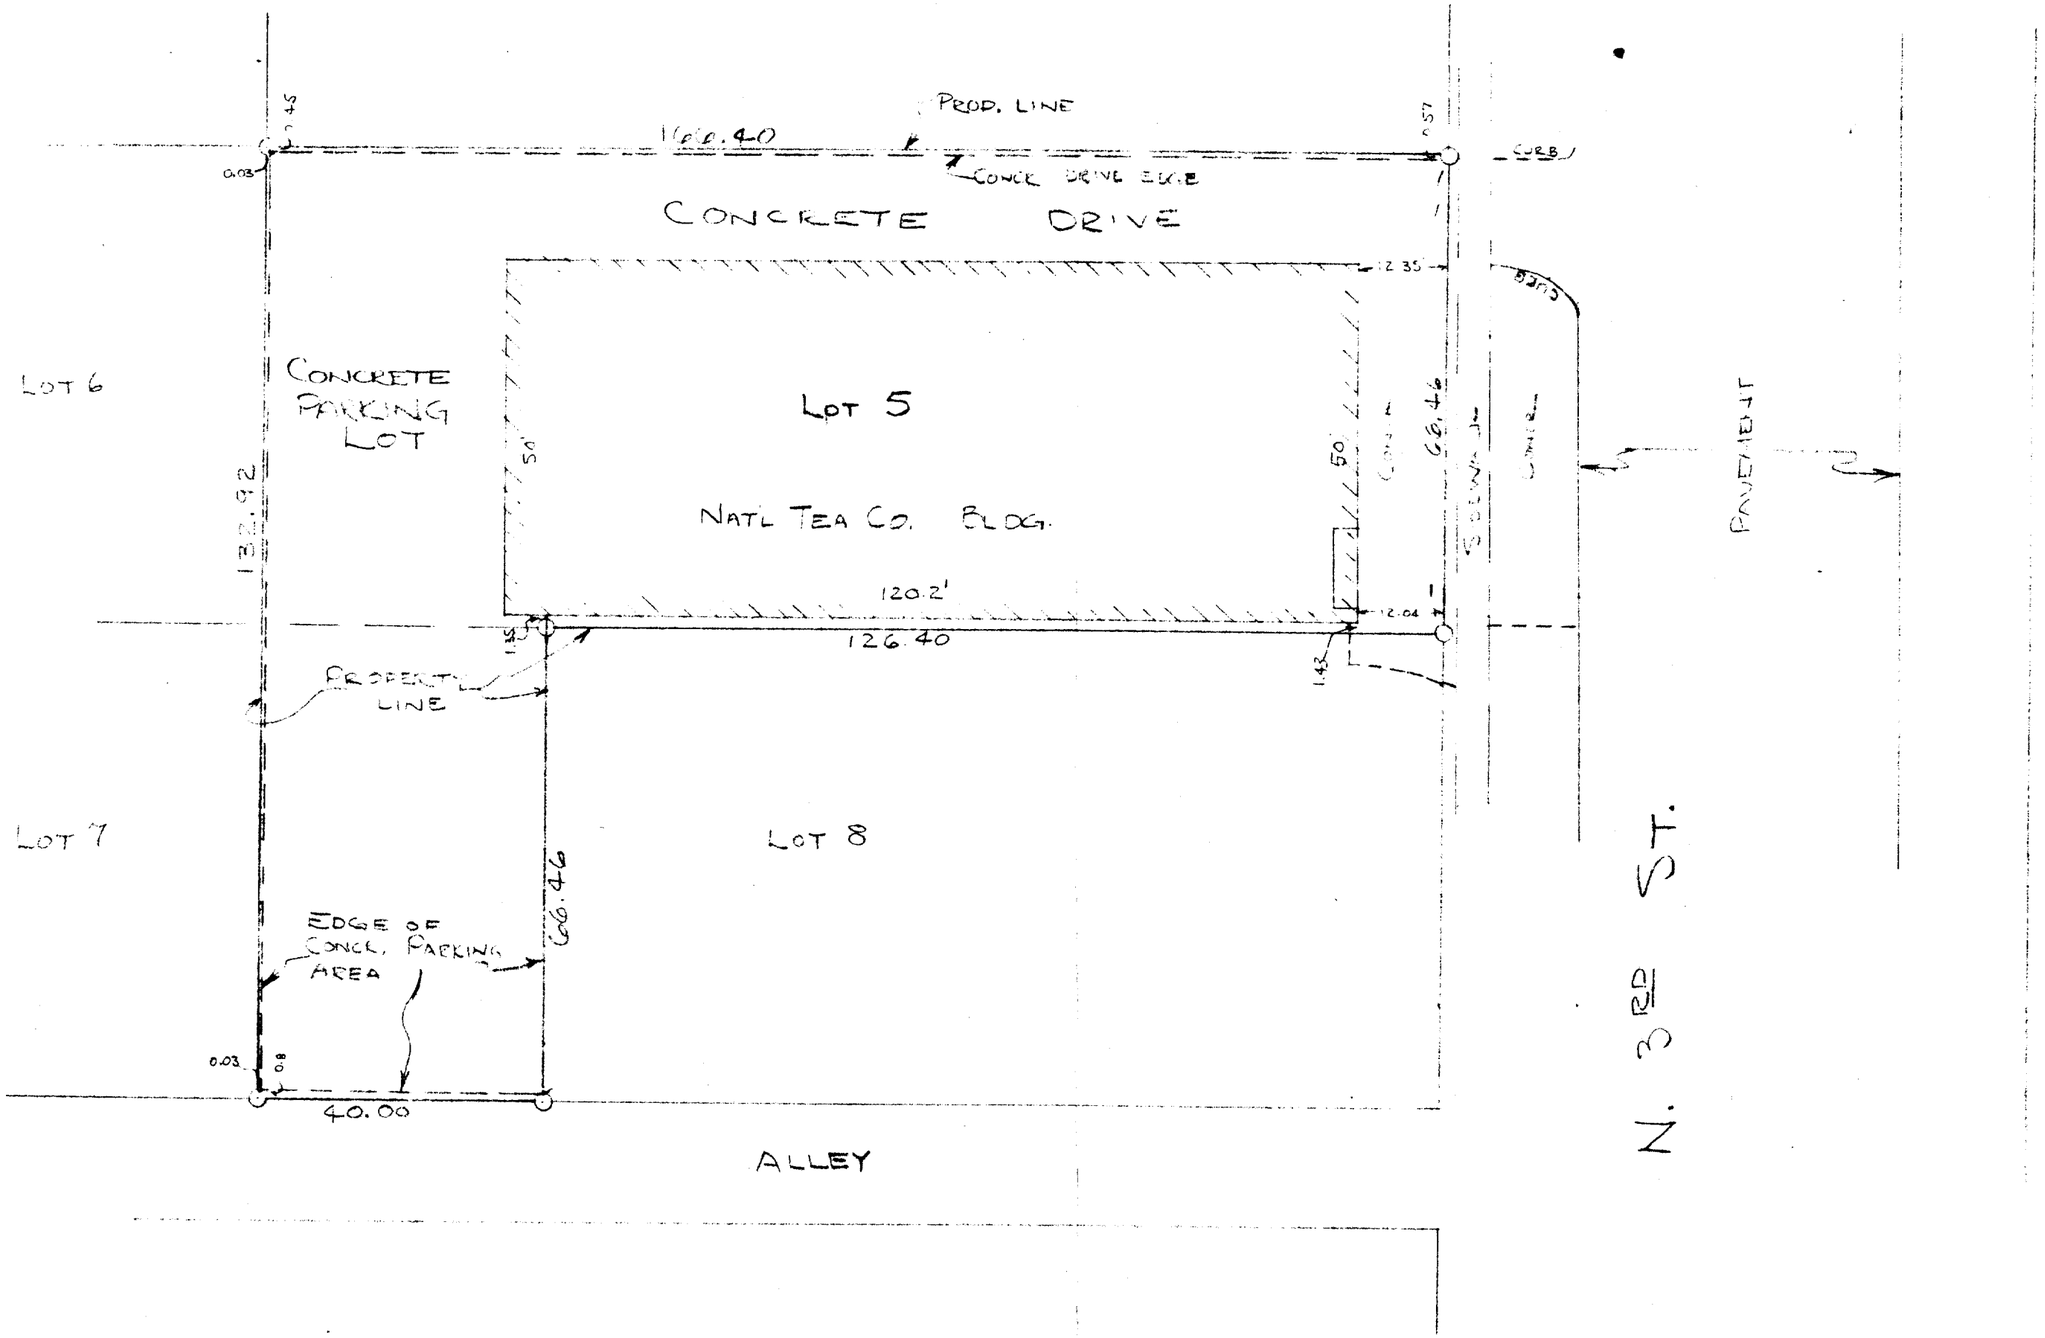

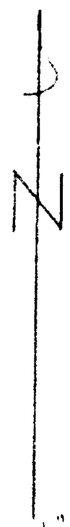

SCALE 1" = 20'
O = IRON PIPE

XOP-57

STATE OF WISCONSIN)
COUNTY OF WALWORTH) SS

I, LLOYD L. JENSEN, DO HEREBY CERTIFY THAT THE ABOVE PLAT IS A TRUE AND CORRECT PLAT OF A SURVEY MADE ON NOVEMBER 21, 1950, OF PROPERTY LEGALLY DESCRIBED AS FOLLOWS:

LOT 5 AND THE WEST 40 FEET OF LOT 8 OF BLOCK 9 OF THE ORIGINAL PLAT OF THE CITY OF DELAVAN, WALWORTH COUNTY, WIS.

SAID PLAT SHOWS THE LOCATION AND DIMENSIONS OF ALL BUILDING IMPROVEMENTS.

NOVEMBER 21, 1950

Lloyd L. Jensen 2-20 J
COUNTY SURVEYOR 2-20