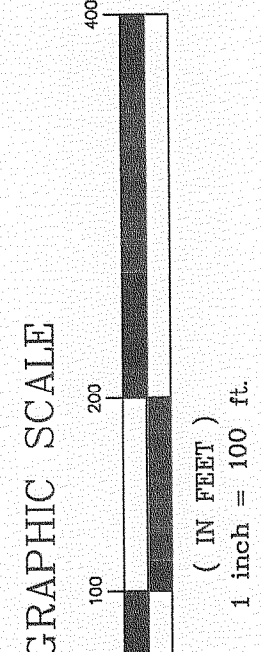


ALTA/ACSM LAND TITLE SURVEY

PLOT FILE: STANDARD
NEW: Layout

LEGAL DESCRIPTION

[illegible][illegible]

NOTES:

1. Title Commitment No. 428077, Effective Date 1-18-2008 and amended 3-11-2008 issued by Chicago Title Insurance Co. was used in preparing this survey.
2. Measured distance. Infrared distance.
3. Bearings based on Wisconsin State Plane Coordinates South Zone 1827 Datum.
4. The triangular parcel depicted herein as "lot 4" may constitute a landlocked parcel. If so, a right-of-way easement over the adjacent property of the same owner as property, A title insurer or attorney should be consulted for particulars.
5. No easement or other documents for the located billboard sign were noted in the title commitment.


STATE OF ILLINOIS)
COUNTY OF McHENRY) SS

To: GKBP Holdings, LLC
Household Finance Corporation, III, A Delaware Corporation
Chicago Title Insurance Company

This is to certify that this map or plan was prepared by the undersigned in accordance with "Minimum Standard Data Requirements for ALTA/ACSM Land Title Surveys," jointly established by ALTA, ACSM and NPSIS in 2003, and includes Items 1, 3, 4, 7a, 8, 9, 10 and 11a of Table A thereof. Pursuant to the Accuracy Standards as required by ALTA, NPSIS and ACSM and in effect on the date of preparation of this map or plan, the survey was conducted in full compliance as a land surveyor registered in the State of Wisconsin, the relative positional accuracy of this survey does not exceed that which is specified therein.

I further certify that I have examined F.R.M.A. Map Community Plan No. 550462 dated 03/01/2007, recorded in Vol. 1853, Page 100, and determined that the subject property is in Zone C, one of mining/flooding.

Date: March 13 2008
By: E. Haglund
Eric J. Haglund

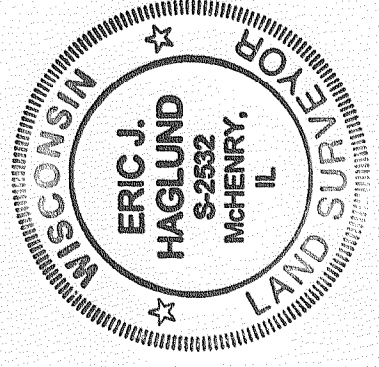

ALL DISTANCES SHOWN IN FEET AND DECIMAL PARTS THEREOF.


Compare your description and site markings with this plat and AT ONCE report any discrepancies which you may find.


