ORDERED BY
RICHARD TORHORST

PLAT OF SURVEY

- OF -

PATHFINDER SURVEYING INC.
(formerly)
J.K. SURVEYING INC.
P.O BOX 322
LAKE GENEVA, WI. 53147
WWW.PATHFINDERSURVEYING.NET
262-248-8303

LOT 5 , BLOCK 7 SPRINGS PARK SUBDIVISION ADDITION No. 2, LOCATED IN THE SW 1/4 OF SECTION 18, TOWN 2 NORTH, RANGE 16 EAST OF THE FOURTH PRINCIPAL MERIDIAN, CITY OF DELAVAN, COUNTY OF WALWORTH AND STATE OF WISCONSIN.

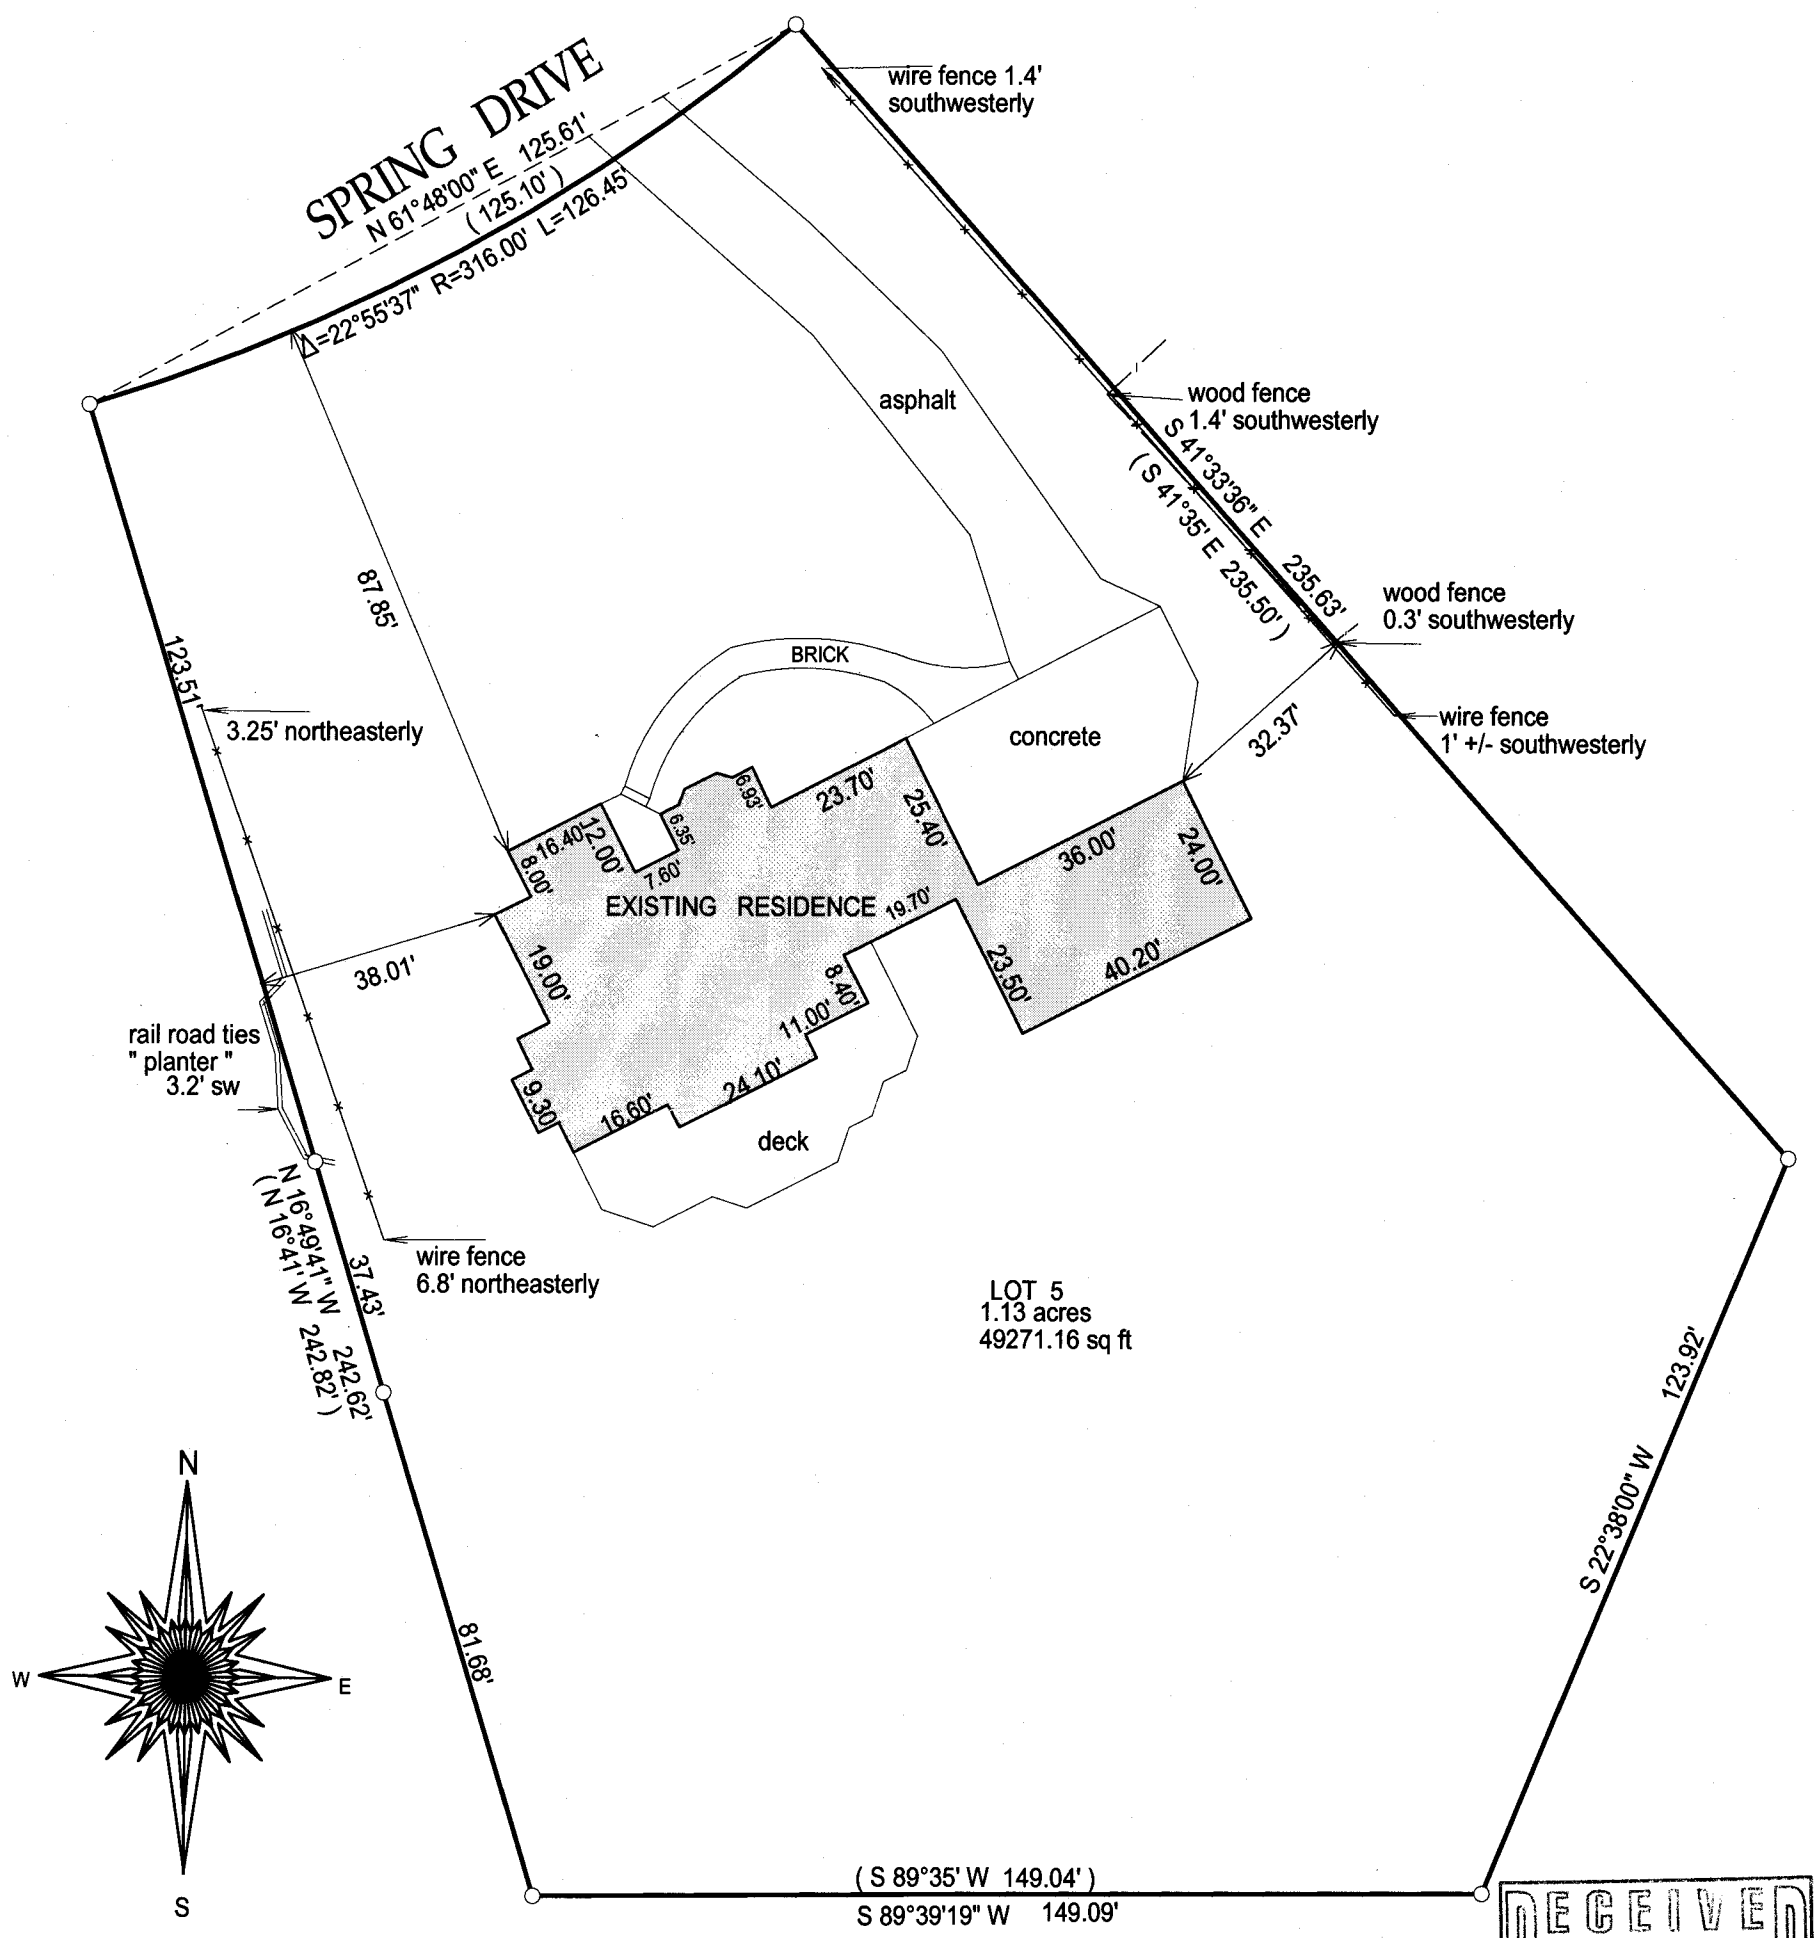

( )= recorded as

□ = found iron bar

○ = found iron pipe

● = set iron pipe

■ = set iron bar

SCALE 1" = ~~20'~~ 30'

JOB # 14-182

TAX ID #

XSPS200012

30 0 30 60 90

BASIS OF BEARING OF THIS PLAT: THE SUBDIVISION PLAT OF RECORD.

I hereby certify that I have surveyed the above- described property and the above map is a is a true representation thereof and shows the size and location of the property, its exterior boundaries, the location and dimensions of all structures thereon, fences, apparant easements and roadways and visible encroachments if any.

This survey is made for the present owners of the property, and those who purchase, mortgage, or guarantee the title thereto, within one year from the date hereof.

DATED THIS 15TH DAY OF AUGUST, 2014.

RECEIVED
OCT 7 2014
By

WISCONSIN JEFFREY L. KIMPS S-2436 LAKE GENEVA, WIS. LAND SURVEYOR

JEFFREY L KIMPS S - 2436
Wisconsin Registered Land Surveyor
(original if signed in red)

X8P82 -12 002-2562