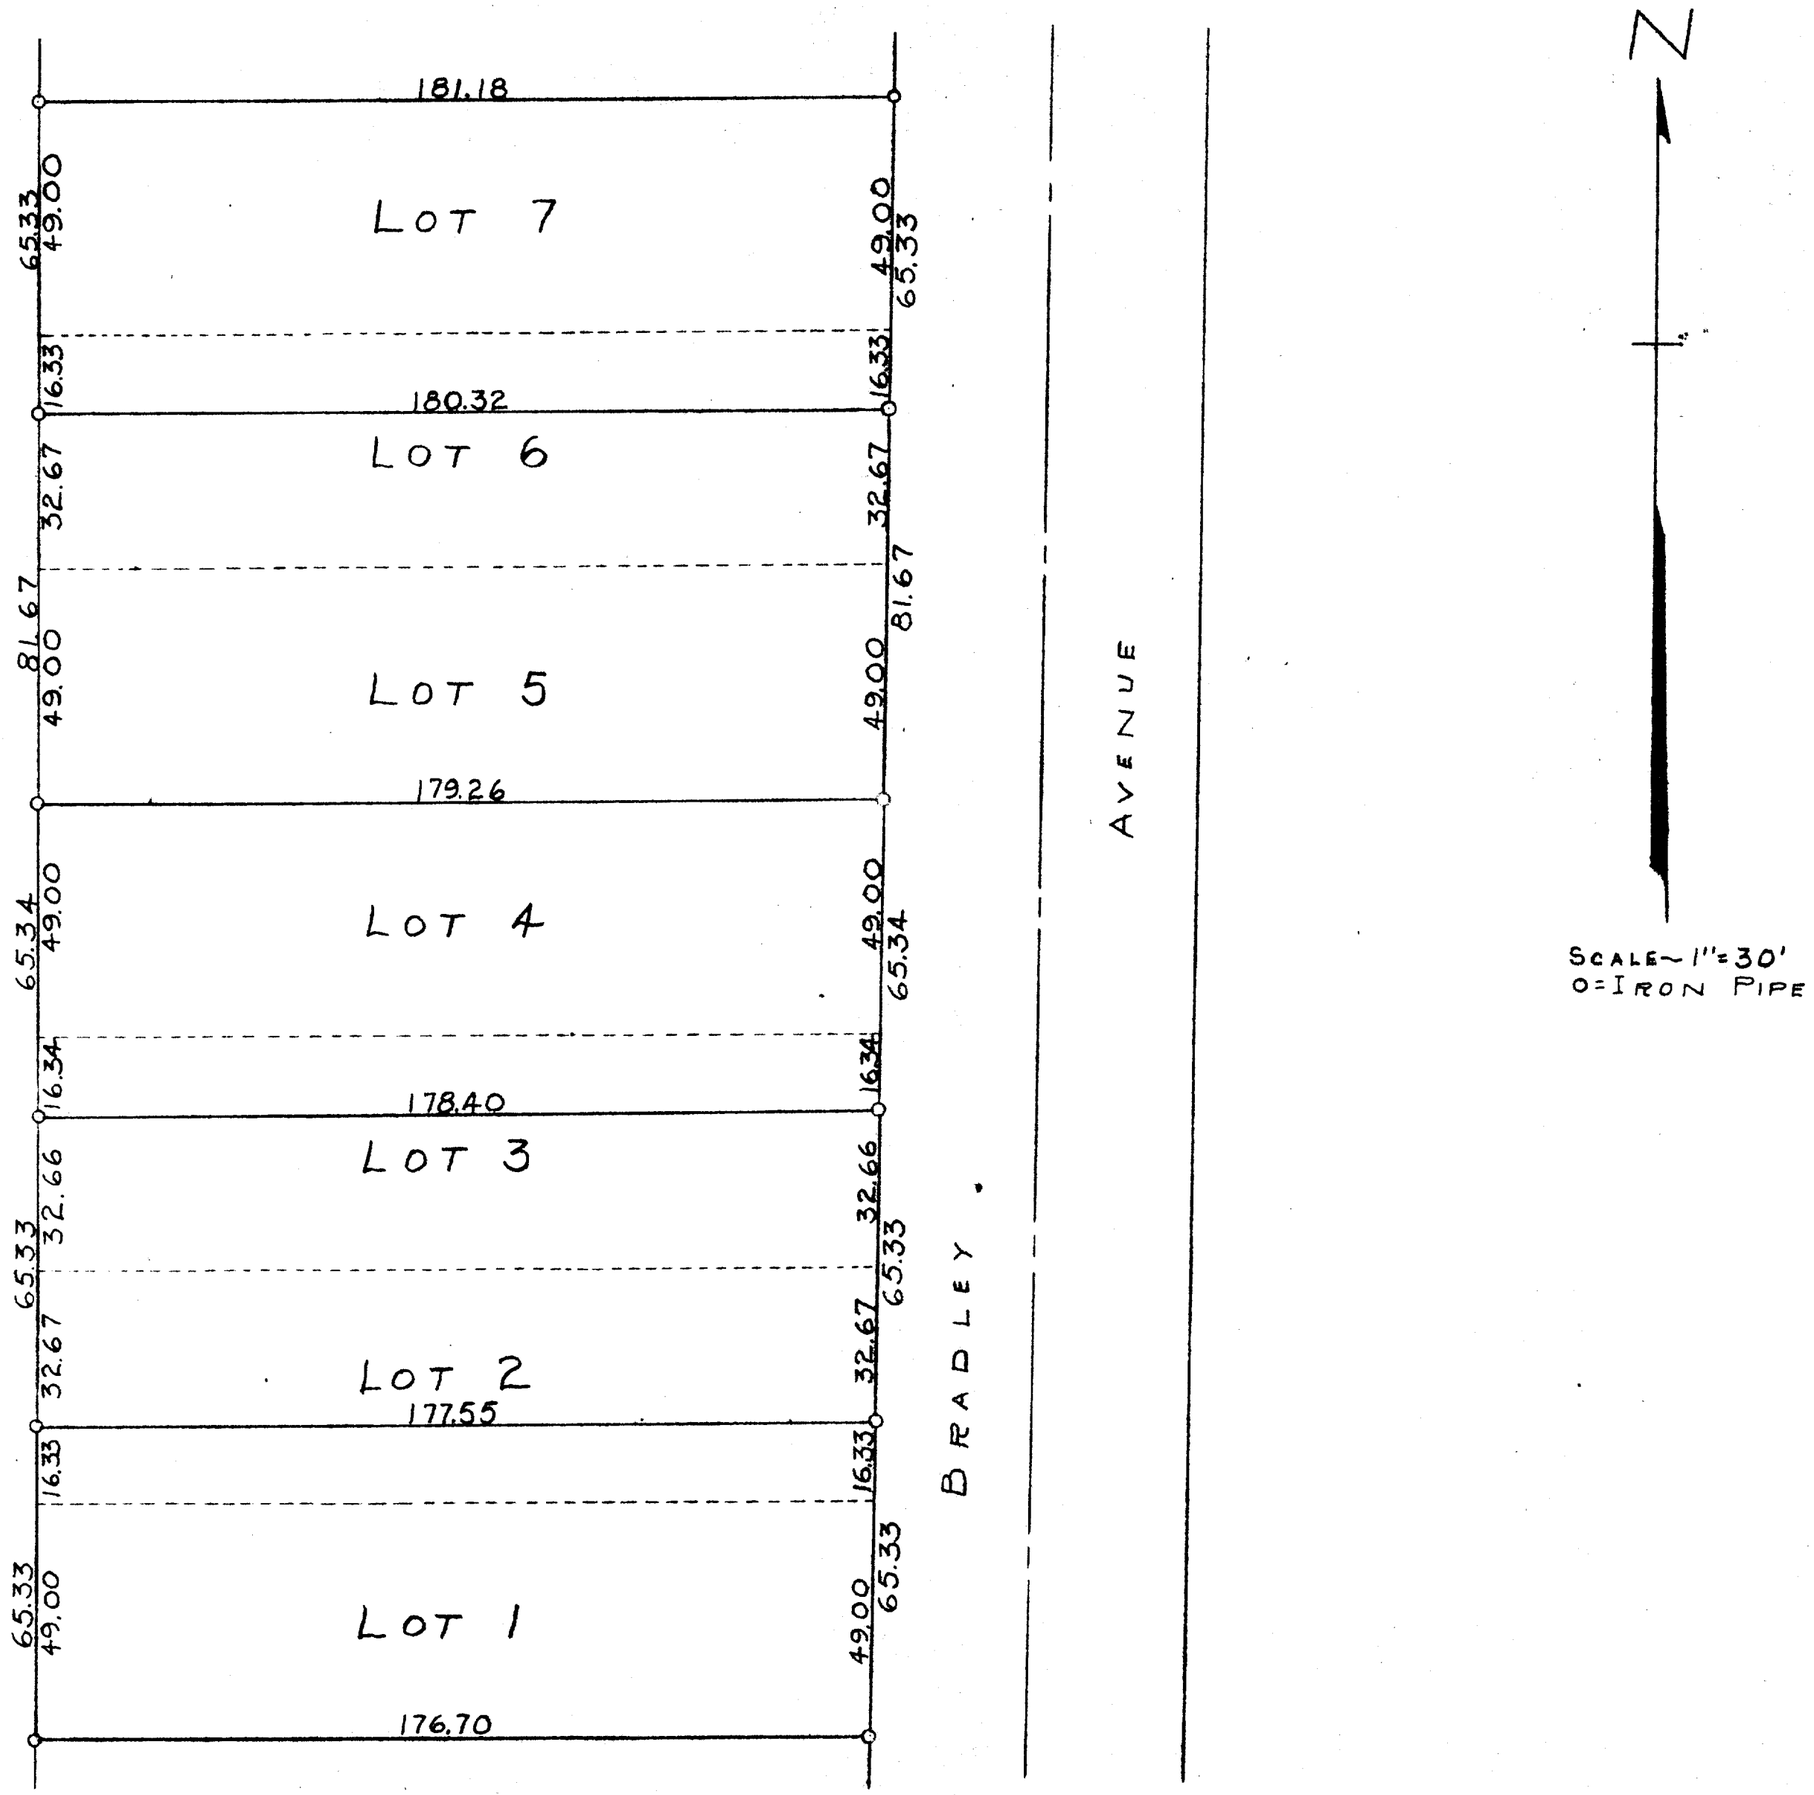

STATE OF WISCONSIN)
COUNTY OF WALWORTH) SS

I, GEORGE T. DUNHAM, DO HEREBY CERTIFY THAT I HAVE SURVEYED THE PROPERTY DESCRIBED AS FOLLOWS:

LOTS 1-7 INCLUSIVE OF BRADLEY ANNEX LOCATED IN THE CITY OF DELAVAN, WALWORTH COUNTY, WISCONSIN

AND THAT THE PLAT SHOWN ABOVE IS A CORRECT REPRESENTATION OF THE DIVISION OF THE SAID LOTS.

AUGUST 6, 1953

George T. Dunham
GEORGE T. DUNHAM, SURVEYOR
DELAVAN, WISCONSIN

2-4

XBR-1, XBR-1A, XBR-1B, XBR-1C + 1D