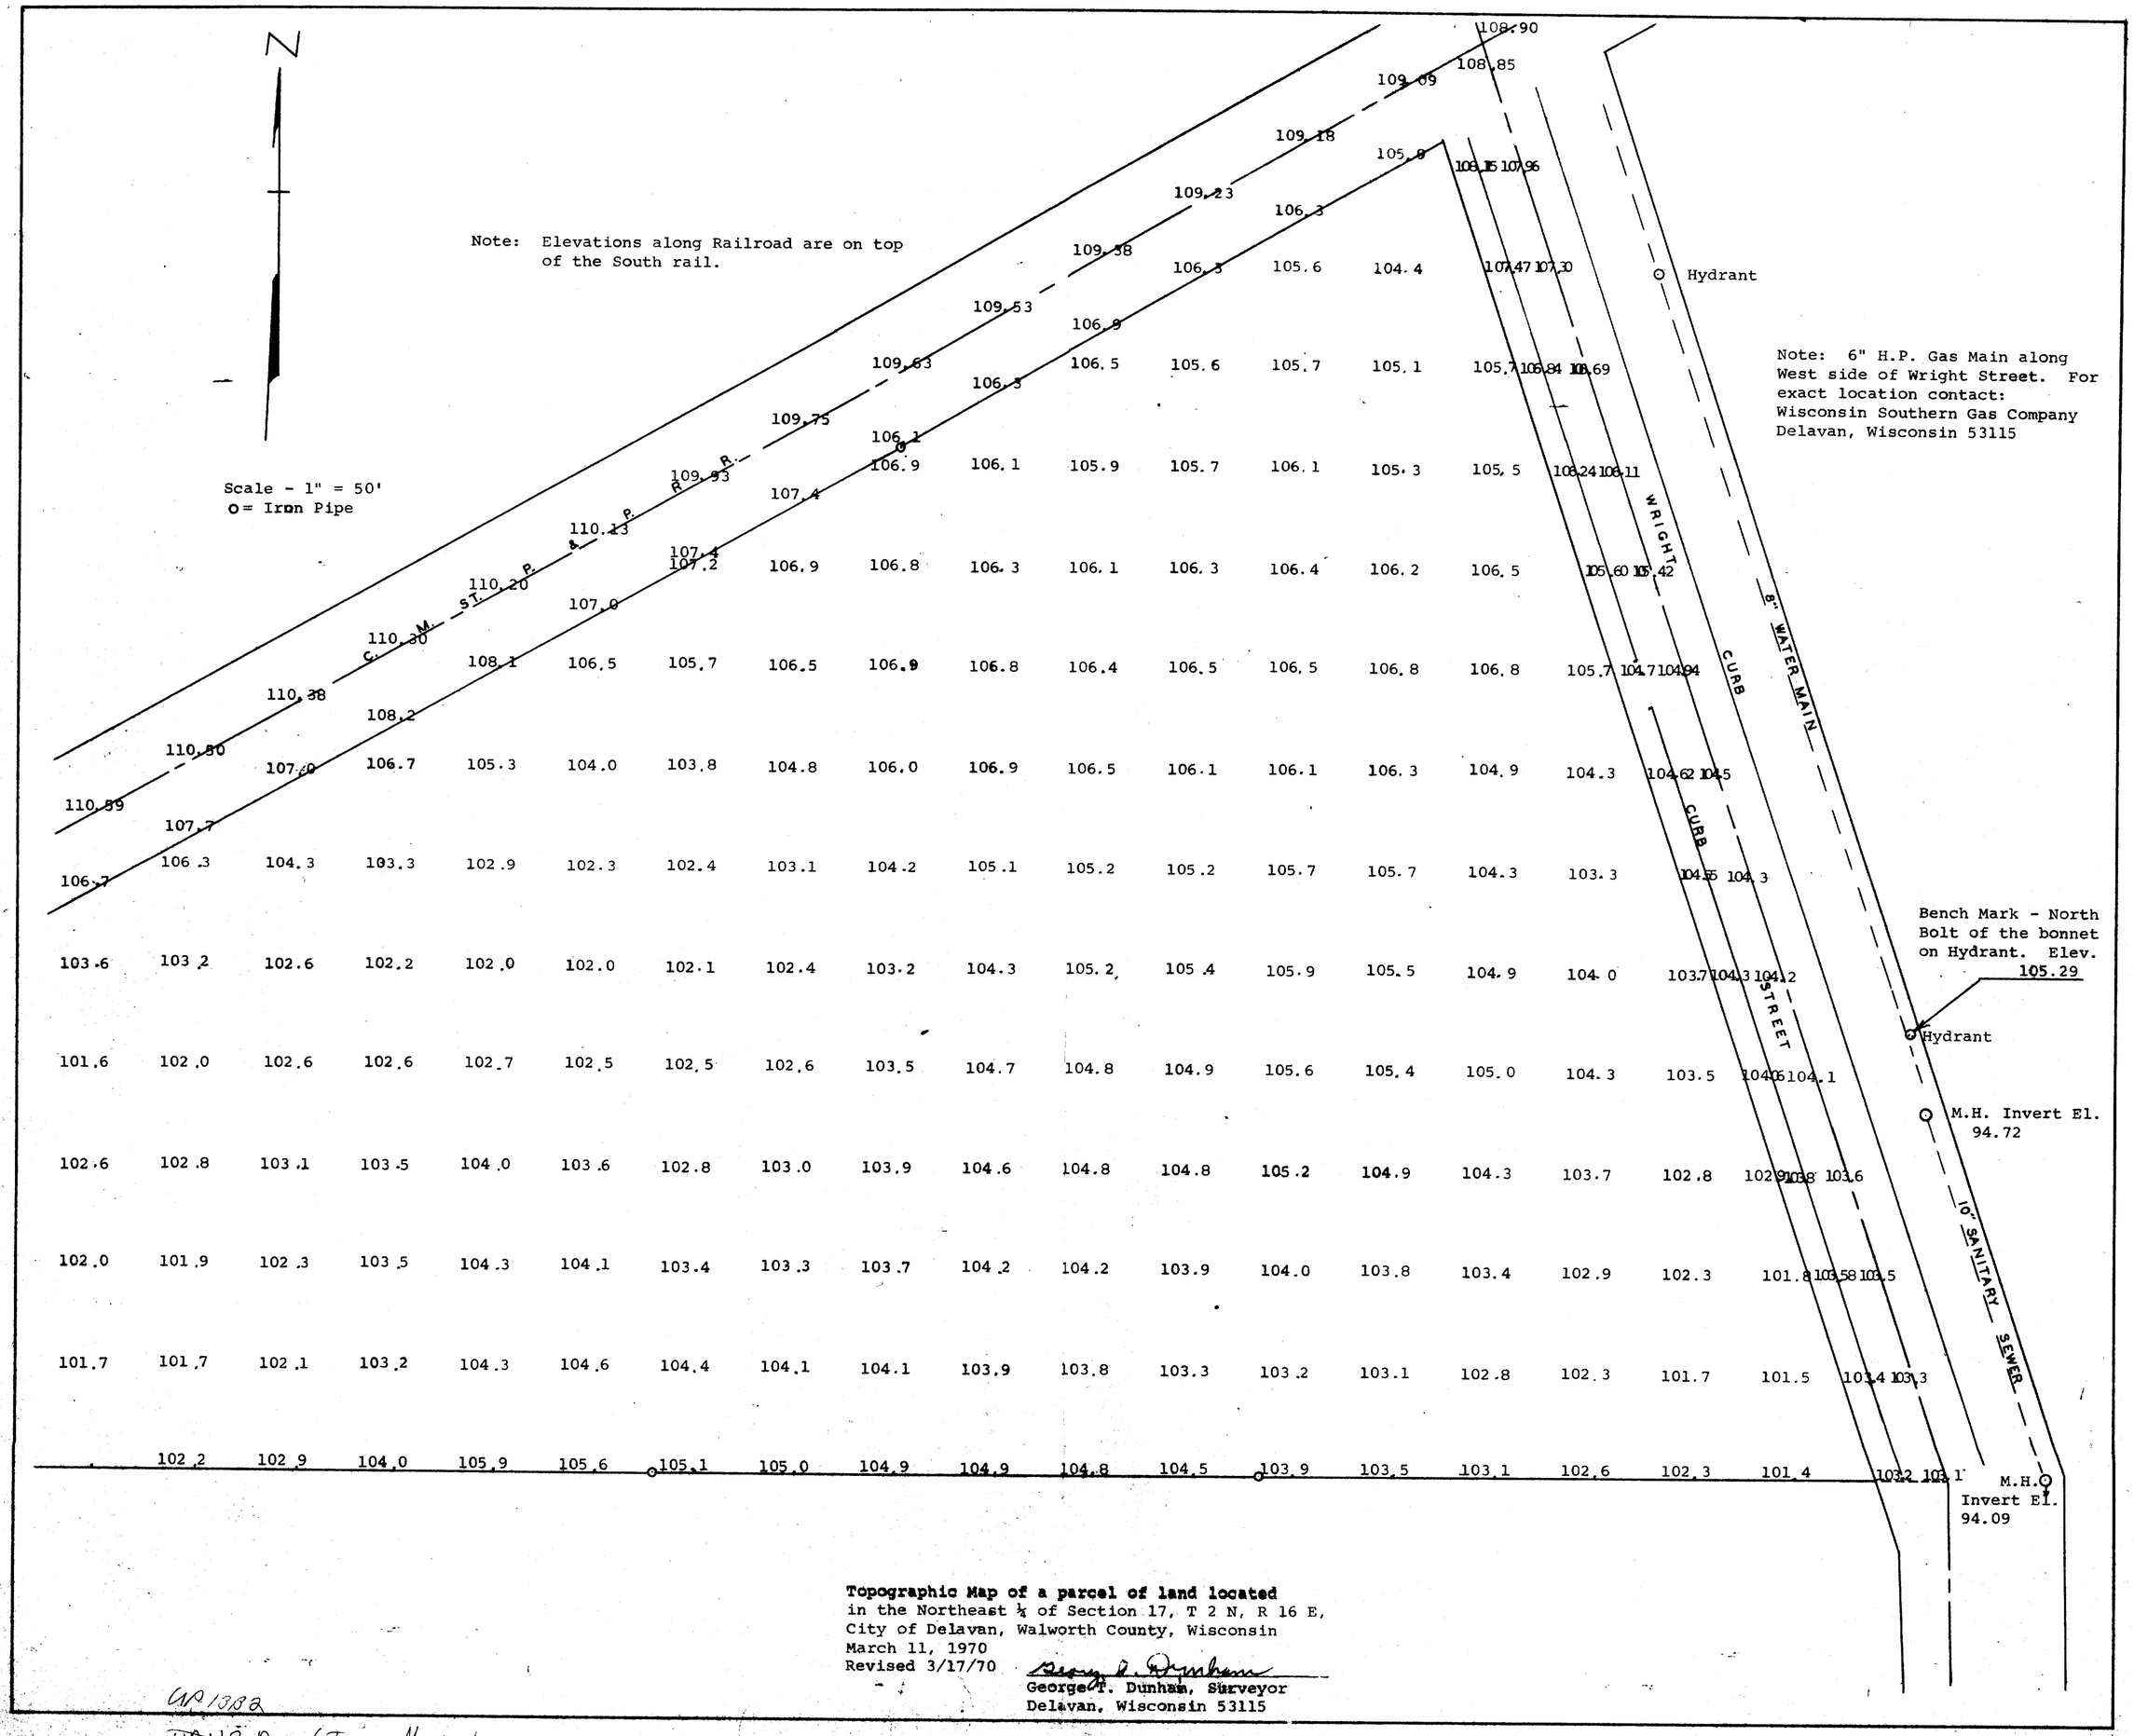

Topographic Map of a parcel of land located
in the Northeast ¼ of Section 17, T 2 N, R 16 E,
City of Delavan, Walworth County, Wisconsin
March 11, 1970
Revised 3/17/70

George T. Dunham, Surveyor
Delavan, Wisconsin 53115

UP 1382
~~UP-13B~~ = (Topo Map)

2-415