FARRIS, HANSEN & COOPER, INC.
ENGINEERING, SURVEYING AND LAND PLANNING
715 W. WALWORTH ST. - P.O. BOX 487 - ELKHORN, WI 53121
OFFICE: 414/723-2098

SEQUOIA STREET · 66' WIDE

LEGAL: THE EAST 70 FEET OF LOT 24 AND THE WEST 35 FEET OF LOT 25 OF TURTLE CREEK SUBDIVISION LOCATED IN THE SOUTHWEST 1/4 OF THE SOUTHEAST 1/4 OF SECTION 13, T 2 N, R 15 E, CITY OF DELAVAN, WALWORTH COUNTY, WISCONSIN.

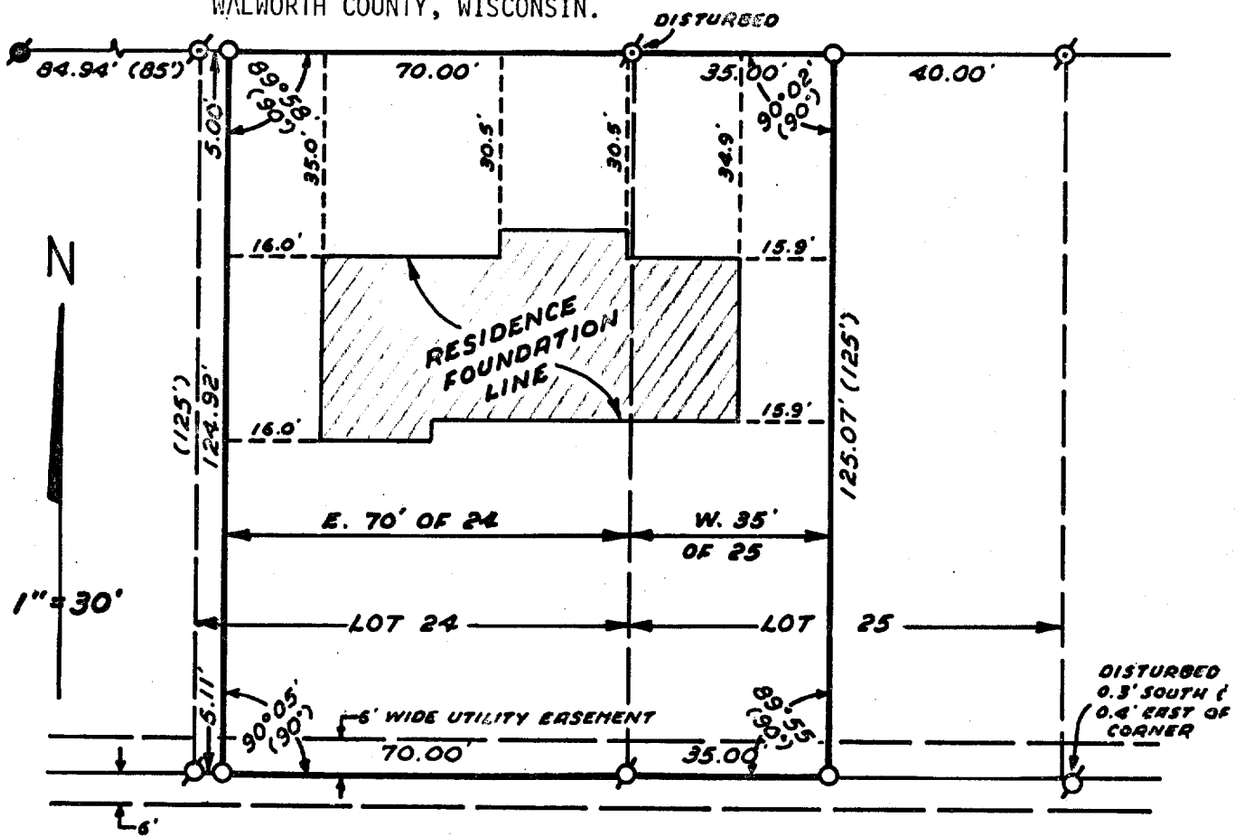

WORK ORDERED BY: Rockland Builders

LEGEND

- 1-1/4"±Dia. Iron Rod Found
- 3/4"±Dia. Iron Rod Found
- 1-1/4" Dia. Iron Pipe Found
- 1" Dia. x 24" Iron Pipe Set
- ( )—Record Dimension

WISCONSIN ROBERT A. FARRIS S-1293 ELKHORN, WIS. LAND SURVEYOR

I HEREBY CERTIFY that this PLAT OF SURVEY is a true and accurate representation of the lands described hereon and the location of the foundation of a residence under construction on said land to the best of my professional knowledge and belief.

Robert A. Farris

Robert A. Farris, RLS No. 1293

Dated this 24th day of Nov., 1981.

DRAWING NUMBER 1912

XTC-24A

2-652F