ABELL
SURVEYING & MAPPING
DELAVAN, WISCONSIN 53115
414-728-6737

RECEIVED
JUL 9 1986

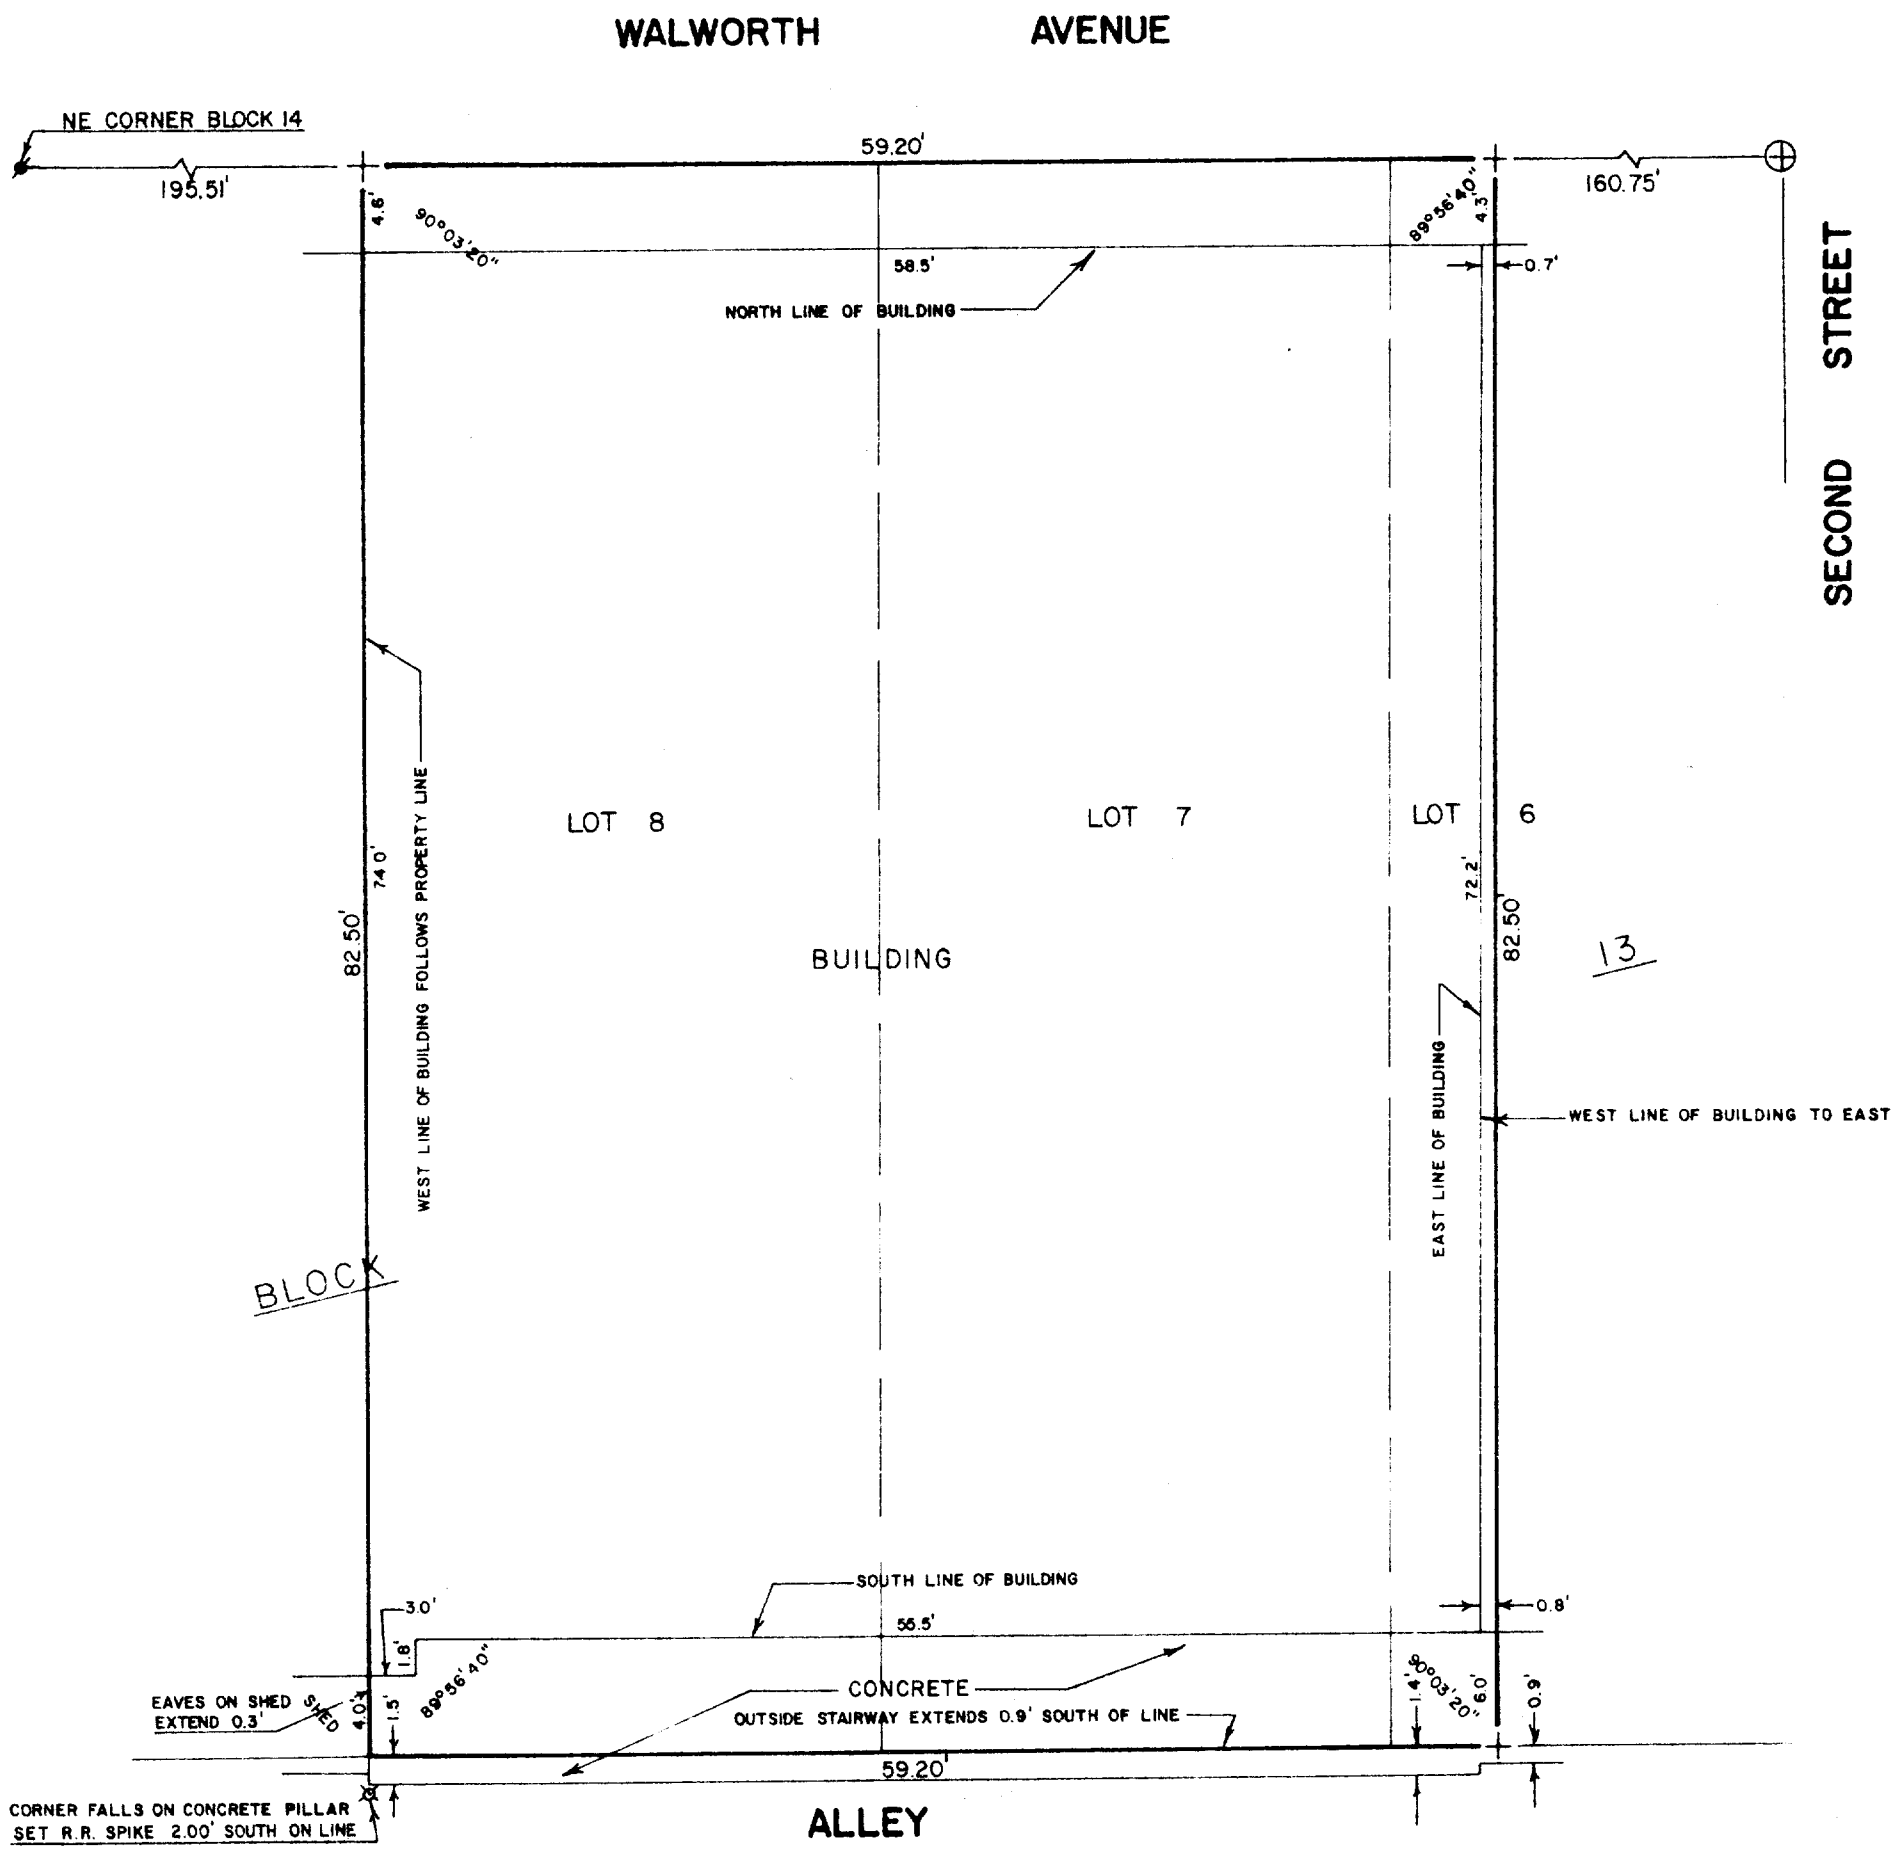

PLAT OF SURVEY OF

LOTS 6,7 AND 8, EXCEPT THE EAST 21 FEET OF LOT 6, BLOCK 13 OF THE ORIGINAL PLAT, CITY OF DELAVAN, WALWORTH COUNTY, WISCONSIN.

ORDERED BY: DR. DOUGLAS WILD
415 BROAD STREET
LAKE GENEVA, WI 53147

SCALE - 1"=10'

LEGEND
- CONCRETE MONUMENT FOUND
- CUT CROSS IN CONCRETE FOUND
- CUT CROSS IN CONCRETE SET
- RAILROAD SPIKE SET

I, DAVID F. ABELL, DO HEREBY CERTIFY THAT I HAVE SURVEYED THE PROPERTY HEREON DESCRIBED ACCORDING TO THE OFFICIAL RECORDS, AND THAT THE PLAT HEREON IS A CORRECT REPRESENTATION OF THE PROPERTY LINES TO THE BEST OF MY KNOWLEDGE AND BELIEF.

David F. Abell
DAVID F. ABELL
WISCONSIN REGISTERED LAND SURVEYOR, S-1596

June 19, 1986
DATE JOB NUMBER - 86015

XOP-00127

2-705-A