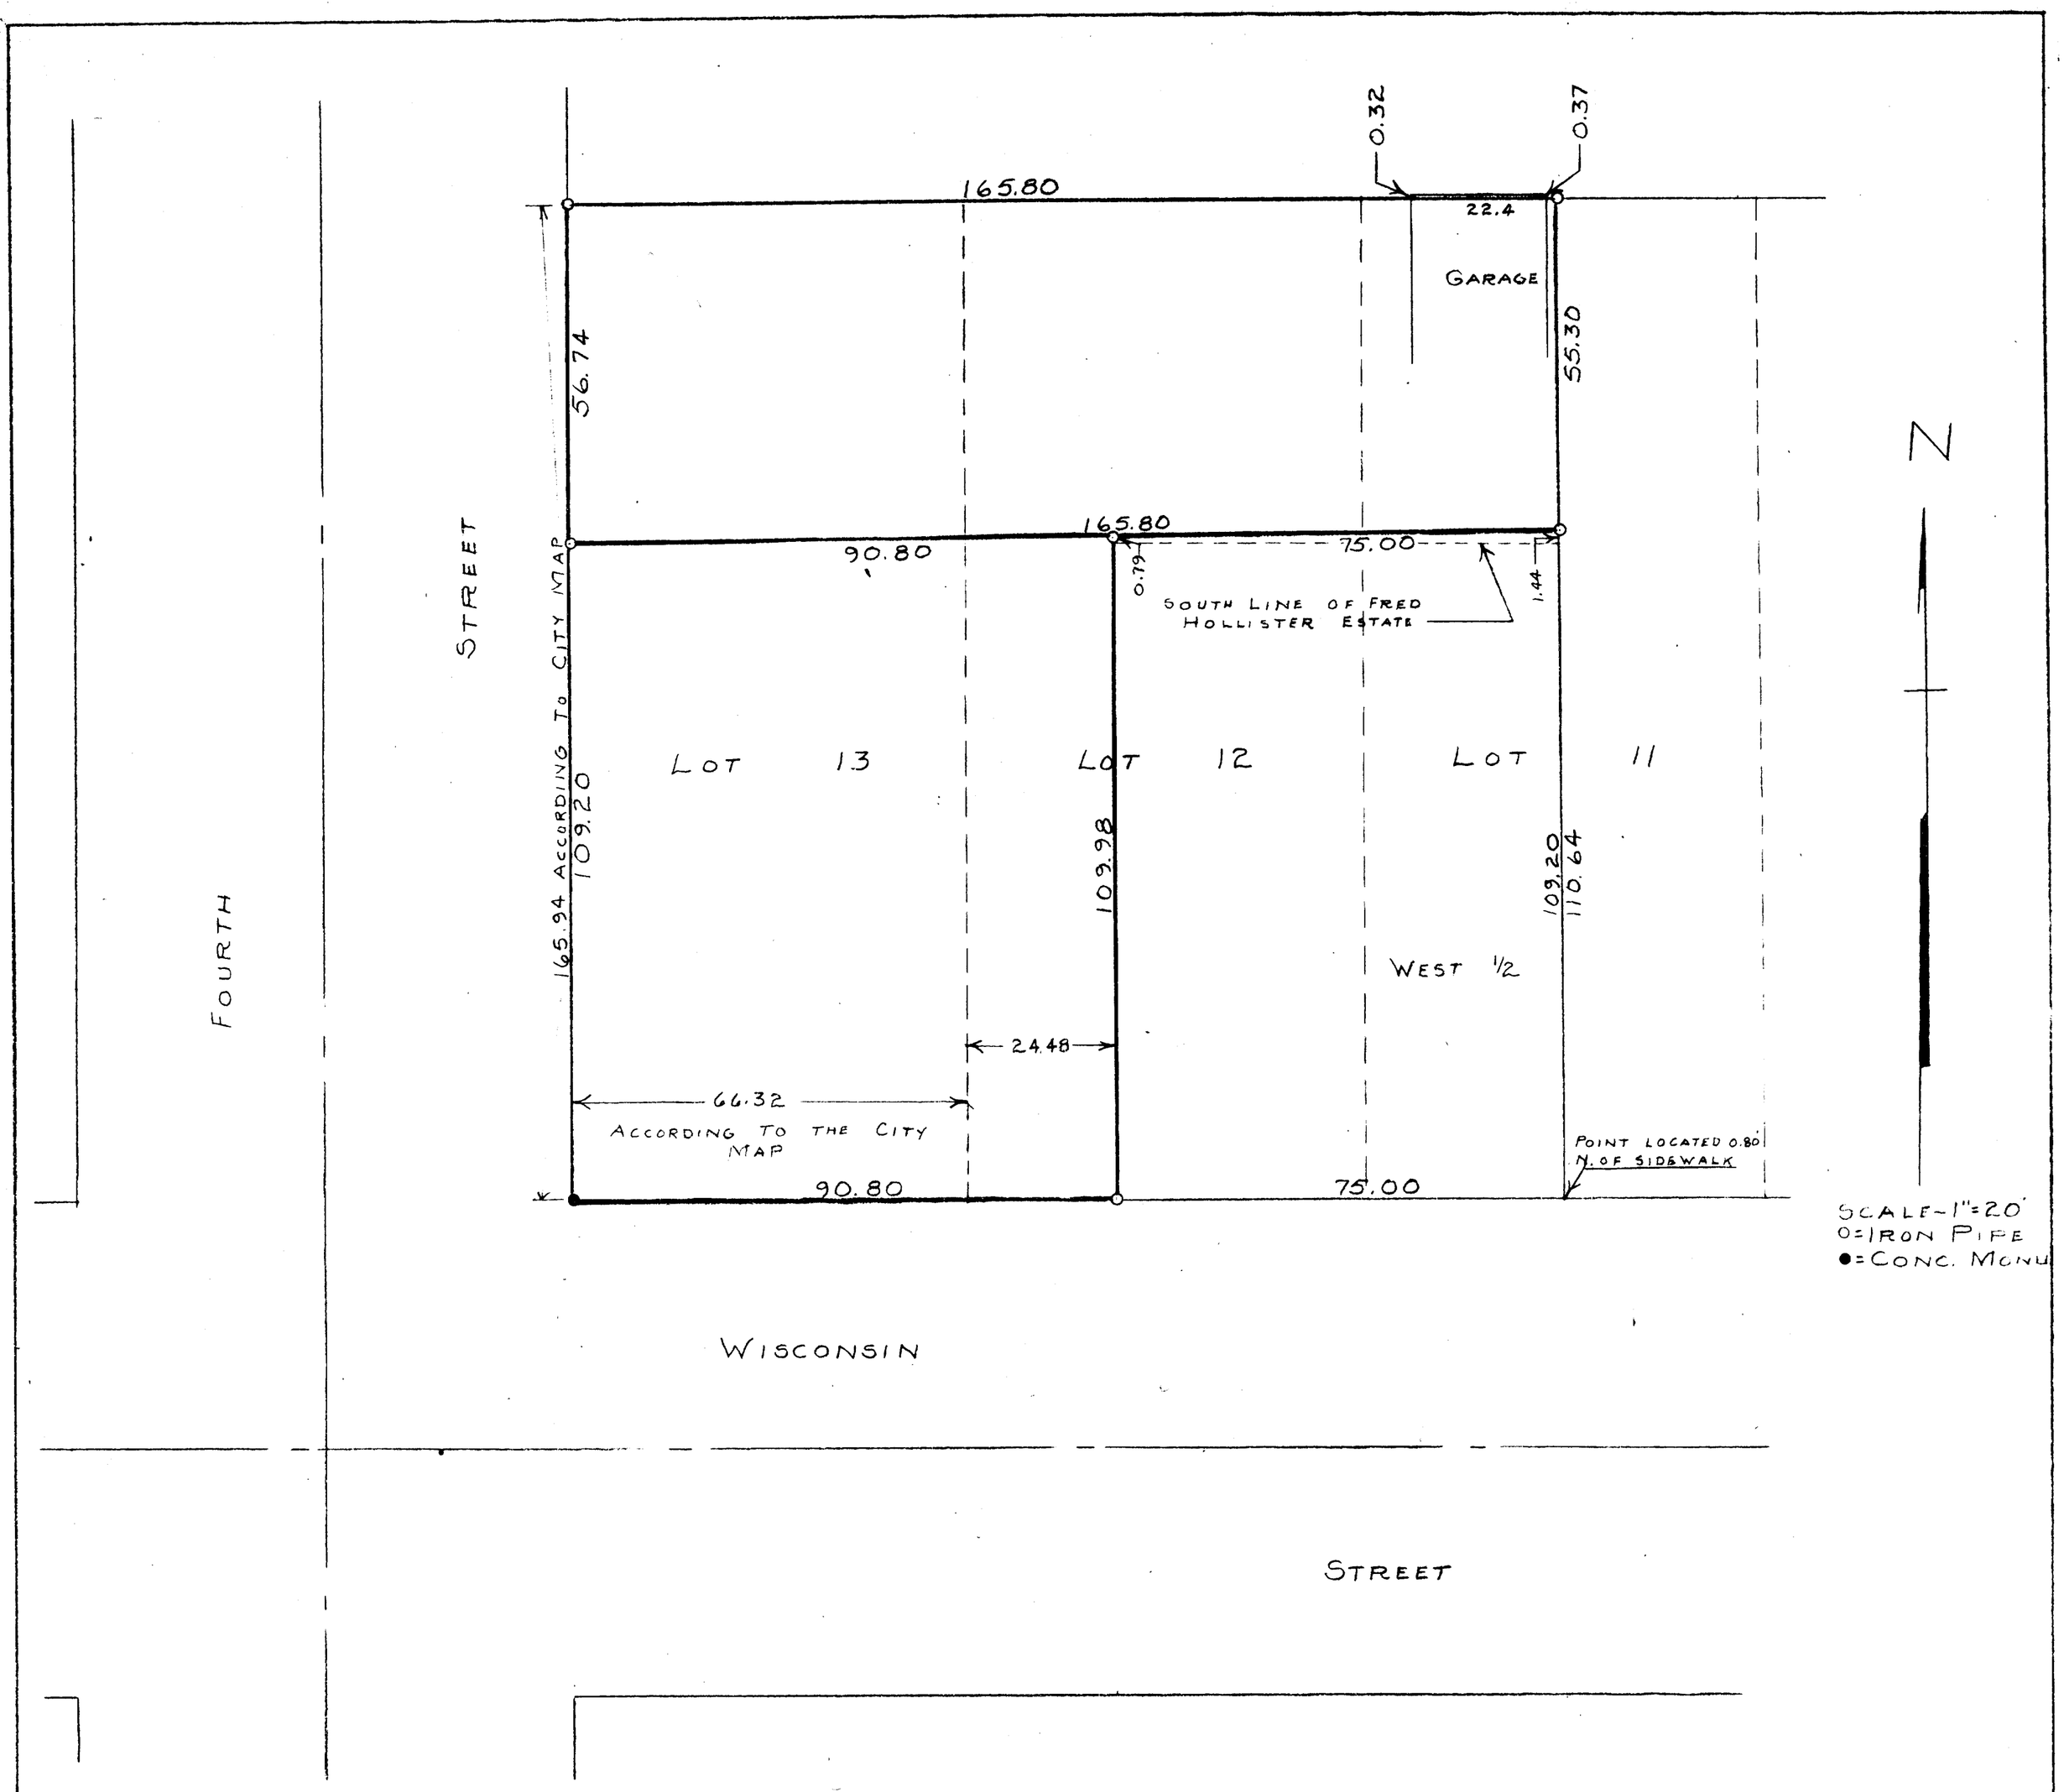

PLAT OF SURVEY OF LAND LOCATED IN LOTS 13, 12, AND THE WEST 1/2 OF LOT 11, BLOCK 2, PASSAGE, ARAM, AND DOWNIE ADDITION TO THE CITY OF DELAVAN, WALWORTH COUNTY, WISCONSIN
DEC. 23, 1957
REVISED MARCH 21, 1958

George T. Dunham
GEORGE T. DUNHAM, SURVEYOR
DELAVAN, WISCONSIN

STATE OF WISCONSIN)
WALWORTH COUNTY) SS

I, GEORGE T. DUNHAM, DO HEREBY CERTIFY THAT I HAVE SURVEYED THE PROPERTY DESCRIBED AS FOLLOWS:

THE WEST 1/2 OF LOT 11, LOT 12 AND LOT 13, BLOCK 2 OF PASSAGE, ARAM, AND DOWNIE ADDITION TO THE CITY OF DELAVAN, WALWORTH COUNTY, WISCONSIN

AND THAT THE PLAT SHOWN ABOVE IS A CORRECT REPRESENTATION OF THE PROPERTY LINES
JUNE 2, 1959

George T. Dunham
GEORGE T. DUNHAM, SURVEYOR
DELAVAN, WISCONSIN

XP-28
" -28B