ABELL
SURVEYING & MAPPING

DELAVAN. WISCONSIN 53115

414-728-6737

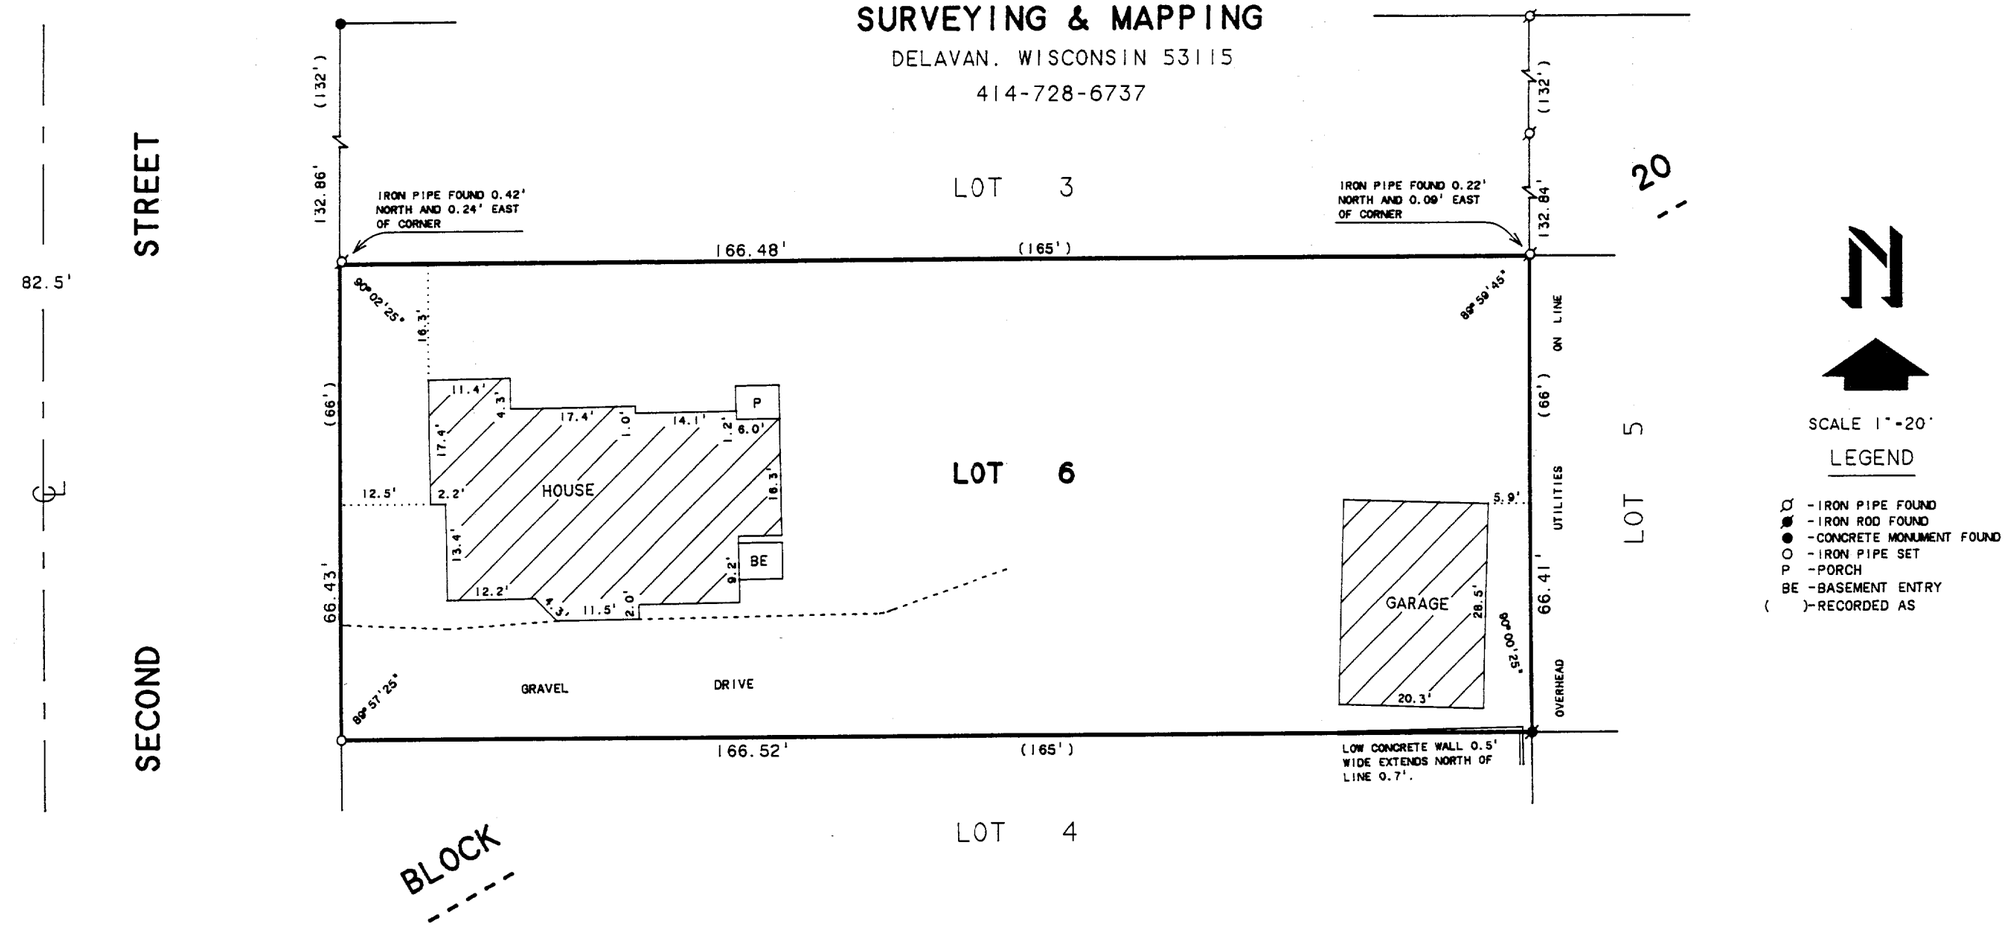

SCALE 1"=20'

LEGEND

- -IRON PIPE FOUND
- -IRON ROD FOUND
- -CONCRETE MONUMENT FOUND
- -IRON PIPE SET
- P -PORCH
- BE -BASEMENT ENTRY
- ( )-RECORDED AS

PLAT OF SURVEY OF

LOT 6. BLOCK 20. OF THE ORIGINAL PLAT OF THE CITY OF DELAVAN. WALWORTH COUNTY. WISCONSIN.

I HEREBY CERTIFY THAT I HAVE SURVEYED THE ABOVE DESCRIBED PROPERTY AND THAT THE ABOVE MAP IS A TRUE REPRESENTATION THEREOF AND SHOWS THE SIZE AND LOCATION OF THE PROPERTY. ITS EXTERIOR BOUNDARIES. THE LOCATION OF ALL VISIBLE STRUCTURES AND DIMENSIONS OF ALL PRINCIPAL BUILDINGS THEREON. BOUNDARY FENCES. APPARENT EASEMENTS. ROADWAYS AND VISIBLE ENCROACHMENTS. IF ANY. TO THE BEST OF MY KNOWLEDGE AND BELIEF.

THIS SURVEY IS MADE FOR THE USE OF THE PRESENT OWNERS OF THE PROPERTY. AND ALSO THOSE WHO PURCHASE. MORTGAGE. OR GUARANTEE THE TITLE THERETO WITHIN ONE (1) YEAR FROM DATE HEREON.

David F. Abell

DAVID F. ABELL
WISCONSIN REGISTERED LAND SURVEYOR. S-1596

ORDERED BY: RE/MAX-LAKES AREA REALTORS
1815 N. SHORE DRIVE
DELAVAN. WI. 53115

RECEIVED
MAY 6 1992

January 31, 1992

DATE JOB NUMBER - 92010

NOTE: THIS IS NOT A CERTIFIED COPY UNLESS SEALED.

002-1153

XOP-210