DUNHAM SURVEYING, S.C.

Delavan, Wisconsin 53115

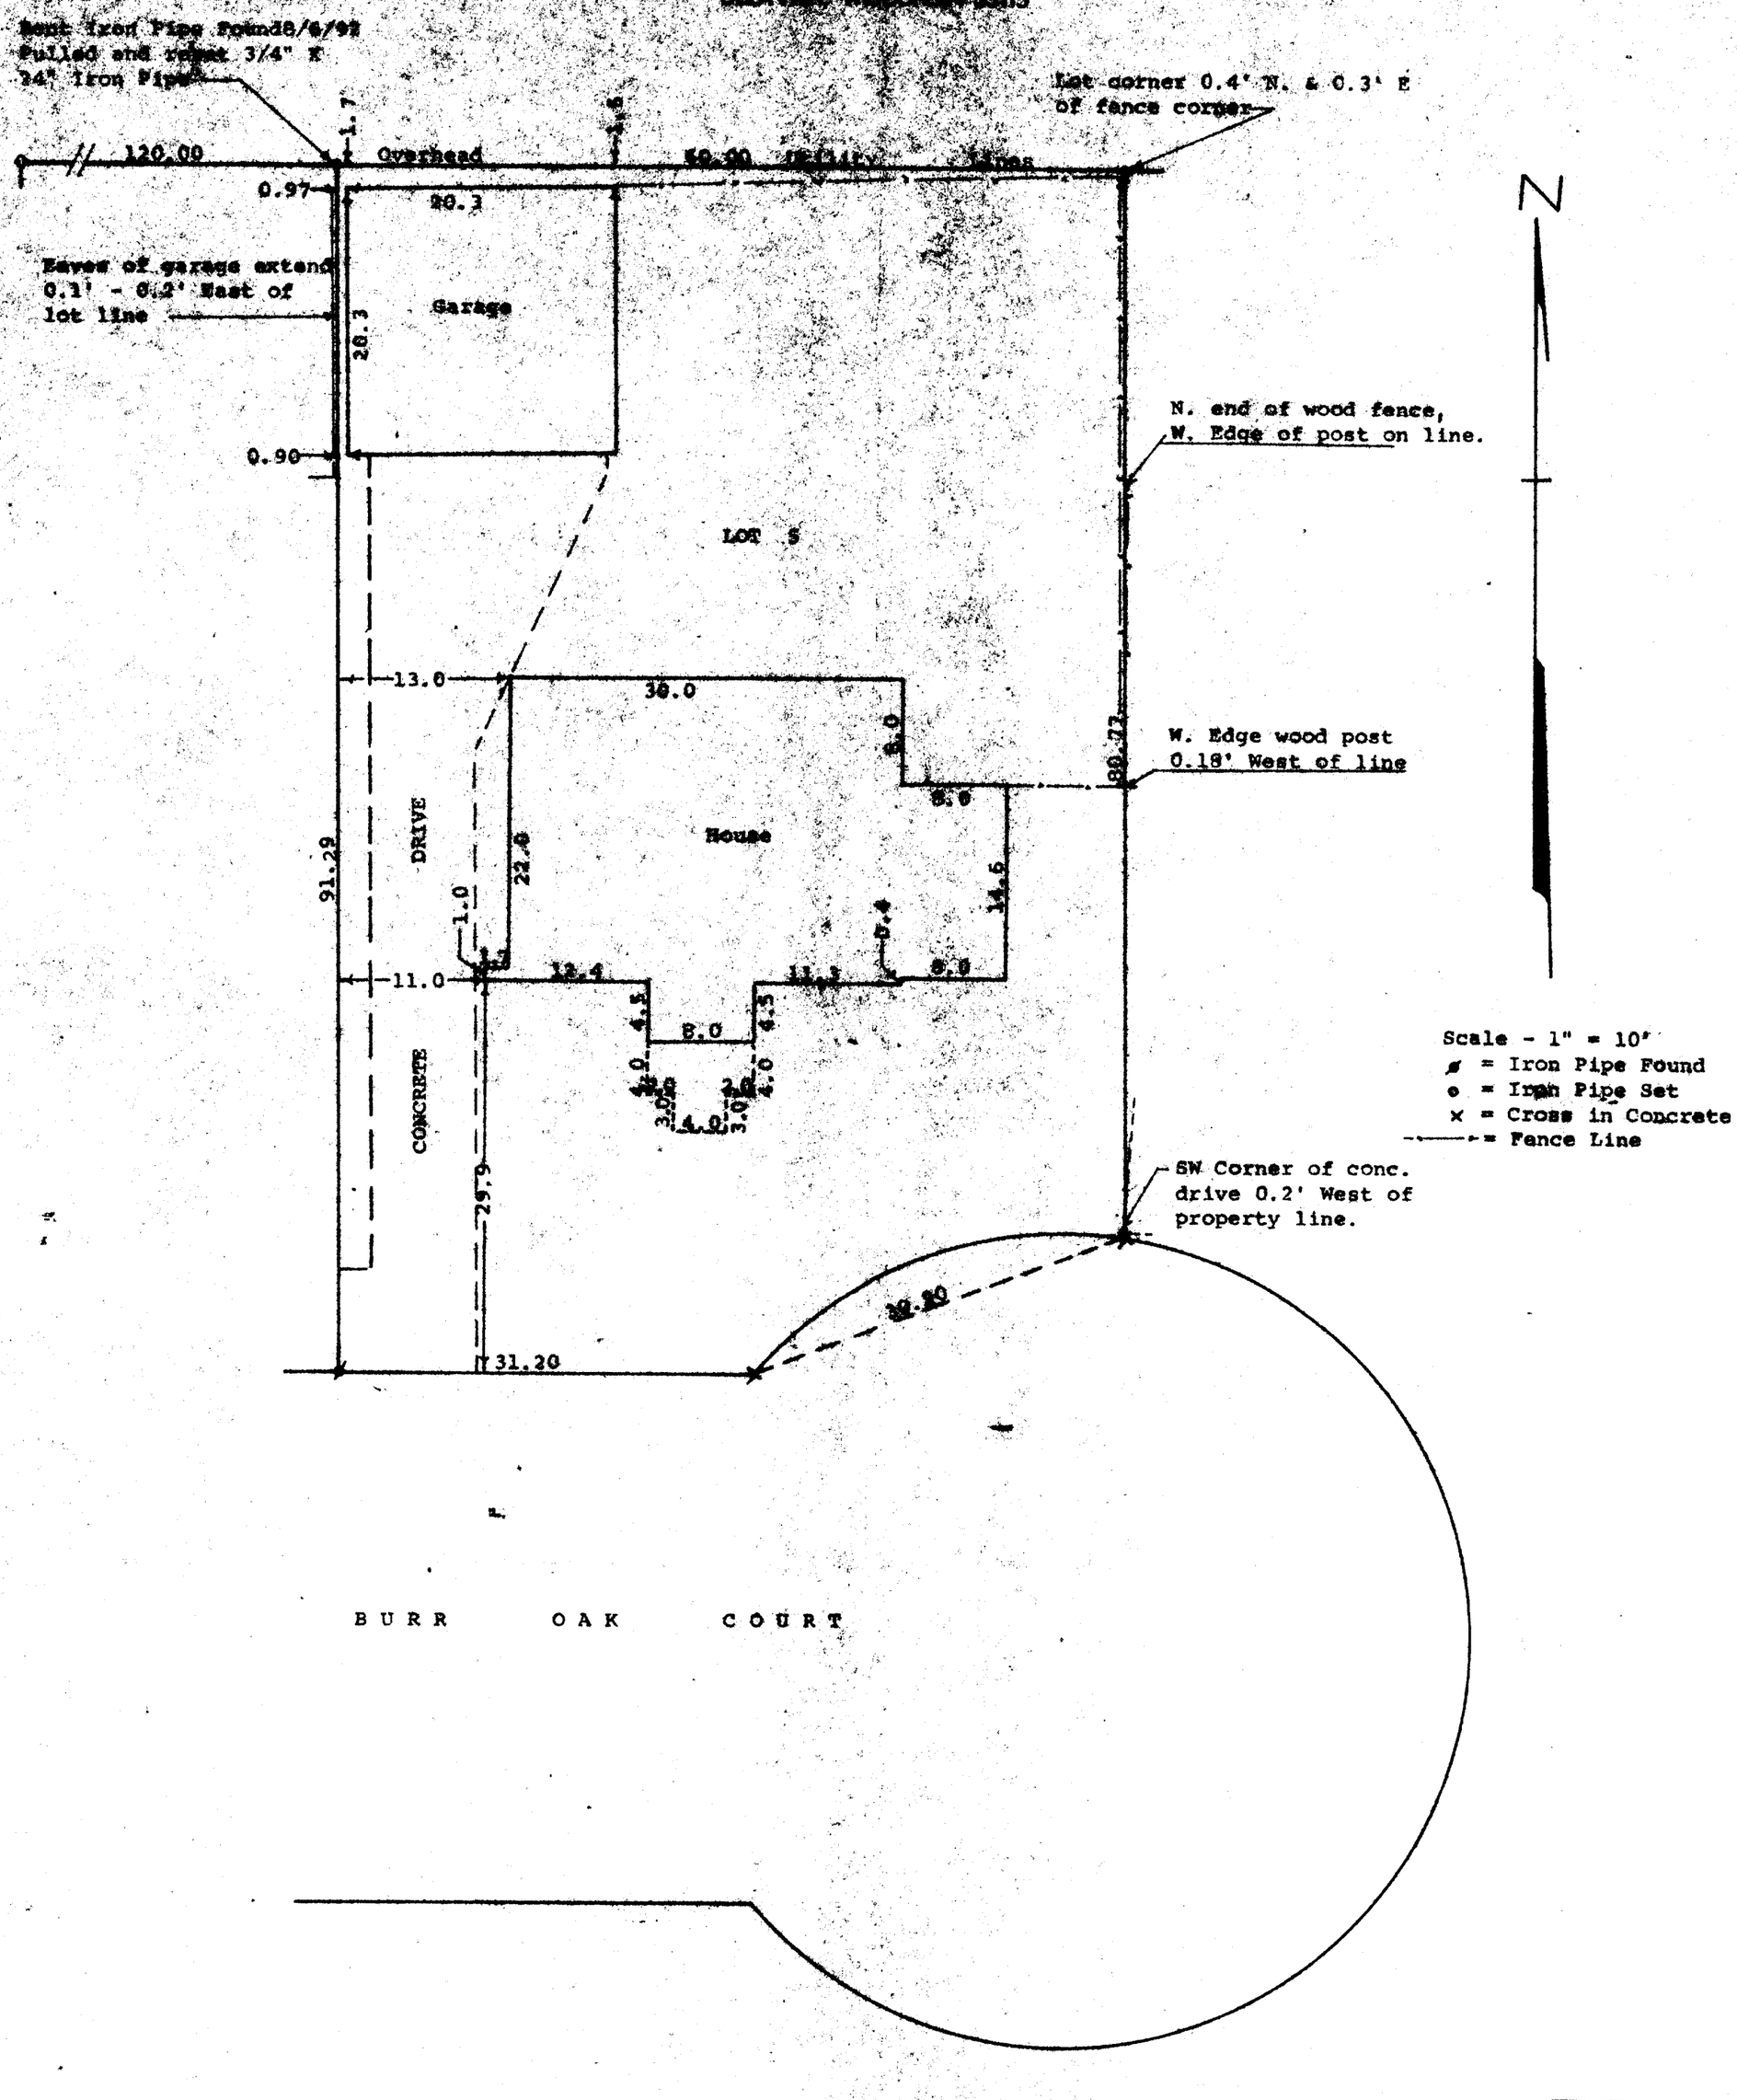

BURR OAK COURT

STATE OF WISCONSIN)
COUNTY OF WALWORTH) ss

I, George T. Dunham, Surveyor, certify that I have surveyed the property described as follows.

Lot 5 of Burr Oak Subdivision, located in the City of Delavan, Walworth County, Wisconsin,

and the above plat is a true representation thereof and shows the size and location of the property, its exterior boundaries, the location and dimensions of all structures thereon, fences, apparent easements and roadways and visible encroachments, if any.

This survey is made for the exclusive use of the present owners of the property, and also those who purchase, mortgage, or guarantee the title thereto within one (1) year from date hereof, and as to them I warrant the accuracy of said survey and map.

December 8, 1976
Updated and recertified to this 4th day of August, 1992

George T. Dunham, Surveyor

WISCONSIN LAND SURVEYOR
GEORGE T. DUNHAM
S-306
DELAVAN WIS.

RECEIVED
FEB 1 1 1993

XBU-1210

XBU-5 2-577