


SURVEYING & SUBDIVIDING
DELAVER, WISCONSIN

1

✓

○ = Iron Pipe

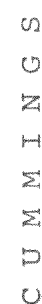

A parcel of land located in the Southwest $\frac{1}{4}$ of Section 18, T 2 N, R 16 E, City of Delavan, Walworth County, Wisconsin, described as follows, to-wit: Commencing at the intersection of the south line of Walworth Avenue and the west line of Walnut Street in said Southwest $\frac{1}{4}$; thence South along the west line of Walnut Street 261.58 feet; thence west parallel to the south line of Walworth Avenue, 221.12 feet to the place of beginning; thence north parallel with the west line of Walnut Street 141.58 feet; thence west parallel with the south line of Walworth Avenue 160.44 feet to the east line of Cummings Street; thence South along the east line of Cummings Street 141.58 feet to the north line of Schauf Street; thence east along the north line of Schauf Street 160.92 feet to the place of beginning.

June 22, 1964

George T. Dunham
George T. Dunham, Surveyor