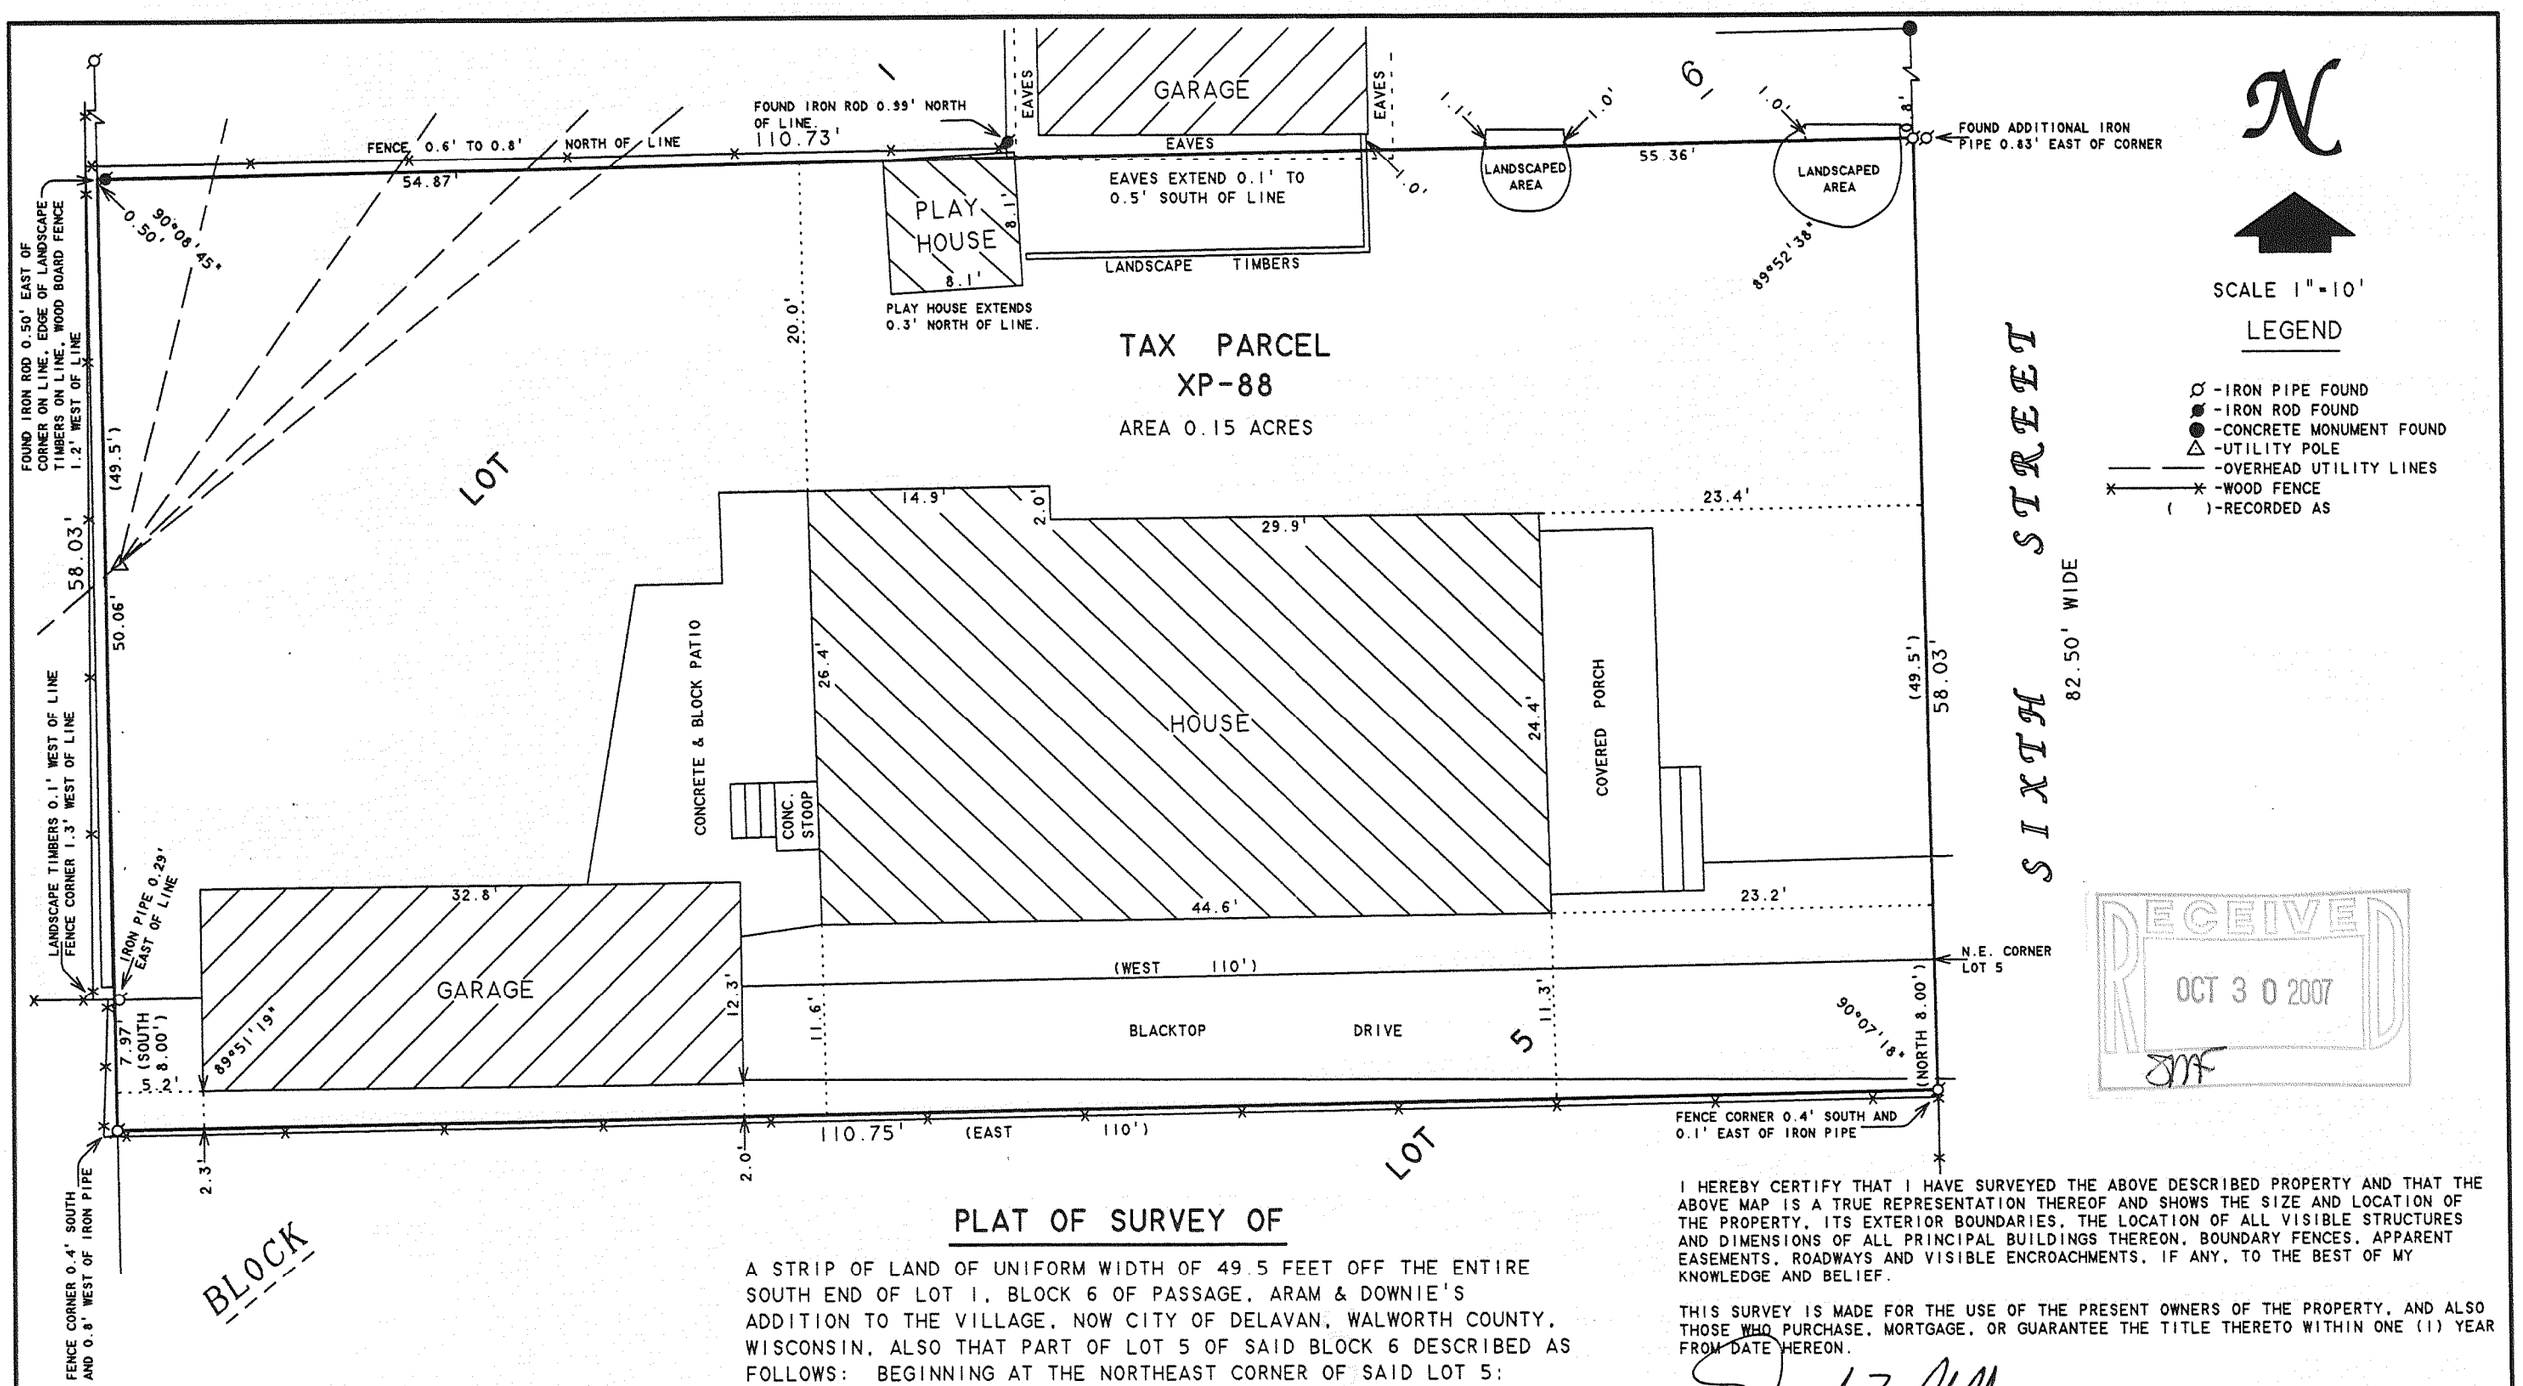

RECEIVED
OCT 30 2007
JMF

PLAT OF SURVEY OF

A STRIP OF LAND OF UNIFORM WIDTH OF 49.5 FEET OFF THE ENTIRE SOUTH END OF LOT 1, BLOCK 6 OF PASSAGE, ARAM & DOWNIE'S ADDITION TO THE VILLAGE, NOW CITY OF DELAVAN, WALWORTH COUNTY, WISCONSIN, ALSO THAT PART OF LOT 5 OF SAID BLOCK 6 DESCRIBED AS FOLLOWS: BEGINNING AT THE NORTHEAST CORNER OF SAID LOT 5: RUNNING THENCE WEST ALONG THE NORTH LINE OF SAID LOT, 110 FEET: THENCE SOUTH 8 FEET: THENCE EAST 110 FEET TO THE EAST LINE OF SAID LOT: THENCE NORTH ALONG THE EAST LINE OF SAID LOT, 8 FEET TO THE PLACE OF BEGINNING.

I HEREBY CERTIFY THAT I HAVE SURVEYED THE ABOVE DESCRIBED PROPERTY AND THAT THE ABOVE MAP IS A TRUE REPRESENTATION THEREOF AND SHOWS THE SIZE AND LOCATION OF THE PROPERTY, ITS EXTERIOR BOUNDARIES, THE LOCATION OF ALL VISIBLE STRUCTURES AND DIMENSIONS OF ALL PRINCIPAL BUILDINGS THEREON, BOUNDARY FENCES, APPARENT EASEMENTS, ROADWAYS AND VISIBLE ENCROACHMENTS, IF ANY, TO THE BEST OF MY KNOWLEDGE AND BELIEF.

THIS SURVEY IS MADE FOR THE USE OF THE PRESENT OWNERS OF THE PROPERTY, AND ALSO THOSE WHO PURCHASE, MORTGAGE, OR GUARANTEE THE TITLE THERETO WITHIN ONE (1) YEAR FROM DATE HEREON.

David F. Abell

DAVID F. ABELL
WISCONSIN REGISTERED LAND SURVEYOR, S-1596

September 18, 2007
DATE

JOB NUMBER - 88088A

NOTE: THIS IS NOT A CERTIFIED COPY UNLESS SEALED.

ORDERED BY: RE/MAX-LAKES AREA REALTORS
1815 N. SHORE DRIVE
DELAVAN, WI. 53115

ABELL
SURVEYING & MAPPING
1140 SEQUOIA STREET • DELAVAN, WISCONSIN 53115
262-728-6737

XP-88

002-2408