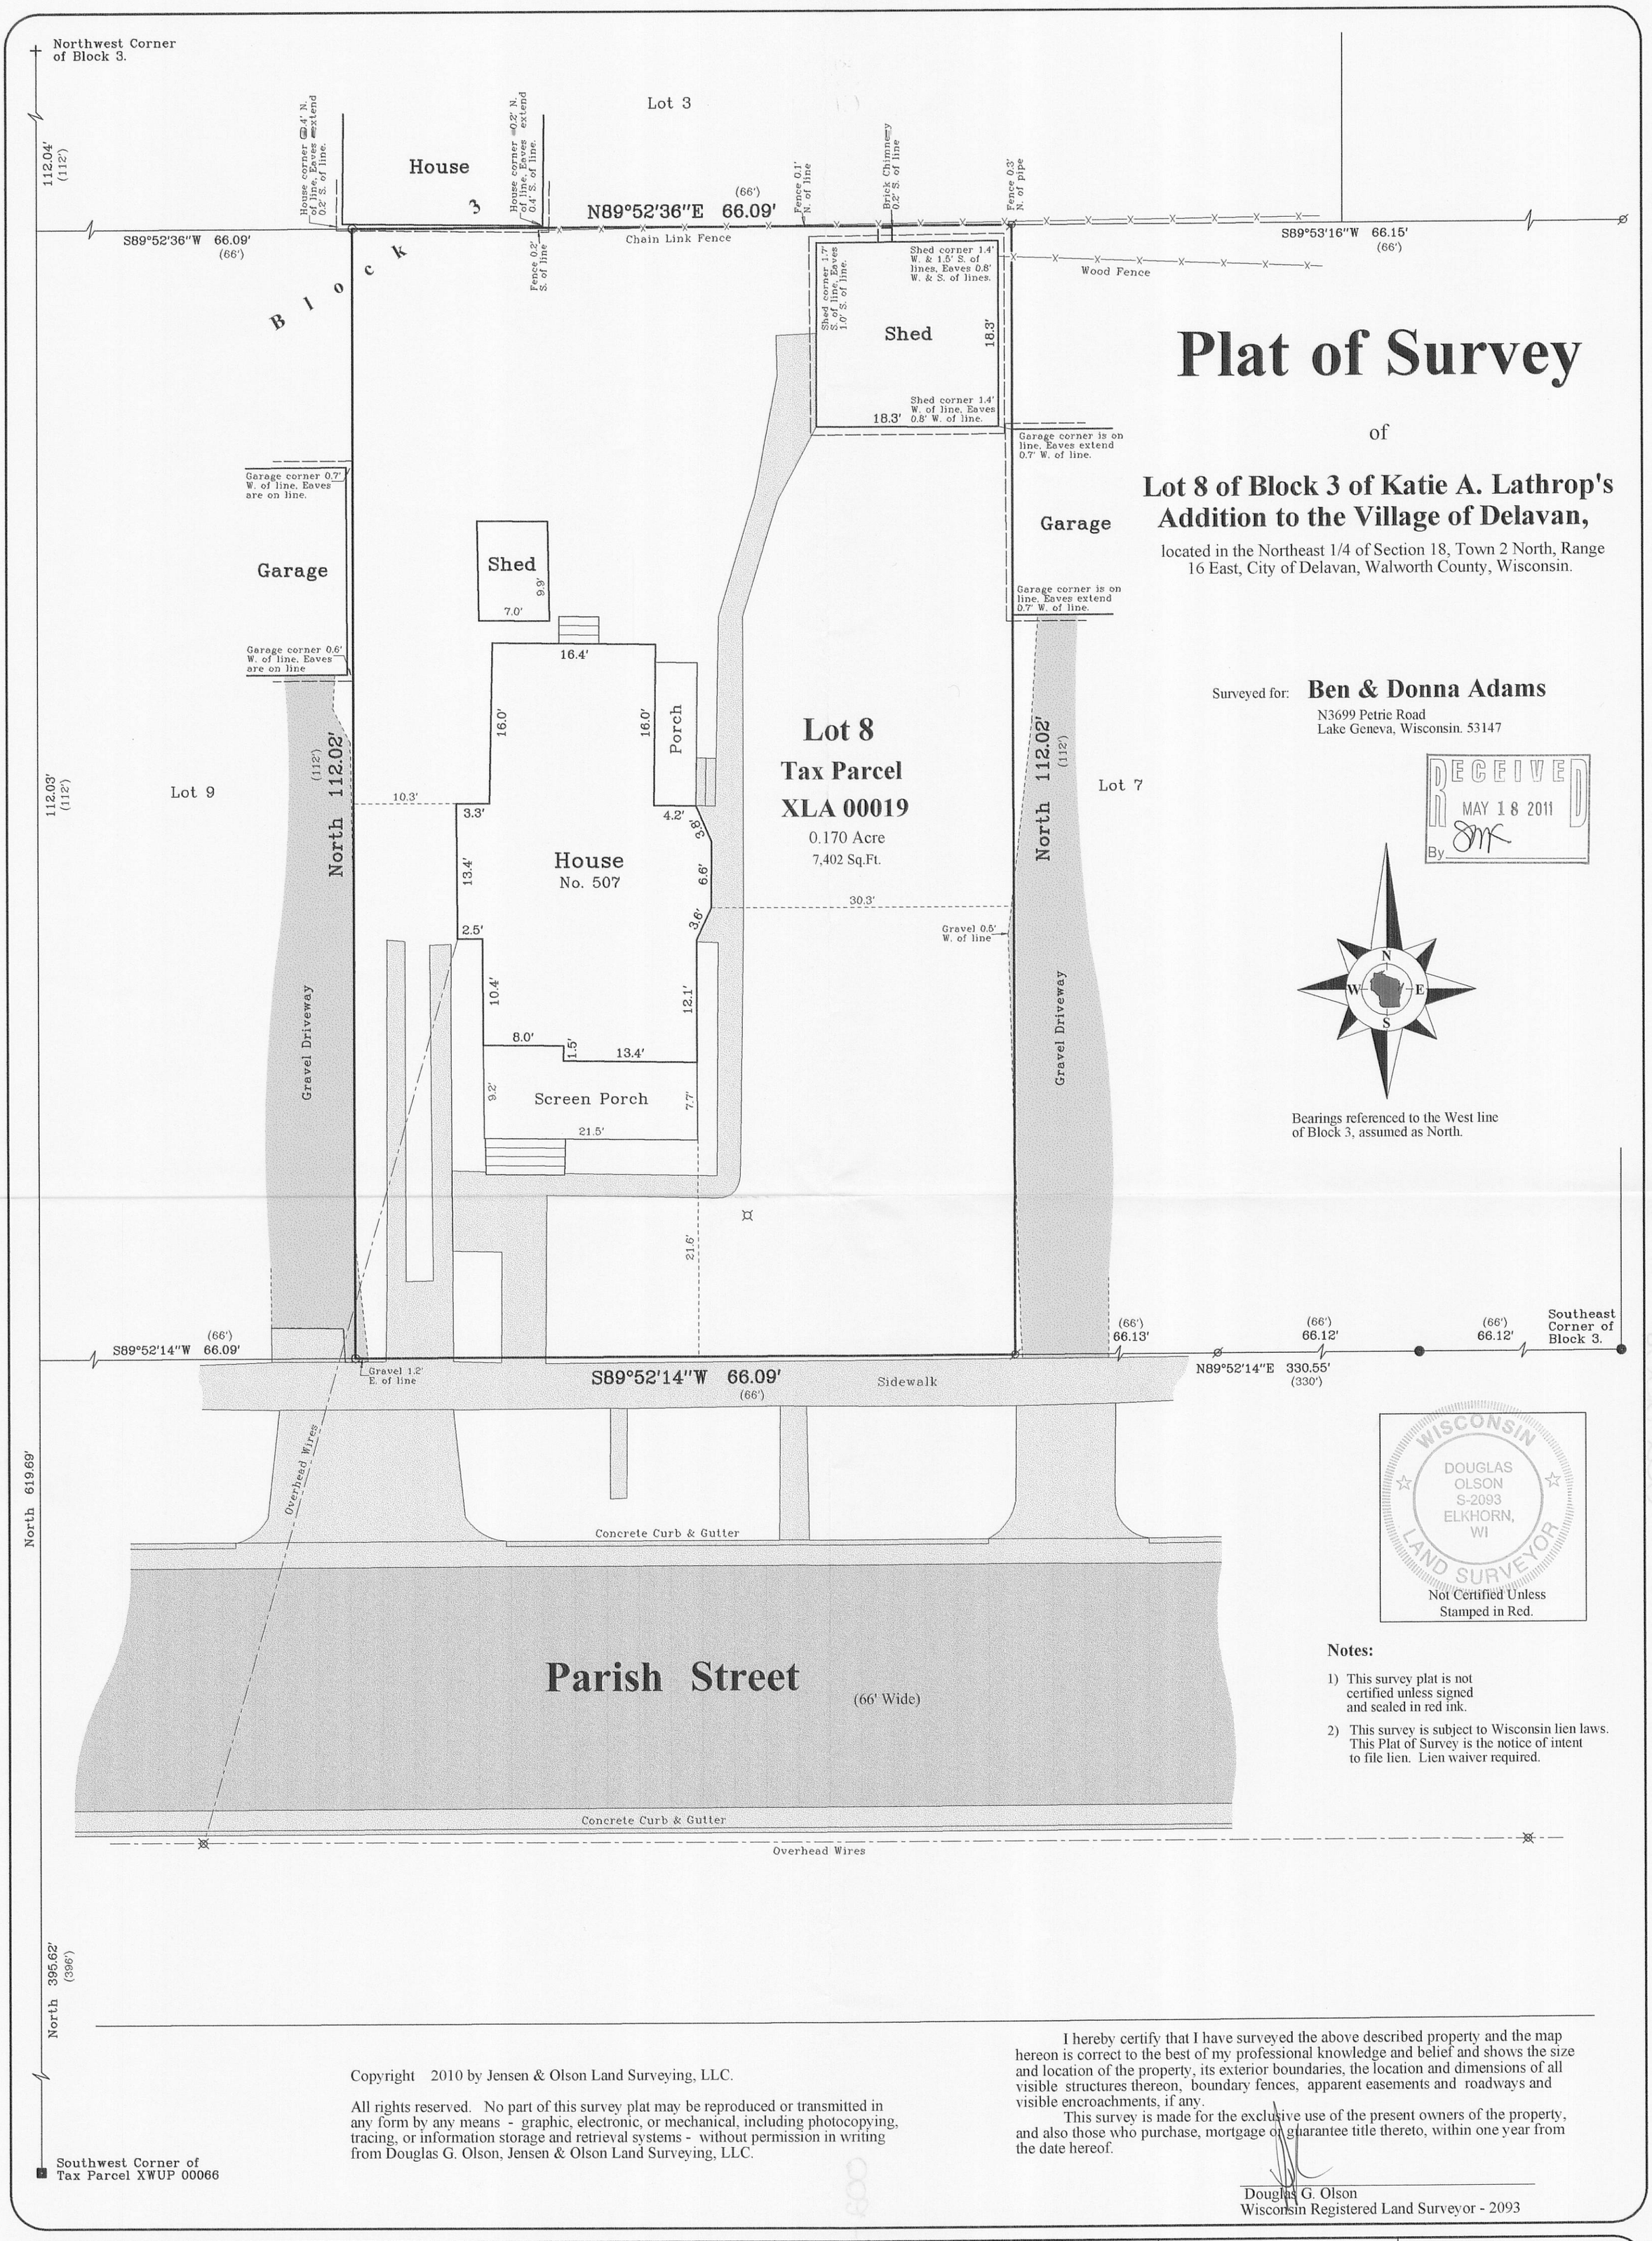

Plat of Survey

of

Lot 8 of Block 3 of Katie A. Lathrop's Addition to the Village of Delavan,

located in the Northeast 1/4 of Section 18, Town 2 North, Range 16 East, City of Delavan, Walworth County, Wisconsin.

Surveyed for: **Ben & Donna Adams**
N3699 Petrie Road
Lake Geneva, Wisconsin. 53147

RECEIVED
MAY 18 2011
By

Bearings referenced to the West line of Block 3, assumed as North.

WISCONSIN
DOUGLAS OLSON
S-2093
ELKHORN, WI
LAND SURVEYOR

Not Certified Unless Stamped in Red.

Notes:

1) This survey plat is not certified unless signed and sealed in red ink.

2) This survey is subject to Wisconsin lien laws. This Plat of Survey is the notice of intent to file lien. Lien waiver required.

Copyright 2010 by Jensen & Olson Land Surveying, LLC.

All rights reserved. No part of this survey plat may be reproduced or transmitted in any form by any means - graphic, electronic, or mechanical, including photocopying, tracing, or information storage and retrieval systems - without permission in writing from Douglas G. Olson, Jensen & Olson Land Surveying, LLC.

I hereby certify that I have surveyed the above described property and the map hereon is correct to the best of my professional knowledge and belief and shows the size and location of the property, its exterior boundaries, the location and dimensions of all visible structures thereon, boundary fences, apparent easements and roadways and visible encroachments, if any.

This survey is made for the exclusive use of the present owners of the property, and also those who purchase, mortgage or guarantee title thereto, within one year from the date hereof.

Douglas G. Olson
Wisconsin Registered Land Surveyor - 2093

2010-0960

Sheet 1 of 1 Sheets

Drawing Name: t2nr16e-2010096-2010096Plat.scj

Job Reference Number
2010-096

Legend
- Found Concrete Monument
- Found Chiselled Cross
- Found Iron Pipe
- Found Iron Rod
- Set Iron Rod, 3/4" dia.
- ( ) Recorded Information
- Utility Pole
- Lamp

Jensen & Olson Land Surveying, LLC
45 South Wisconsin Street * P.O. Box 322 * Elkhorn, Wisconsin. 53121
Telephone: (262) 723-3434 * Facsimile: (262) 723-8044

Scale in Feet
1" = 10'
0' 5' 10' 20'

Survey Date: Sept. 27, 2010.
Revisions: