


Plat of Survey


of
**Lot 6 & the West 1/2 of Lot 7 in
 Block 2 of Sunny Side Subdivision,**

located in the Northeast 1/4 of Section 17, Town 2 North,
 Range 16 East, City of Delavan, Walworth County, Wisconsin.


Surveyed for: **Shorewest Realtors**
 830 East Geneva Street
 Delavan, Wisconsin. 53115

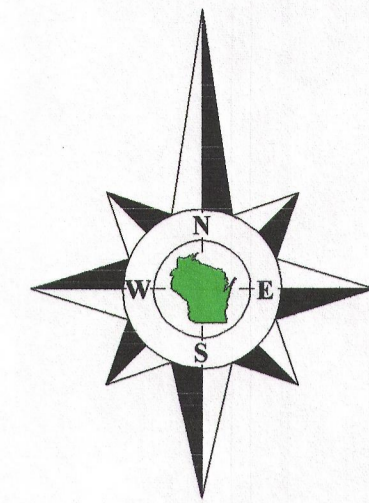


Bearings reference to the plat
 of Sunny Side Subdivision.

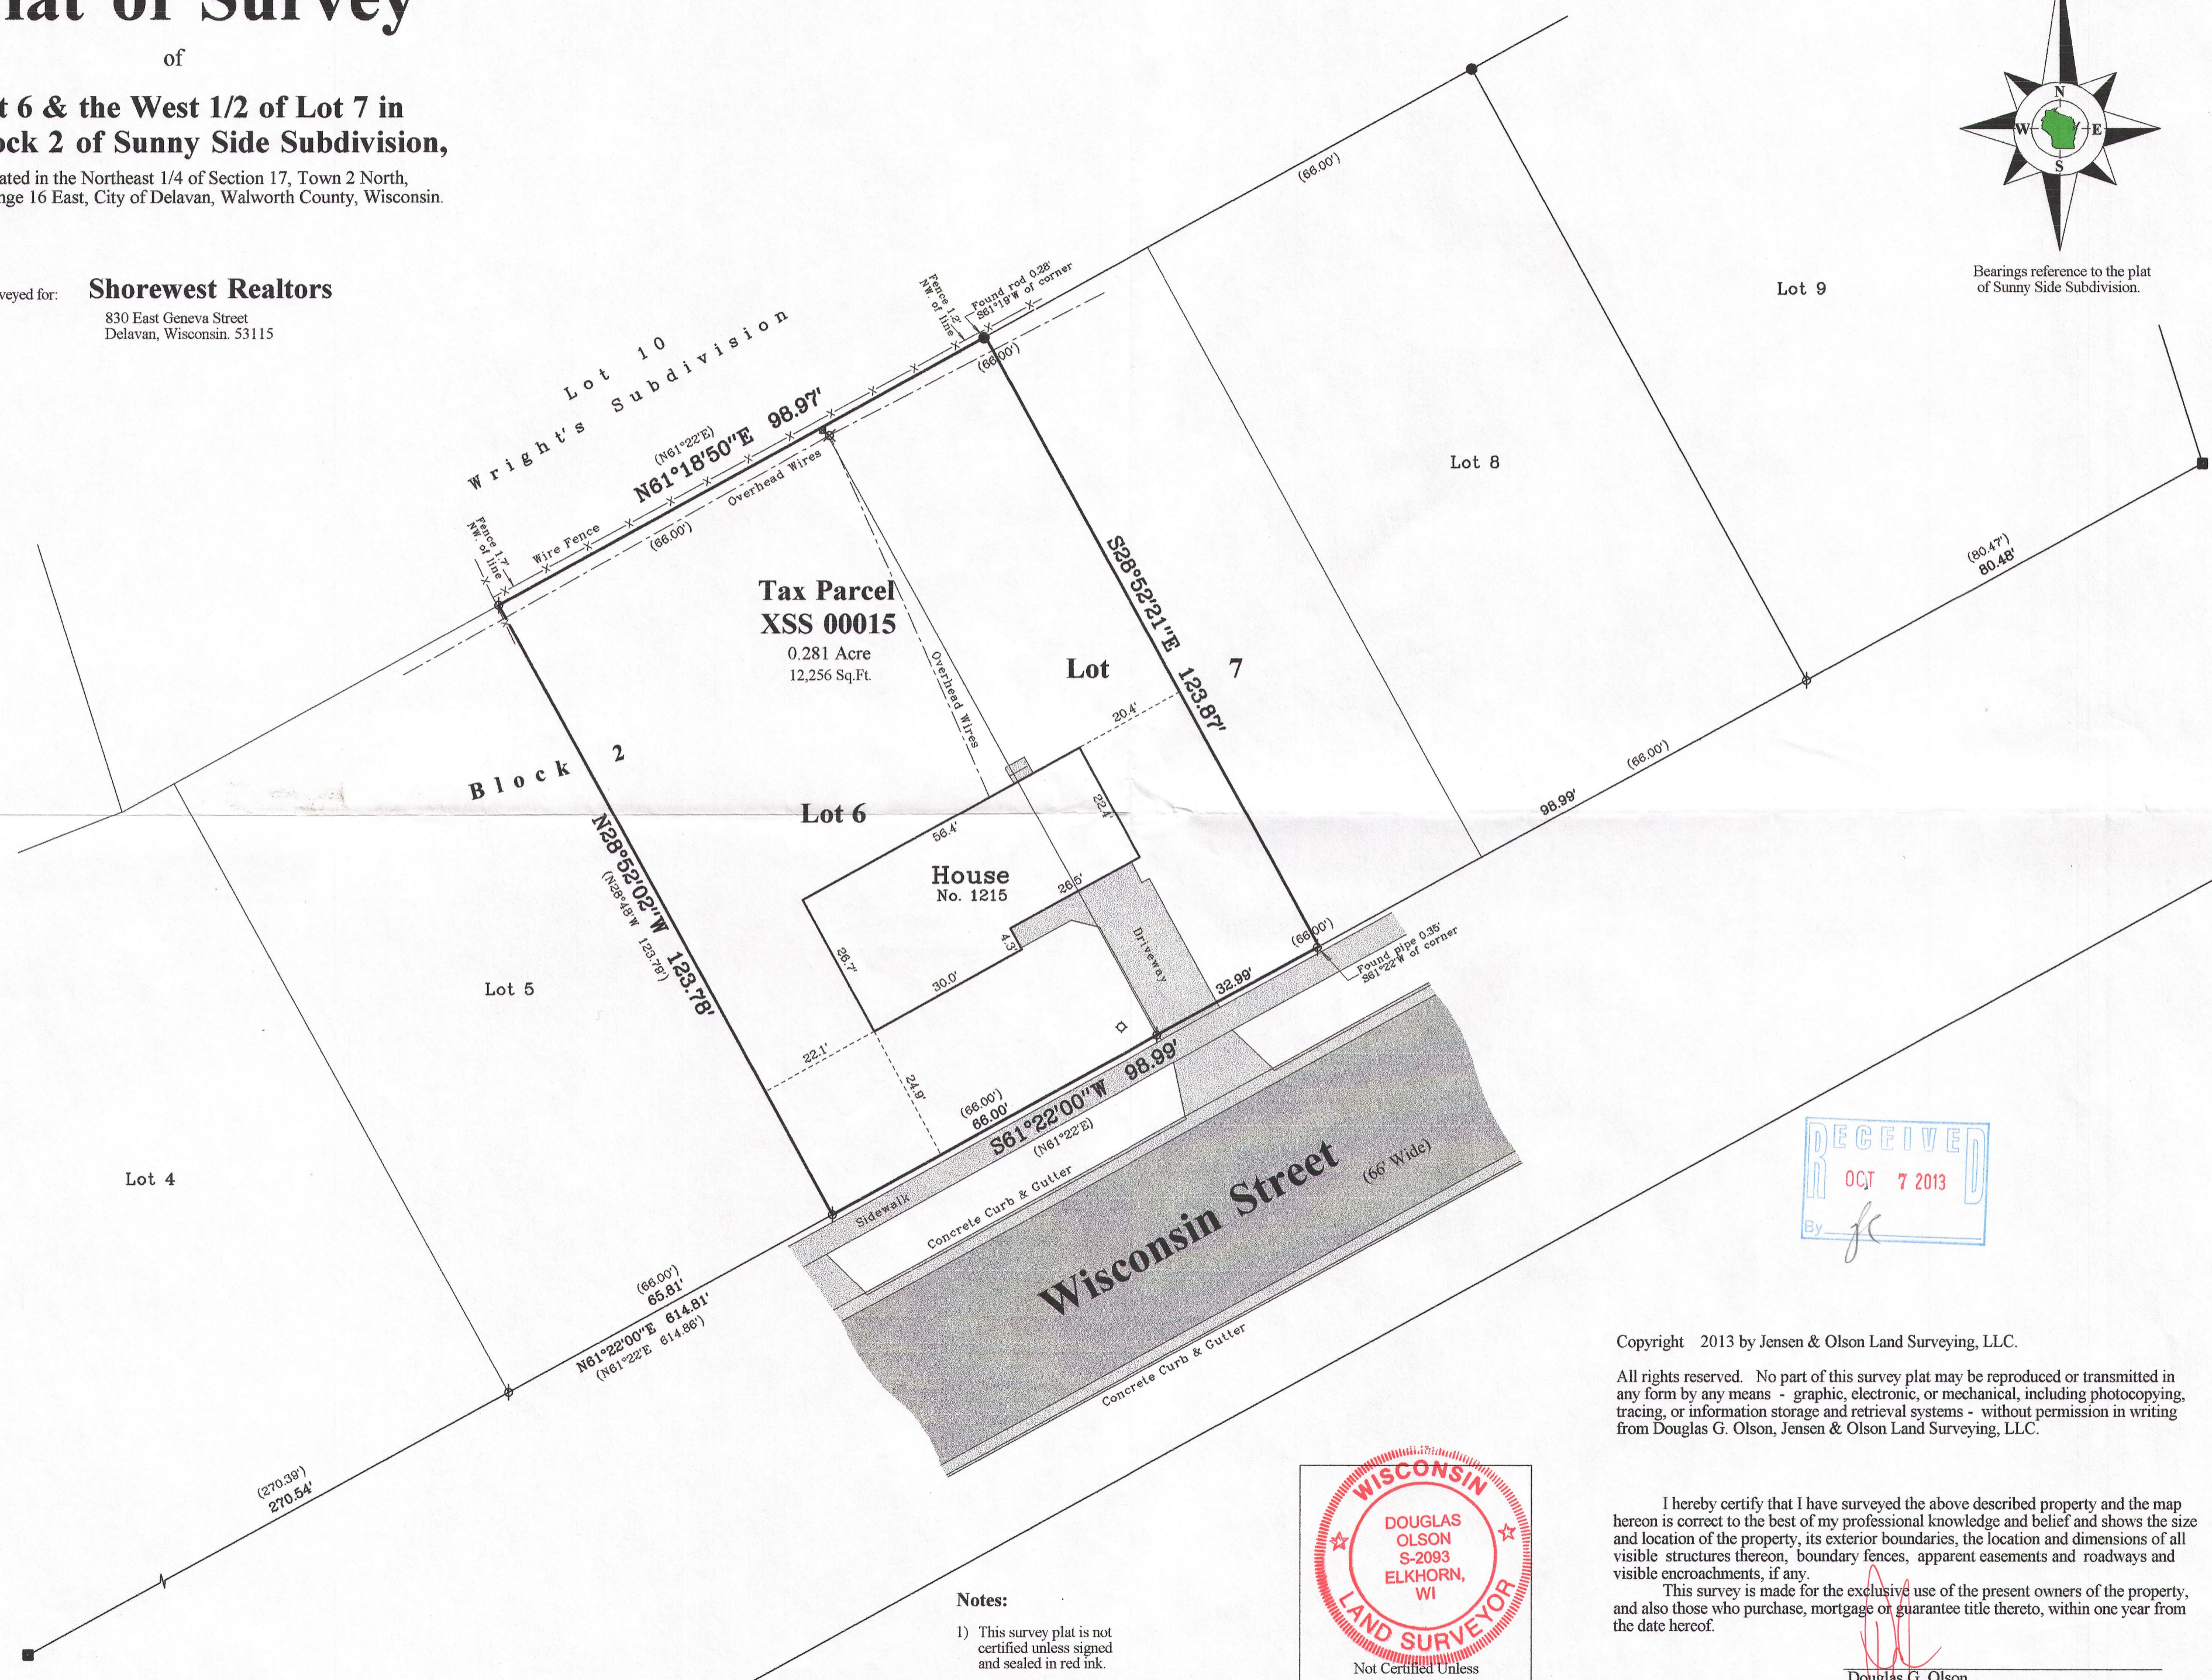

Survey Date: June 16, 2013.
 Revisions:

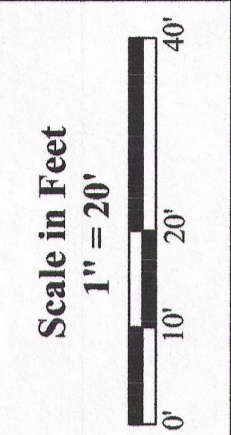

Jensen & Olson Land Surveying, LLC
 45 South Wisconsin Street * P.O. Box 322 * Elkhorn, Wisconsin. 53121
 Telephone: (262) 723-3434 * Facsimile: (262) 723-8044
 Email: jensen.olson@elknet.net

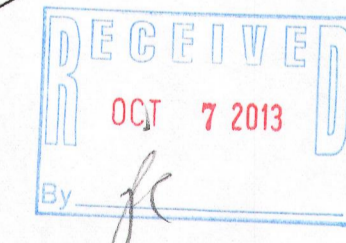


Copyright 2013 by Jensen & Olson Land Surveying, LLC.

All rights reserved. No part of this survey plat may be reproduced or transmitted in any form by any means - graphic, electronic, or mechanical, including photocopying, tracing, or information storage and retrieval systems - without permission in writing from Douglas G. Olson, Jensen & Olson Land Surveying, LLC.

I hereby certify that I have surveyed the above described property and the map hereon is correct to the best of my professional knowledge and belief and shows the size and location of the property, its exterior boundaries, the location and dimensions of all visible structures thereon, boundary fences, apparent easements and roadways and visible encroachments, if any.
 This survey is made for the exclusive use of the present owners of the property, and also those who purchase, mortgage or guarantee title thereto, within one year from the date hereof.

Douglas G. Olson
 Wisconsin Registered Land Surveyor - 2093

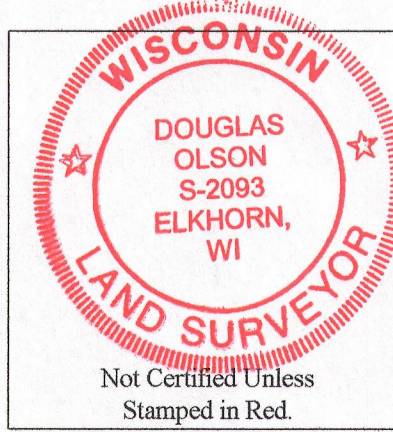

- Notes:**
- 1) This survey plat is not certified unless signed and sealed in red ink.
 - 2) This survey is subject to Wisconsin lien laws. This Plat of Survey is the notice of intent to file lien. Lien waiver required.

- Legend**
- Found Concrete Monument
 - Found Iron Pipe
 - Found Iron Rod
 - Found Tag Information
 - Utility Pole
 - Utility Pedestal
 - Asphalt Surface
 - Concrete Surface

Sheet 1 of 1 Sheets
 Job Reference Number
2013.060

2013.060

002-2536